

INFORMATION
THIS DOCUMENT IS
SUBJECT TO REVISION
WITHOUT NOTIFICATION
TO THE USER OR THIS
COPY

TERA
APERTURE
CARD


UNIT: 1 AND 2
STATUS: APPROVED
CERTIFICATION LETTER NO. ST-WN-DR-1576
AUTHORITY: A. T. PARKER
CNSC 178, NR. EP/SA-28076

VOLUME CONTROL
TANK LIQUID LEVELS

1	2
TCX/THX-320 8944330/3.5	TCX/THX-320
CHANG	ECN-30019
REVISIONS CIRCLED	REVISIONS CIRCLED
W. H. G. 7-49-76	W. H. G. 7-49-76
TCX/THX-320	ECN-31235
REVISIONS CIRCLED	REVISIONS CIRCLED
MIGARS 6-30-78	MIGARS 6-30-78
6/19/79	6/19/79
6/19/79	6/19/79
6/19/79	6/19/79

NOTES:
(SEE SH. 1 FOR GENERAL NOTES AND REFERENCES)
1. COMPARTOR DEAD BAND USED FOR RANGE
2. COMPARTOR LB 112A AND LB 113B PROVIDE REDUNDANT CONTROL FOR START REFUELING WATER SEQUENCE.

DESIGNED BY	ME HABERMAN	DATE	11-76
CHECKED BY	[Signature]	DATE	11-76
APP. BY	[Signature]	DATE	11-76
SCALE	AS SHOWN	SHEET	8758076
DIMENSIONS IN INCHES	DO NOT SCALE		

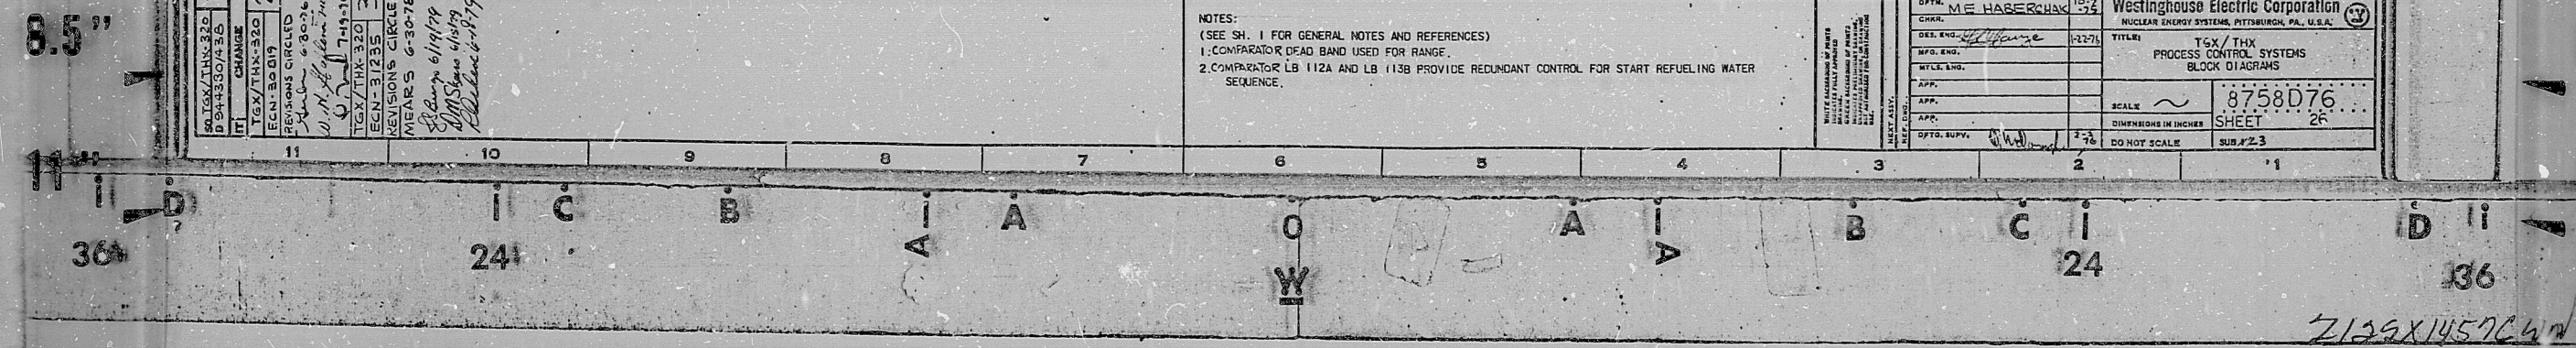

2129X145764

RIDS

8112089078

