


DUTOL

XSAT - EL 65'-10"	SDAI - EL 62'-5"	SDAR - W	XSOU - EL 62'-5"
XXAI - 64'-6"	SDAI - W	SDAZ - W	XYKI - W
XXAI - 65'-2"	SDAI - W	SDAZ - W	XYKI - W
	SDAI - W	SDAZ - W	XYKI - W
	SDAI - W	SDAZ - W	XYKI - W

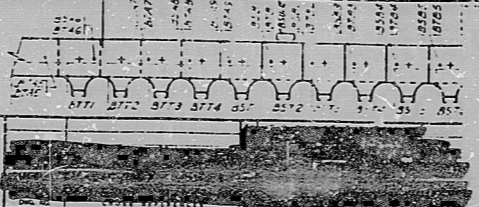


INTERIM DRAWING CHANGE NOTICE (IDCN)  
 SUPPLEMENTAL PAGE  
**AFTER**

DOCUMENT NO	SHEET NO	DCN NO	DATE	DCN CORR	QUALITY
35482	29				II

PROJECT NO 15692 PAGE 4 OF 4 PAGE  
 DATE 8-12-85 BY M. PREGA

QUAL. C. REC. II  
 UNIT I  
 SAN ONOPE RUPREAN GENERATING STATION  
 AREA GAS CONDUIT & TRAY PLAN  
 ELEVATION 50' TO 70'-0"  
 SOUTHERN CALIFORNIA Edison COMPANY  
 1000 J. STREET  
 SAN DIEGO, CALIF. 92161

DCR24304.0J REV 0 SHEET 140 OF 199

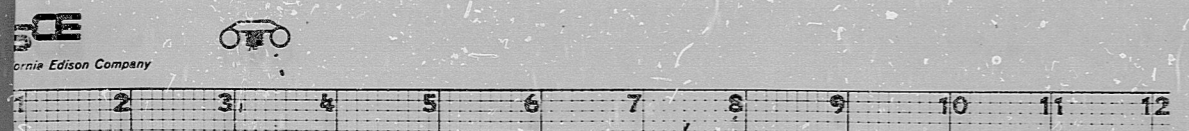

17X

SI APERTURE CARD  
 MICROFILMED FROM BEST AVAILABLE COPY

8811290283

PDR RIDS

8811290283

