
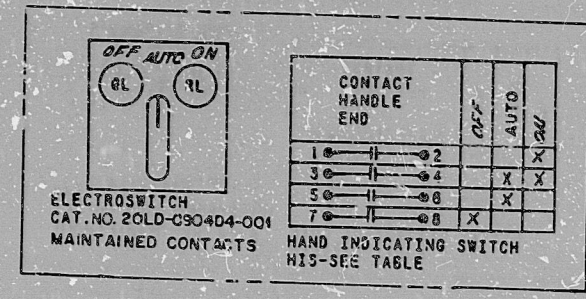


This drawing and the design it covers is the property of the Utilities which are participating in the SNUPPS Project. It is loaned on the borrower's express agreement that it will not be reproduced, copied, loaned, exhibited, or used except in the limited way and private use permitted by written consent given by the SNUPPS Utilities to the borrower.

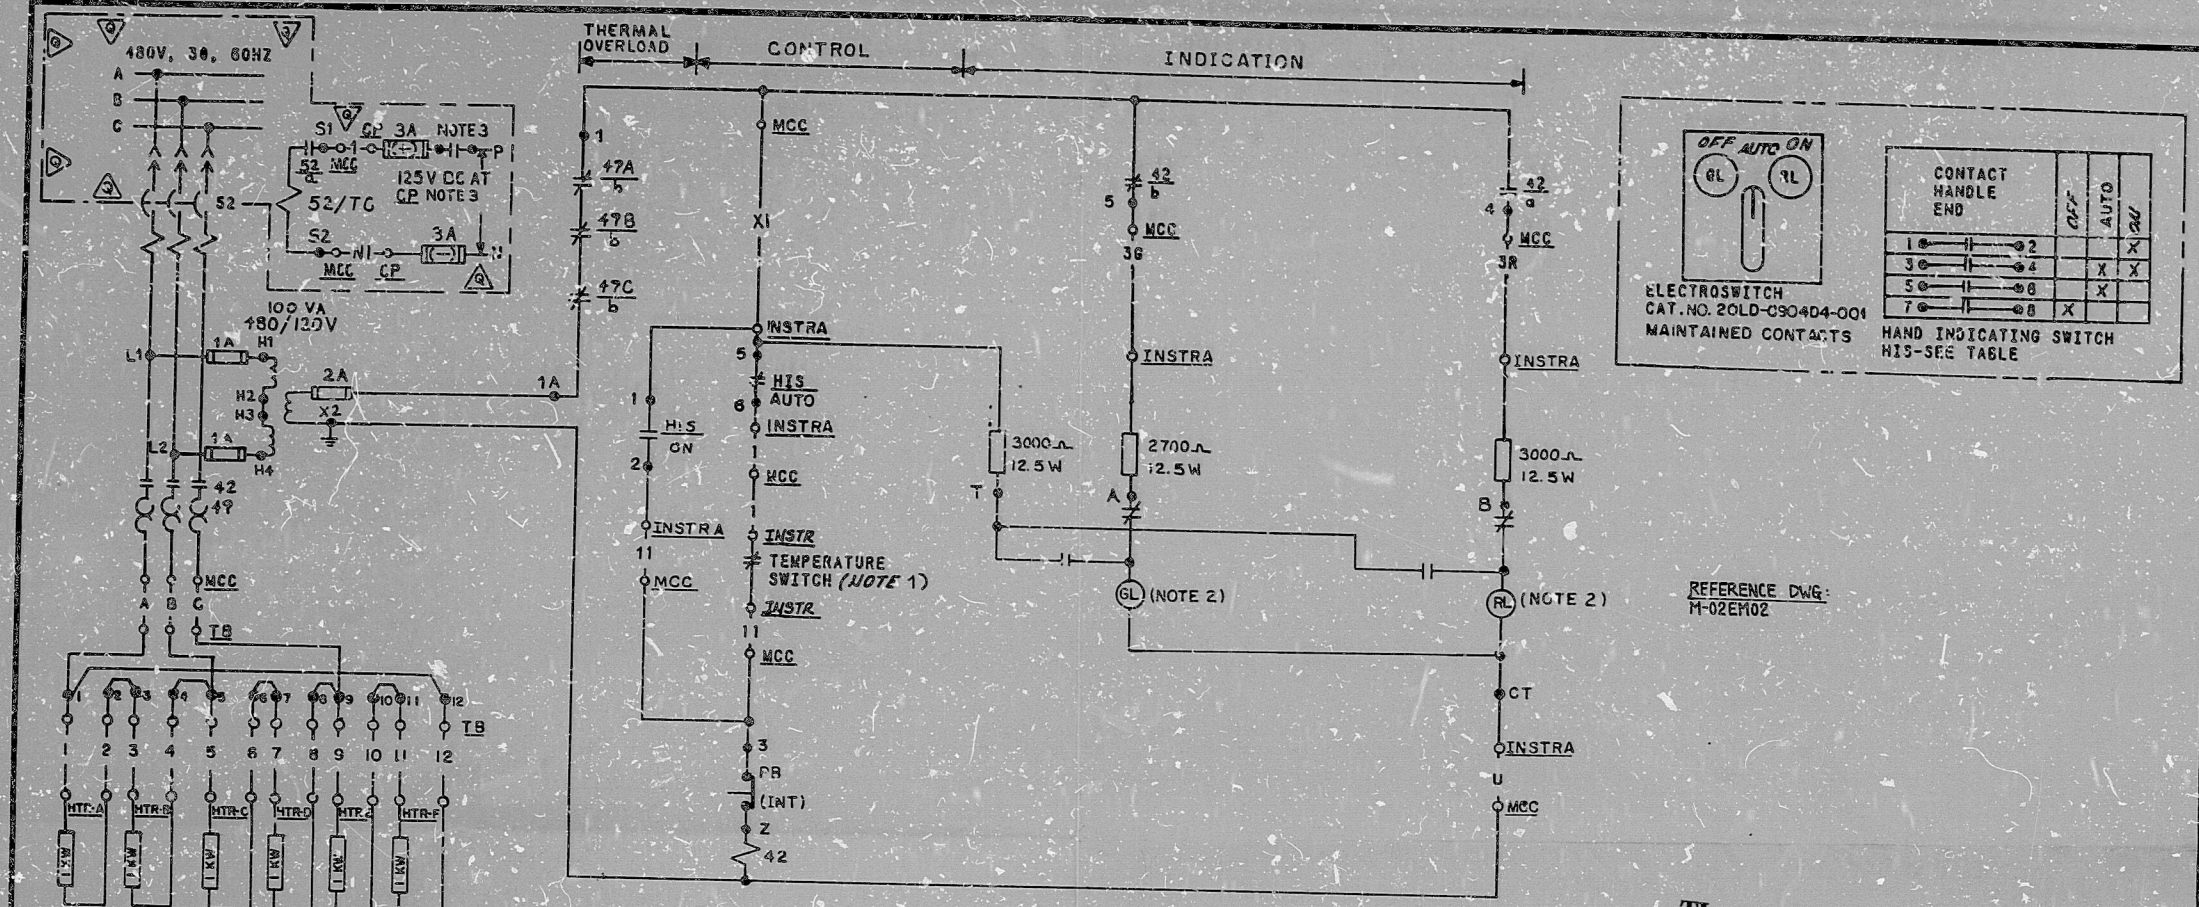

REFERENCE DWG: M-02EM02


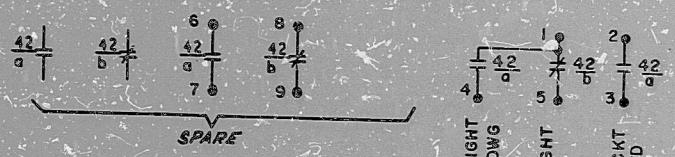


TABLE A

| | | |
|----------------------|----------|----------|
| HTR-F LOC. | EMO1AF | EMO1BF |
| HTR-E LOC. | EMO1AE | EMO1BE |
| HTR-D LOC. | EMO1AD | EMO1BD |
| HTR-C LOC. | EMO1AC | EMO1BC |
| HTR-B LOC. | EMO1AB | EMO1BB |
| HTR-A LOC. | EMO1AA | EMO1BA |
| TB NO. - TB | TB1102 | TB1103 |
| TEMP SW LOC. - INSTR | EMH1394 | EMH1395 |
| MCC LOCATION - MCC | NG01BJF3 | NG04CPFI |
| HIS NO. - INSTR | EMH1394 | EMH1395 |
| HTR NO. - HTR | EMO1A | EMO1B |
| SCHEME NO. | SEM007A | SEM007B |

TABLE B

| | | |
|------------------------|-----------|-----------|
| RELAY & CONTACT NO. | K1163 4-5 | K4163 4-5 |
| CONT PNL LOCATION - CP | NF039C | NF039C |
| MCC LOCATION - MCC | NG01BJF3 | NG04CPFI |
| SCHEME NO. | IEMK07A | 4EMK07B |

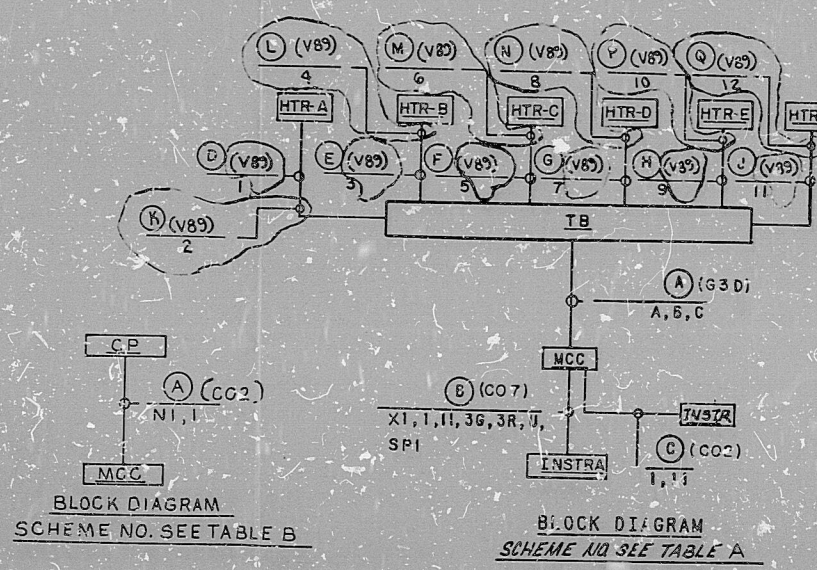

TI APERTURE CARD

- TEMPERATURE SWITCH OPENS ON HIGH TEMPERATURE AND CLOSES ON LOW TEMPERATURE.
- PUSHING IN ON LIGHT FOR LAMP TEST REVERSES CONTACT POSITIONS.
- CONTACT CLOSING ON SAFETY INJECTION SIGNAL. FOR DETAILS, SEE BECTEL V.P. NO. J104-0147. RELAY & CONTACT NO. SEE TABLE B.

NOTES:

| NO. | DATE | REVISION | BY | CHKD | DESIGN | ENG | PRJ | ERR |
|-----|------|----------|----|------|--------|-----|-----|-----|
| 1 | | | | | | | | |
| 2 | | | | | | | | |

BECTEL
GAITHERSBURG, MARYLAND

SNUPPS

SCHEMATIC DIAGRAM
BORON INJECTION TANK
HEATERS

STABILITY DRAWING NO. Rev

JOB NO. 10480

BECTEL DRAWING NO. E-03EM07A (C)

REV. 2

REVIEW LEVEL 3

I certify that the image contained on this frame was made in the normal and regular course of business, on the date stated below and that it is an accurate reproduction of the document(s) submitted to Micrographics.
DATE 7/12/83 OPERATOR Mark Leonard SUPERVISOR [Signature]

8410050486

PDR RIDS

