


This drawing and the design it covers is the property of the utilities which are participating in the SNUPPS Project. It is loaned on the borrower's express agreement that it will not be reproduced, copied, loaned, exhibited, or used except in the limited way and private use permitted by written consent given by the SNUPPS utilities to the borrower.

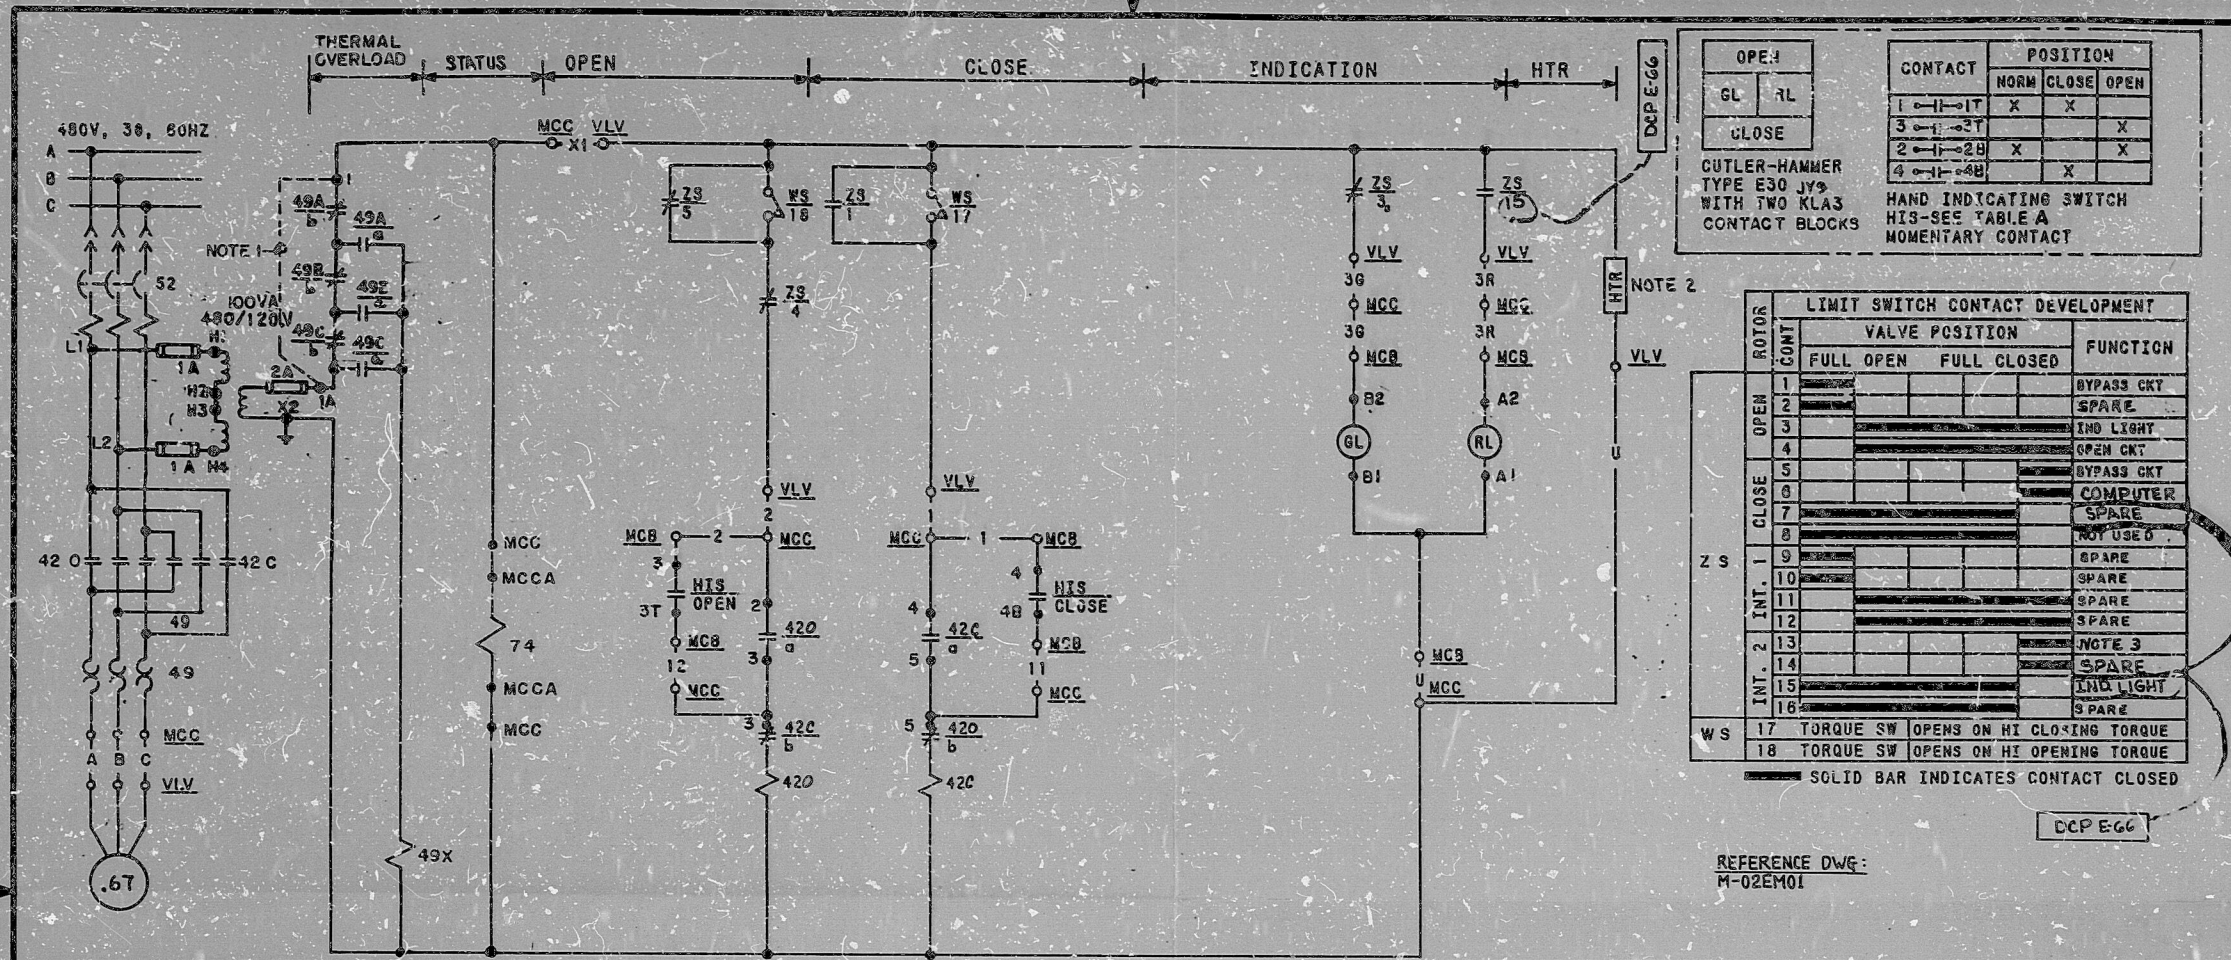

OPER.		CONTACT		POSITION	
GL	RL	NORM	CLOSE	OPEN	
		1-1-1T	X	X	
		3-1-2T			X
		2-1-2B	X		X
		4-1-4B		X	


CUTLER-HAMMER TYPE E30 JY'S WITH TWO KLA3 CONTACT BLOCKS

HAND INDICATING SWITCH HIS-SEE TABLE A MOMENTARY CONTACT

LIMIT SWITCH CONTACT DEVELOPMENT				
ROTOR	CONT.	VALVE POSITION		FUNCTION
		FULL OPEN	FULL CLOSED	
OPEN	1			BYPASS CKT
	2			SPARE
	3			IND LIGHT
	4			OPEN CKT
CLOSE	5			BYPASS CKT
	6			COMPUTER
	7			SPARE
	8			NOT USED
Z S	9			SPARE
	10			SPARE
	11			SPARE
	12			SPARE
	13			NOTE 3
	14			SPARE
	15			IND LIGHT
	16			SPARE
W S	17			TORQUE SW OPENS ON HI CLOSING TORQUE
	18			TORQUE SW OPENS ON HI OPENING TORQUE

SOLID BAR INDICATES CONTACT CLOSED

REFERENCE DWG: M-02EM01

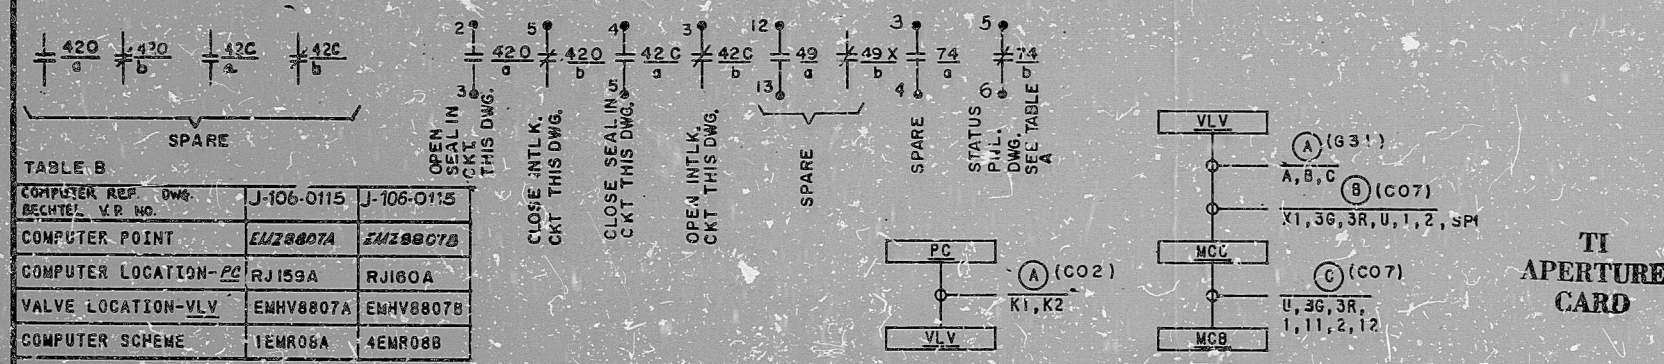

COMPUTER REF. DWG.	J-106-0115	J-106-0115
BECHTEL V.R. NO.		
COMPUTER POINT	EMV8807A	EMV8807B
COMPUTER LOCATION-PC	RJ159A	RJ160A
VALVE LOCATION-VLV	EMHV8807A	EMHV8807B
COMPUTER SCHEME	1EMR06A	4EMR08B

74A STATUS WLDWG	E-03SA06	E-03SA09
MCC LOC-MCCA	NG01ADF1	NG02AEF1
HIS NUMBER	EMHIS8807A	EMHIS8807B
MCC LOCATION-MCC	NG01AAR4	NG02ABR5
HIS LOCATION-MCB	RL017	RL017
VALVE NO.-VLV	EMHV8807A	EMHV8807B
SCHEME NO.	1EMR06A	4EMR08B

PLANT COMPUTER BLOCK DIAGRAM  
 SCHEME NO. SEE TABLE A

- 3 TO STATUS PANEL, SEE DWG. E-03SA04
- HEATER 40 WATTS, MANUFACTURE TYPE WARD LEONARD P/N 40S OR EQUAL.
- JUMPER TO BE INSTALLED PRIOR TO CORE LOADING.

NO.	DATE	REVISIONS	BY	CHK	DESIGN	APP	PROJ	DATE
1	7/21	REVISED MOTOR H.P.						
2	7/22	REVISED LIMIT SW. CONTACT DEV. TO INC. DCP E-66						
3	8/13	REVISED LIMIT SWITCH CONTACT DEV. TO INC. DCP E-66						

BECHTEL  
 GAITHERSBURG, MARYLAND

SNUPPS

SCHEMATIC DIAGRAM  
 SUCTION HEADER  
 CROSS CONNECTION

UTILITY DRAWING NO.	REV	
JOB NO.	BECHTEL DRAWING NO.	REV
10488	E-03EM08 (Q)	5

DRAWING APPLICABLE TO SHEETS: 1 2 3 4 5 6 7 8 9

I certify that the image contained on this frame was made in the normal and regular course of business, on the date stated below and that it is an accurate reproduction of the document(s) submitted to Micrographics.  
 DATE 5-7-83 OPERATOR *Barbara Lewis* SUPERVISOR *William J. Reed*

16X

Dupe of

8410050502

APDR RIDS

