


THIS DRAWING IS PART OF DCP NO. 2-6324.07
 DATE: 10-8-85
 DRAWN BY: [Signature]
 CHECKED BY: [Signature]
 APPROVED BY: [Signature]
 TITLE: [Blank]
 PROJECT: [Blank]

This revised Vendor Document incorporates
 Changes indicated with a Design Change Package
 DCP Number: 2-6324.05
 This Vendor Document revision does not reflect
 any physical plant modification and is not consistent
 with a DCP or PCR.
 Explains change: [Signature]
 PP-4183 (10/8/85)

SCE #4171
 S023-502-2-389-0

DECHTEL POWER CORPORATION ENGINEERS & CONSTRUCTORS LOS ANGELES, CALIF.													I.G. NO. SAN ONOFRE NUCLEAR GENERATING STATION	
JOB NO. 15692-1A85 DATE APPROVED													FILE MISC. PANELS. 2L-621 WIRING DIAGRAM.	
NO. 0 REVISIONS DATE 9/6/85 DR. GOMEZ CHK. [Signature] E.G.S. [Signature] CH.F.E. [Signature] P.E. [Signature] Q.A.E. [Signature]													SOUTHERN CALIFORNIA EDISON COMPANY SCALE NONE LOS ANGELES, CALIF.	
P098 CM 1420													DRAWING No. 39314 REV. 0	

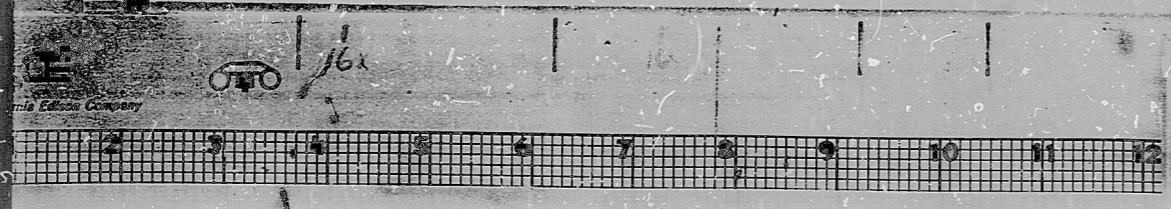

17X

MICROFILMED FROM BEST AVAILABLE COPY
 8811290325

PDR RIDS

88 1 1 2 9 0 3 2 5

