

11

11

9.8

8.5

11

17

11


11

9.8

8.5


11

17

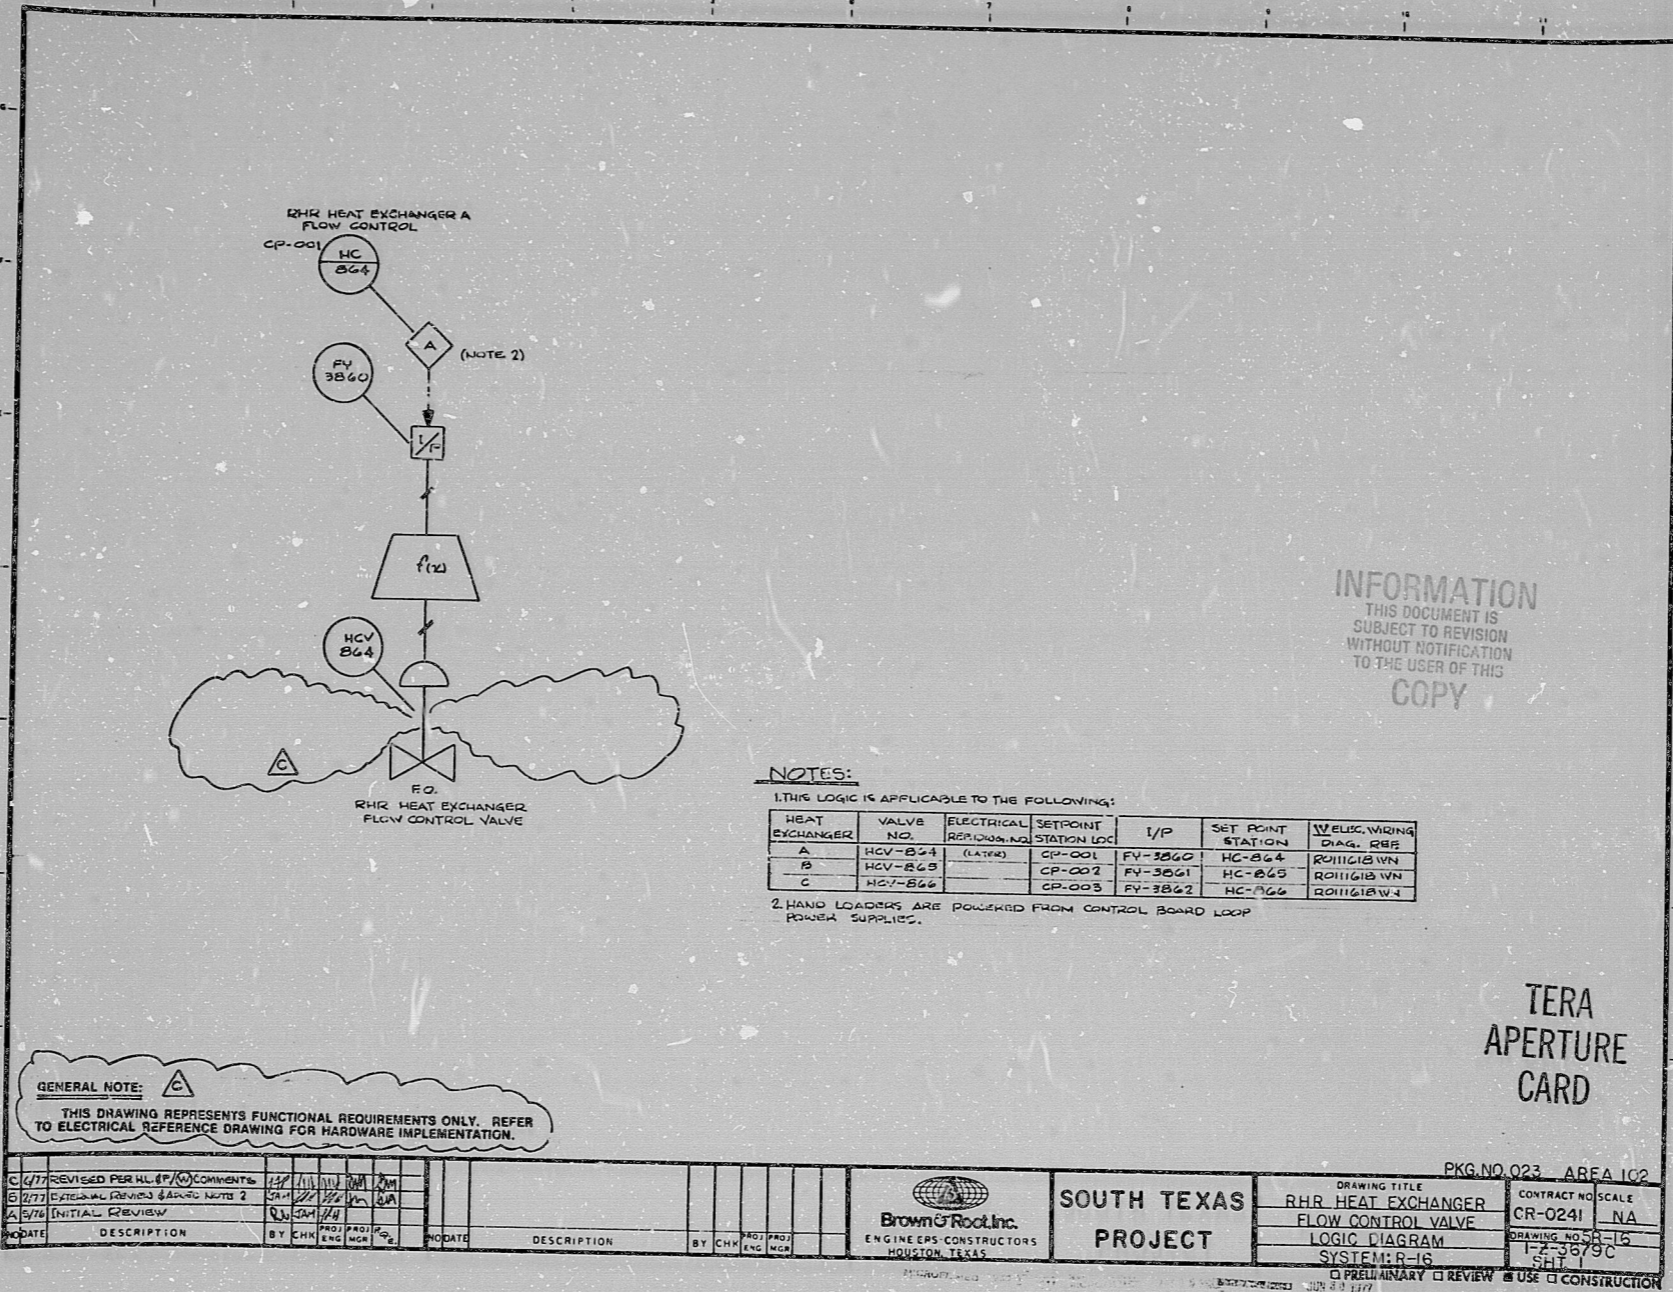

BROWN & ROOT INC.  
MICROFILM SERVICES

THURSDAY, JUNE 50

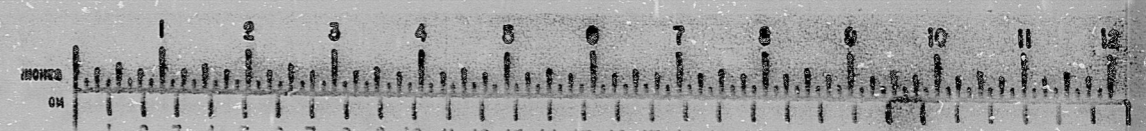



KIDS

8112080144

