


11
8.5
8.5
11
17

11
8.5
8.5
11
17

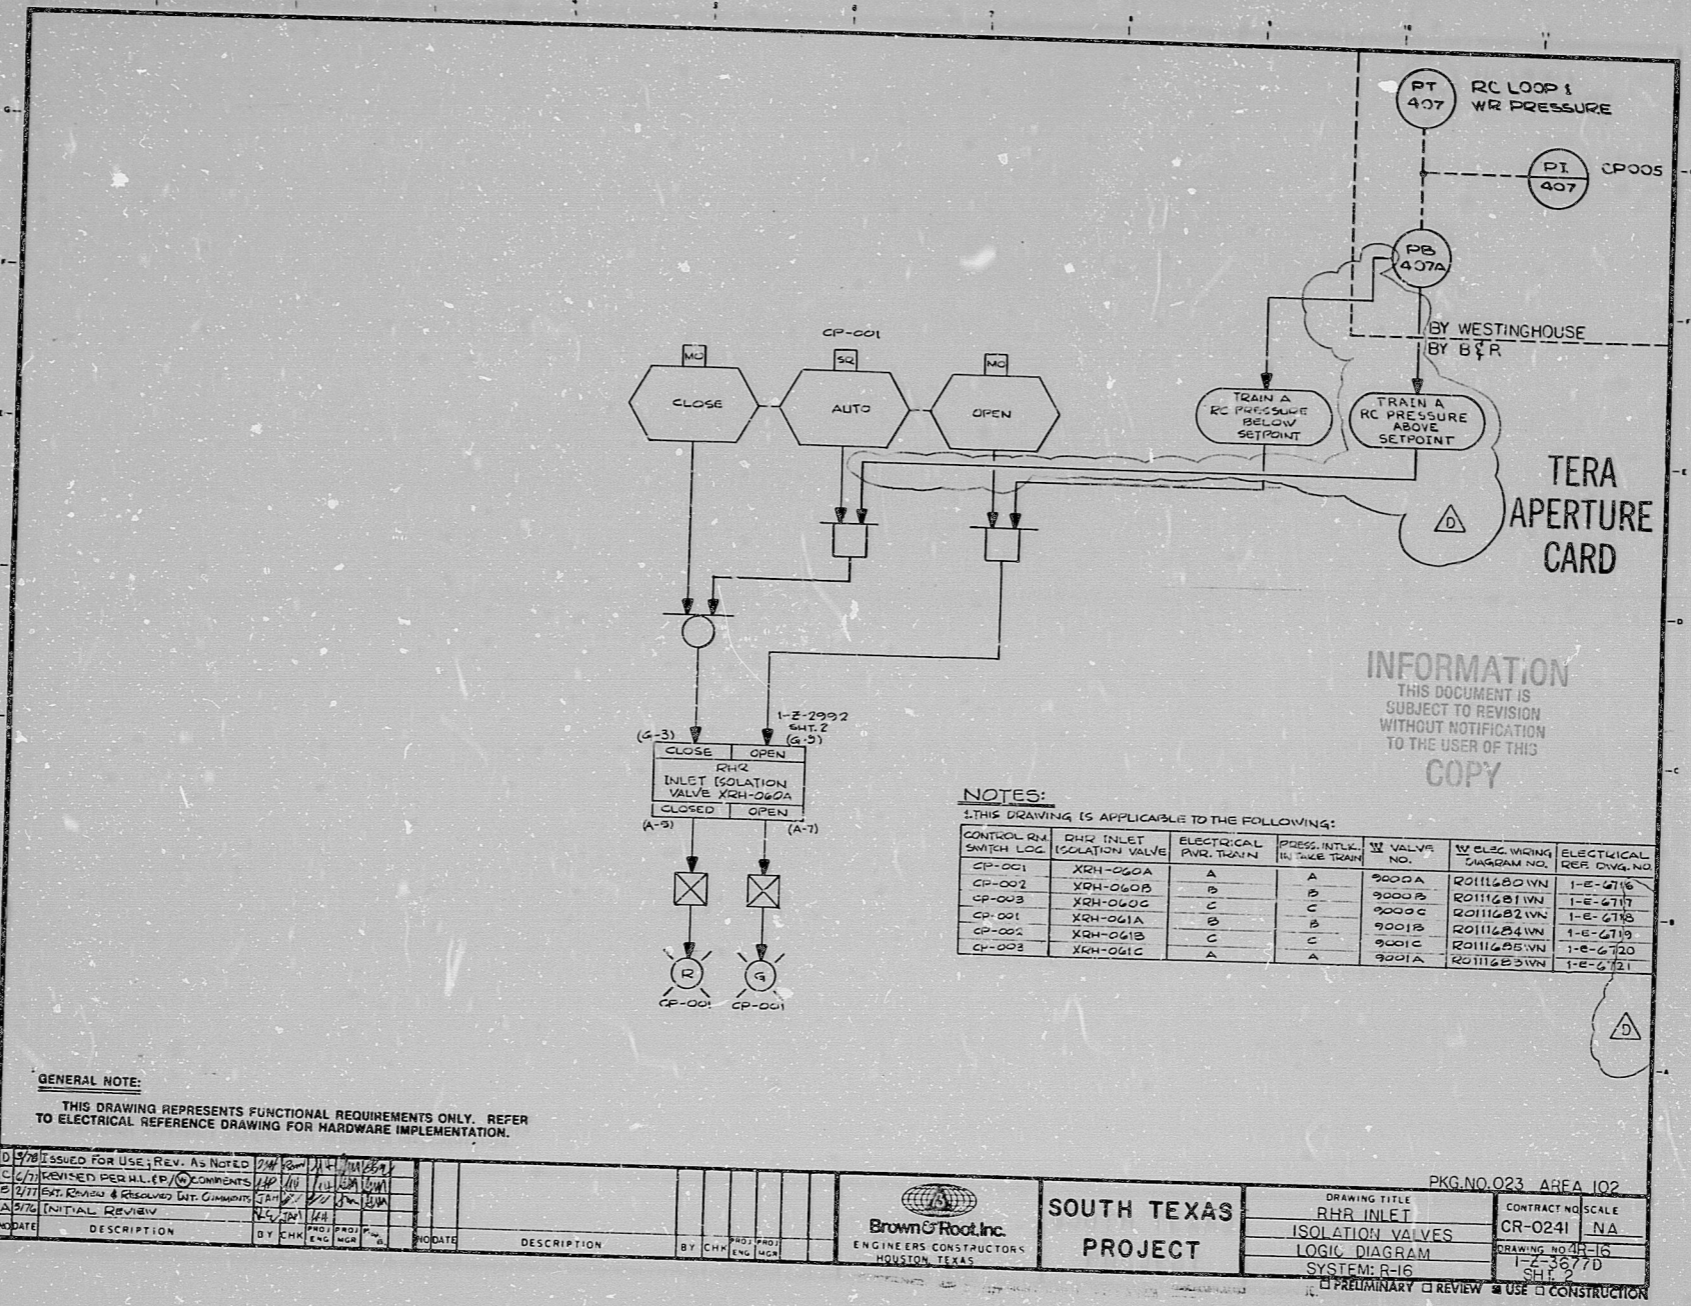

PKG. NO. 023 AREA 102

Brown & Root Inc.
ENGINEERS CONSTRUCTORS
HOUSTON, TEXAS

SOUTH TEXAS PROJECT


DRAWING TITLE: RHR INLET ISOLATION VALVES LOGIC DIAGRAM SYSTEM: R-16

CONTRACT NO. SCALE: CR-0241 NA

DRAWING NO. SHEET: 1-23877D SHEET 2

PRELIMINARY REVIEW USE CONSTRUCTION

BROWN & ROOT INC.
MICROFILM SERVICES
THURSDAY, MAR. 30 1978

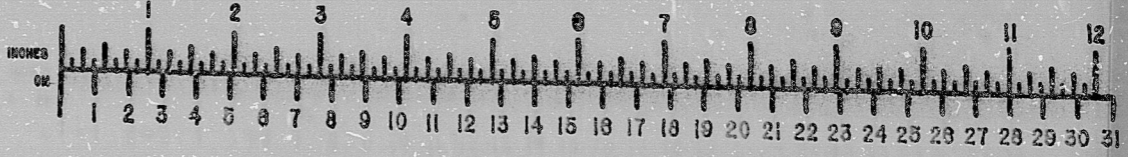

RIDS

812080155

