

17"

11"

8.5"

8.5"

11"

17"

17"


11"

8.5"

8.5"

11"

17"

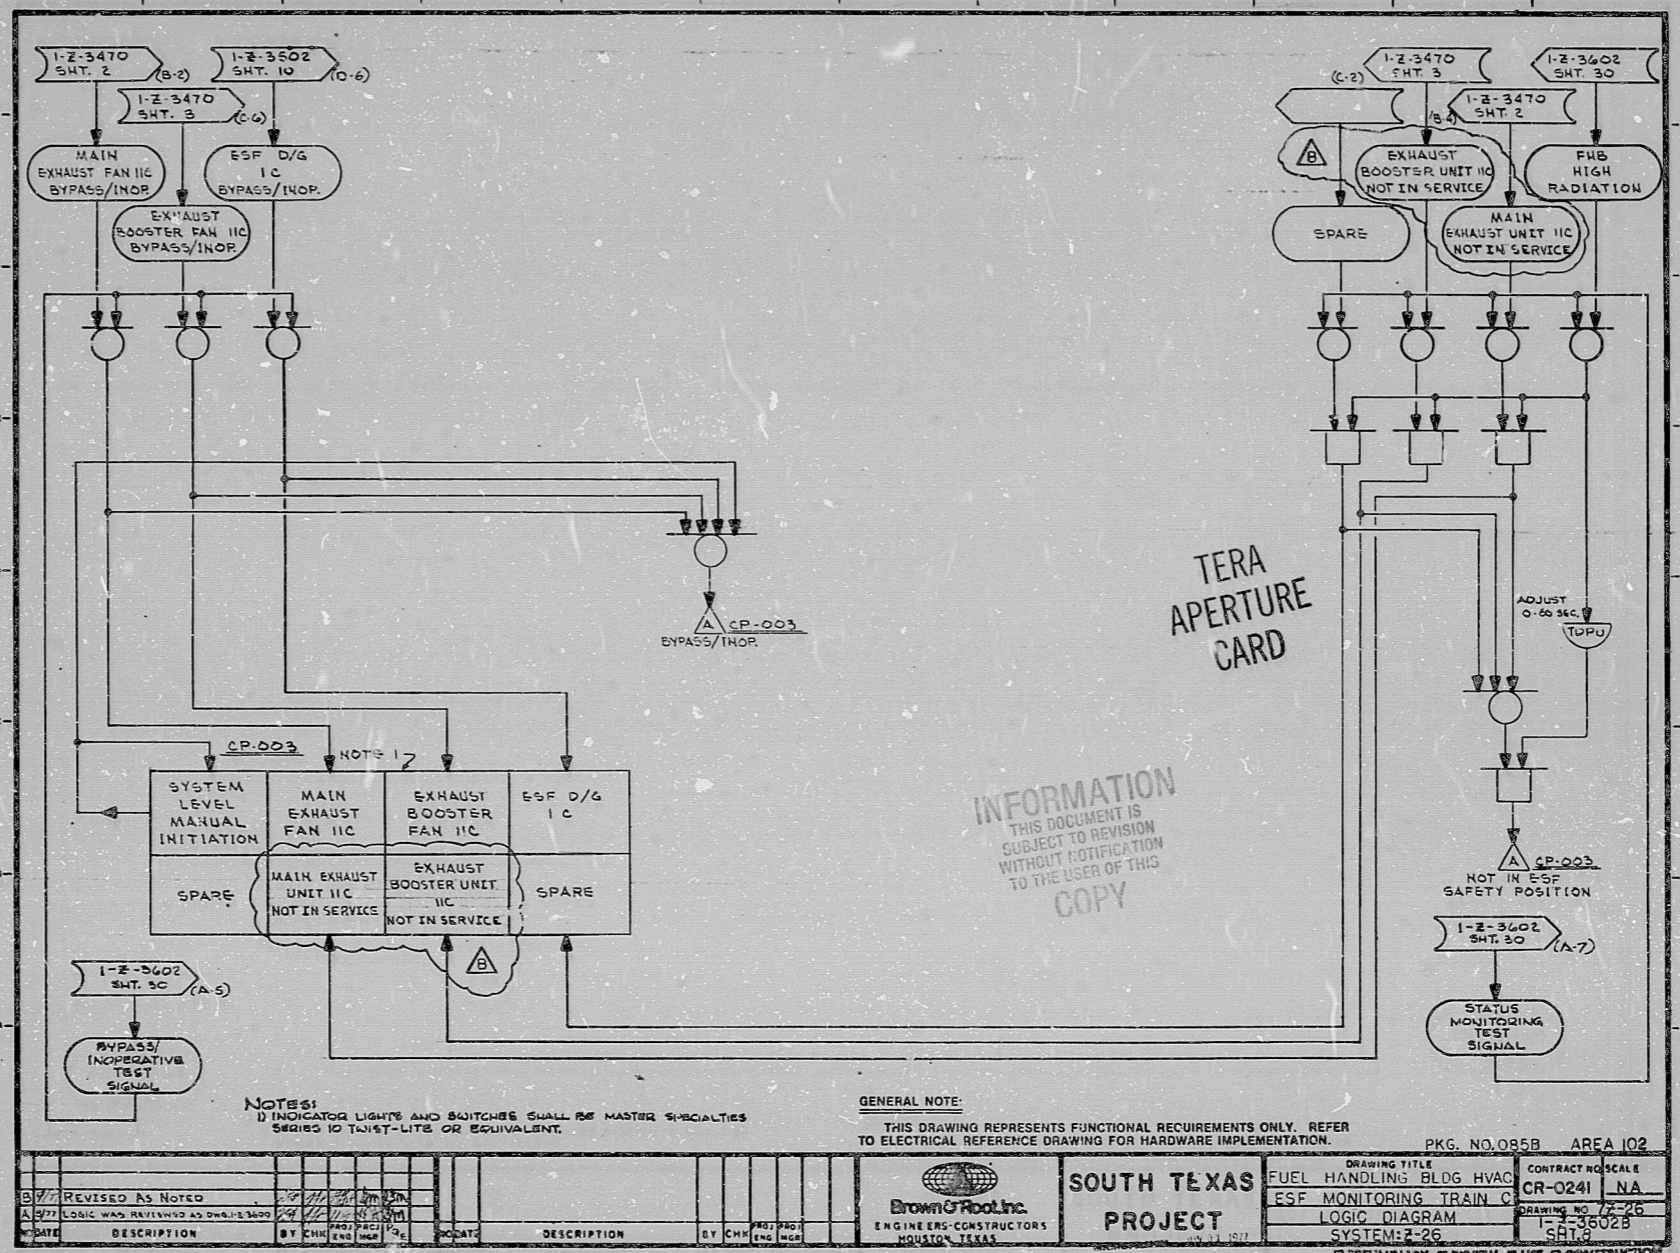

BROWN & ROOT INC.
MICROFILM SERVICES

THURSDAY, SEPT. 22 1977



RIDS

812080186

