

17"

11"

8.5"

8.5"

11"

17"

17"


11"

8.5"

8.5"

11"

17"

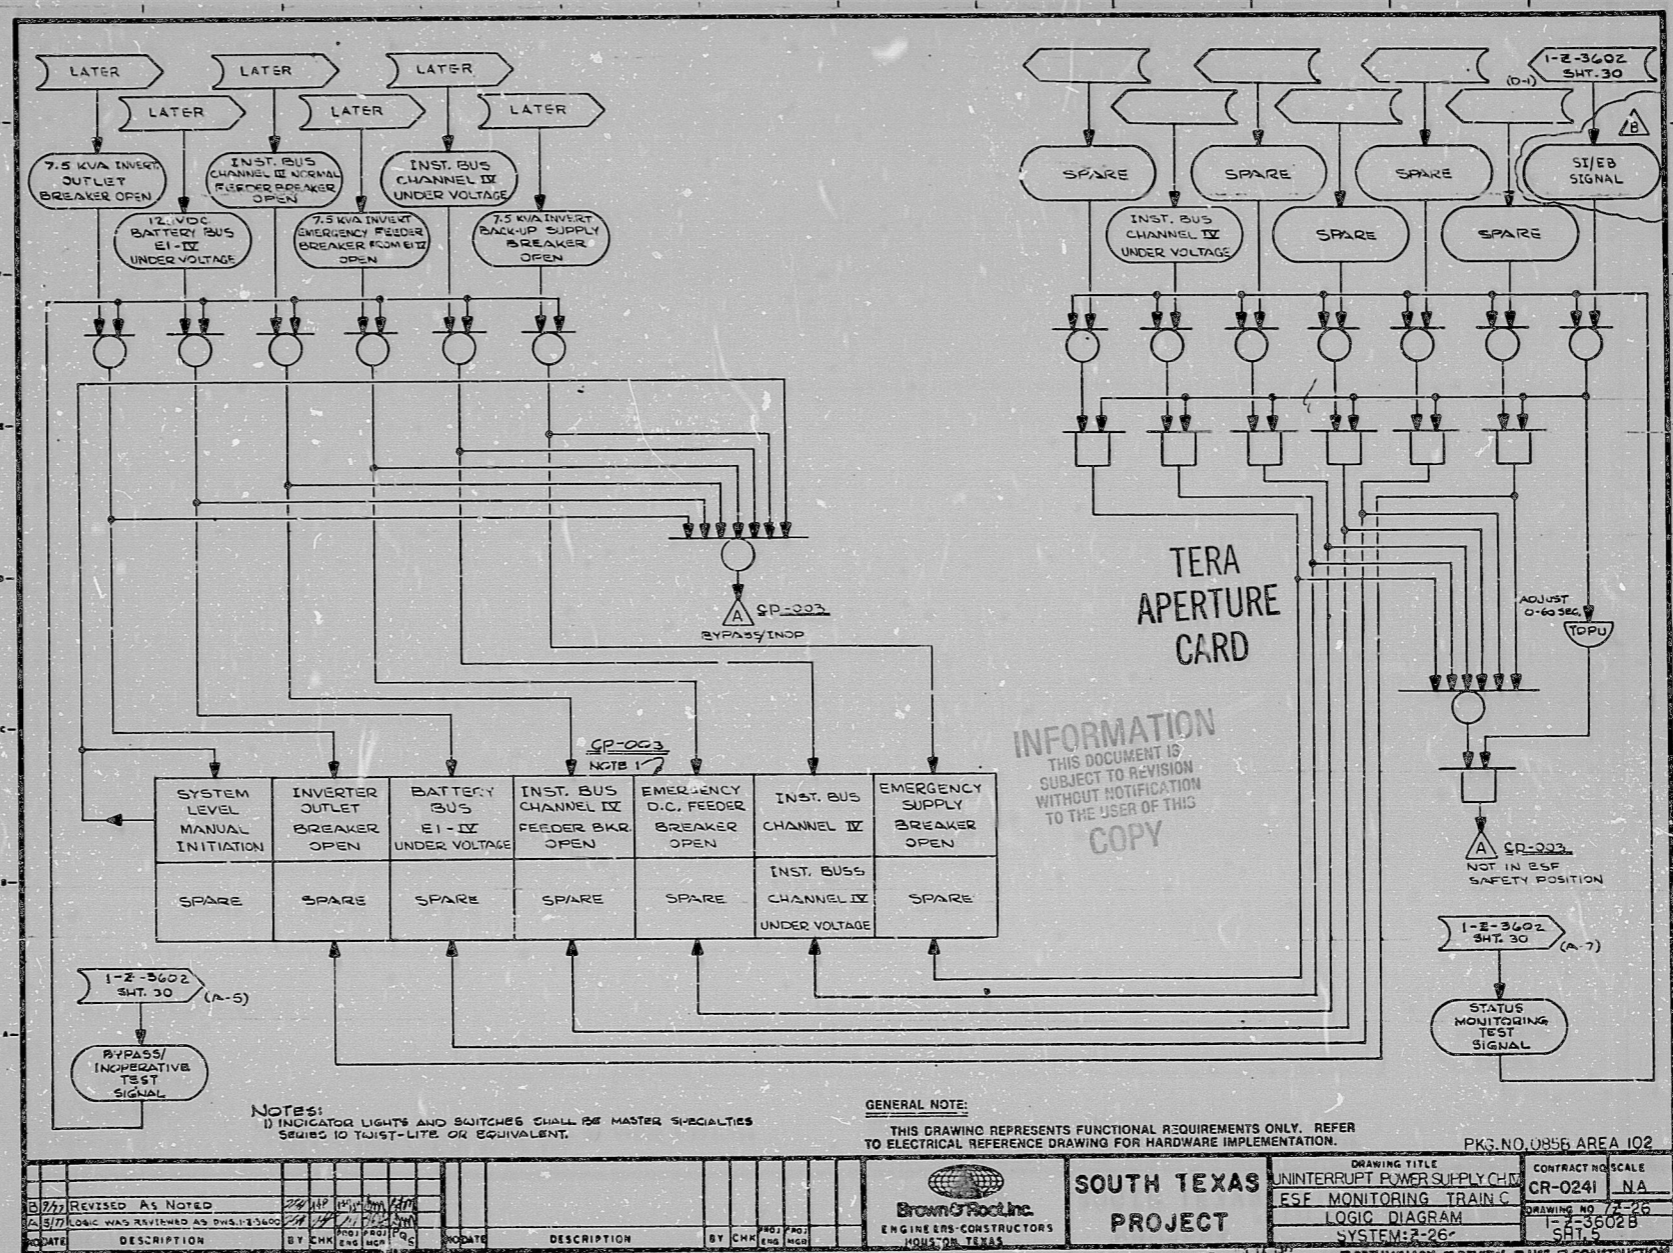

INFORMATION
THIS DOCUMENT IS
SUBJECT TO REVISION
WITHOUT NOTIFICATION
TO THE USER OF THIS
COPY

DATE	DESCRIPTION	BY	CHK	PROJ	NO	DATE	DESCRIPTION	BY	CHK	PROJ	NO
5/77	REVISED AS NOTED	HP	HP								
6/77	LOGIC WAS REVISED AS SHOWN	HP	HP								

SOUTH TEXAS PROJECT		DRAWING TITLE	UNINTERRUPTIBLE POWER SUPPLY CH. ESF MONITORING TRAIN C LOGIC DIAGRAM
Brown & Root Inc. ENGINEERS-CONSTRUCTORS HOUSTON, TEXAS		CONTRACT NO.	CR-0241 NA
		SCALE	AS SHOWN
		DRAWING NO.	1-3502B
		SHT. NO.	1 SHT. 5
		PK3. NO. 0356 AREA 102	
		DATE	SEP 23 1977

BROWN & ROOT INC.
MICROFILM SERVICES

THURSDAY, SEPT. 23 1977



RIDS

8112080189

