


11
8.5"
11"
8.5"
11"
17"

11
8.5"
11"
8.5"
11"
17"

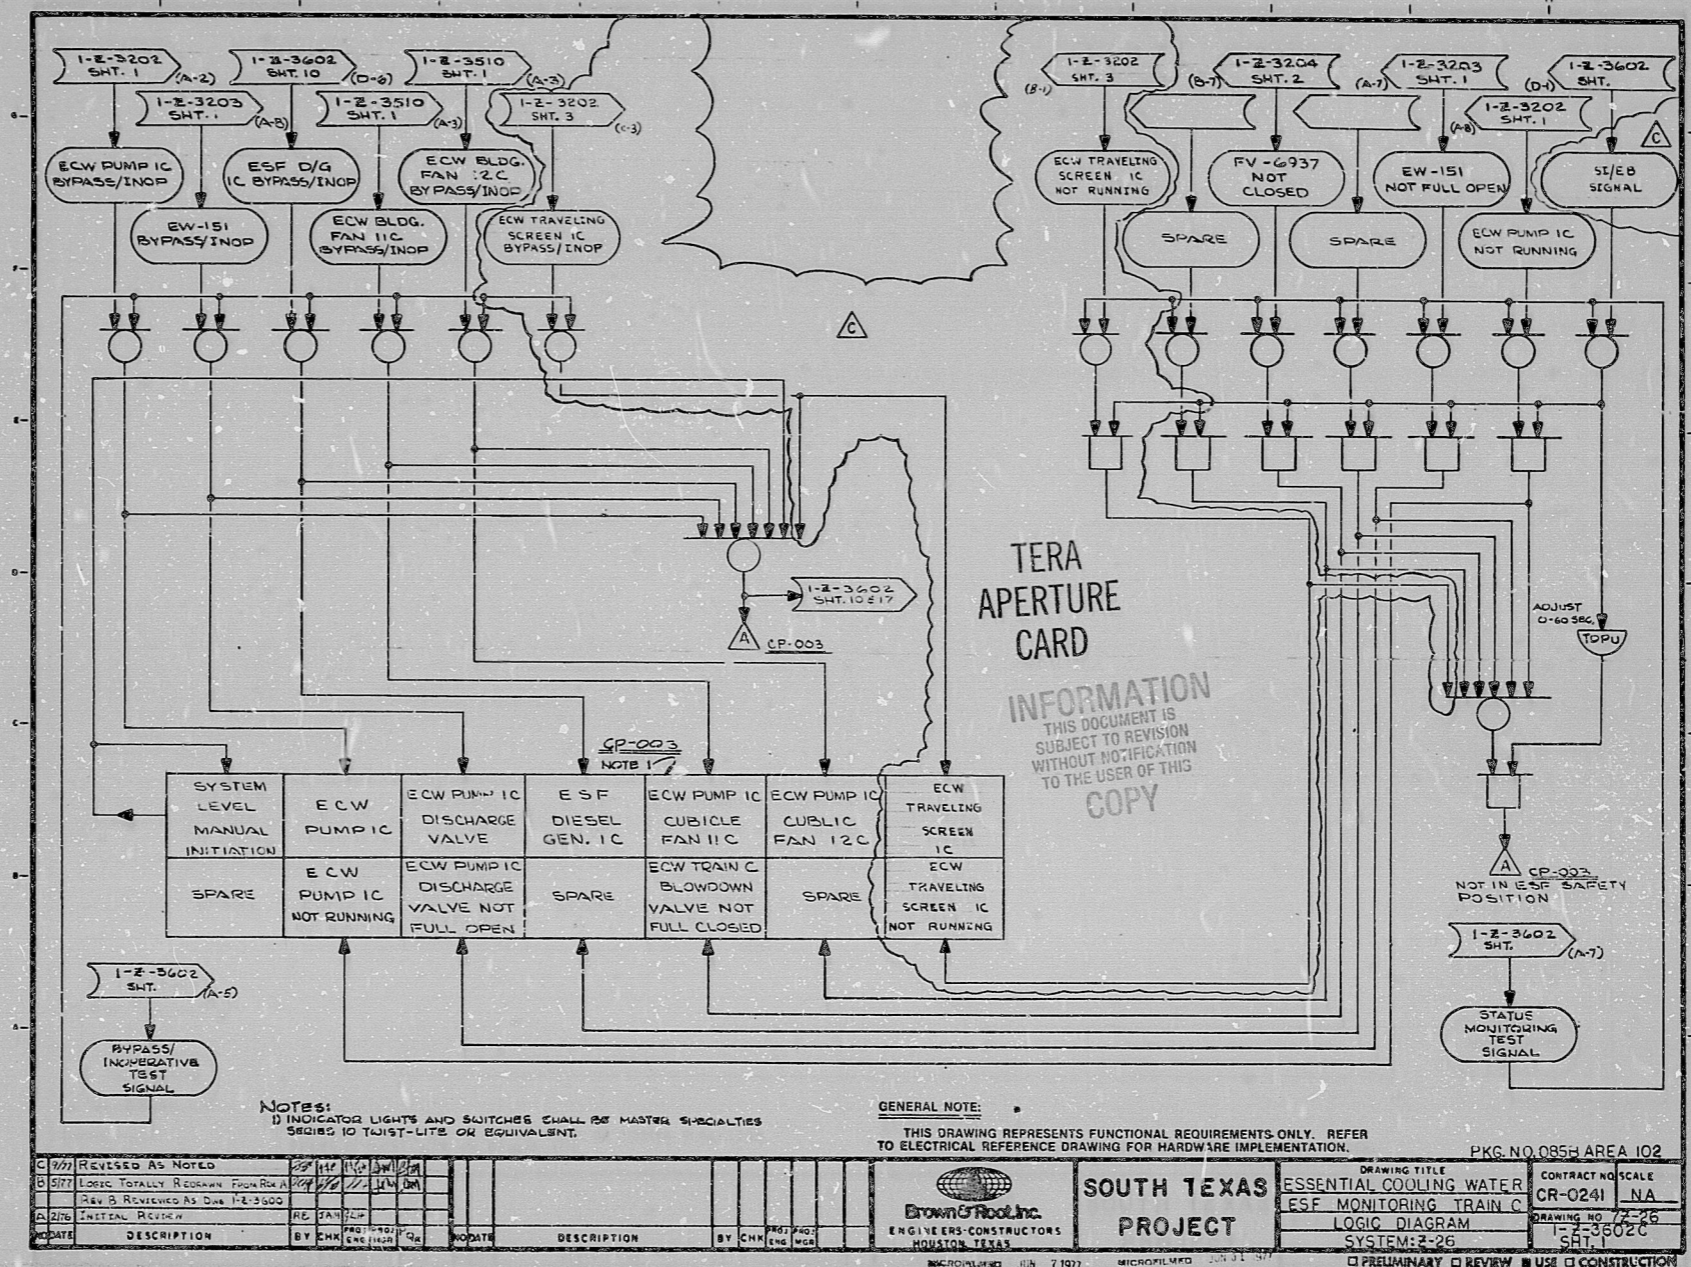

NOTES:
 1) INDICATOR LIGHTS AND SWITCHES SHALL BE MASTER SPECIALTIES SERIES 10 TWIST-LITE OR EQUIVALENT.

GENERAL NOTE:
 THIS DRAWING REPRESENTS FUNCTIONAL REQUIREMENTS ONLY. REFER TO ELECTRICAL REFERENCE DRAWING FOR HARDWARE IMPLEMENTATION.

PKG. NO. 0854 AREA 102

DATE	DESCRIPTION	BY	CHK	DATE	DESCRIPTION	BY	CHK
12/26	INITIAL REVIEW	RE	JAN	12/26	INITIAL REVIEW	RE	JAN
12/26	REVISION	RE	JAN	12/26	REVISION	RE	JAN

BROWN & ROOT INC.
 ENGINEERS-CONSTRUCTORS
 HOUSTON, TEXAS

SOUTH TEXAS PROJECT


DRAWING TITLE: ESSENTIAL COOLING WATER ESF MONITORING TRAIN C
 LOGIC DIAGRAM
 SYSTEM: 2-26

CONTRACT NO. CR-0241
 SCALE: NA
 DRAWING NO. 7-26
 SHEET: 1-E-3502C

PRELIMINARY □ REVIEW □ USE □ CONSTRUCTION

BROWN & ROOT INC.
MICROFILM SERVICES

THURSDAY, SEPT. 23 1977

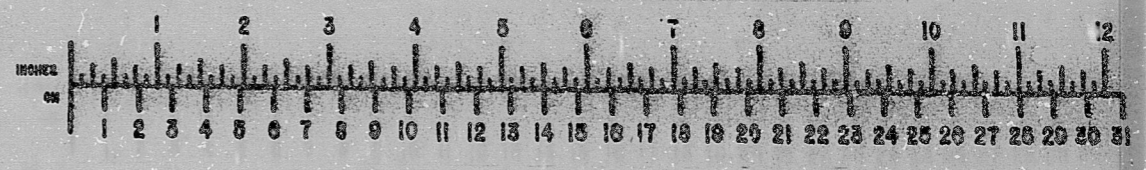

RIDS

8112080193

