



10090-W

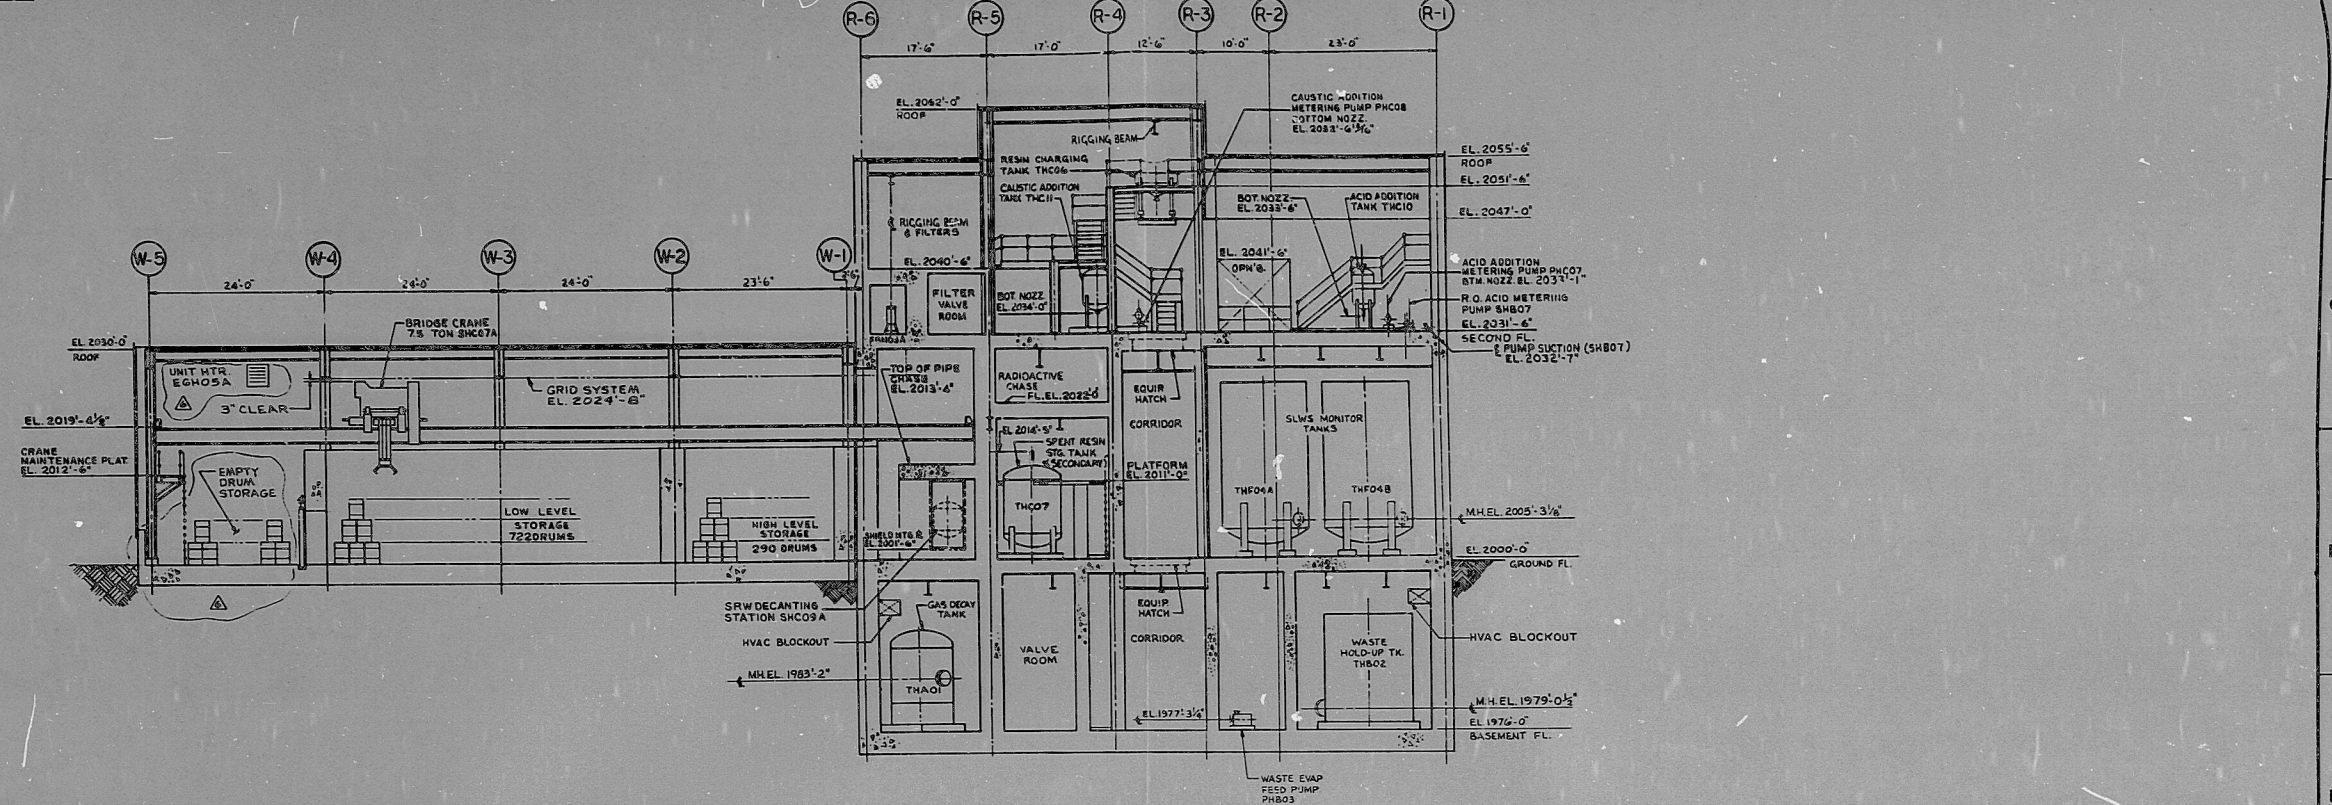

SECTION B
M-0605
SEE DWG. M-0600, M-0601, M-0602 & M-0603

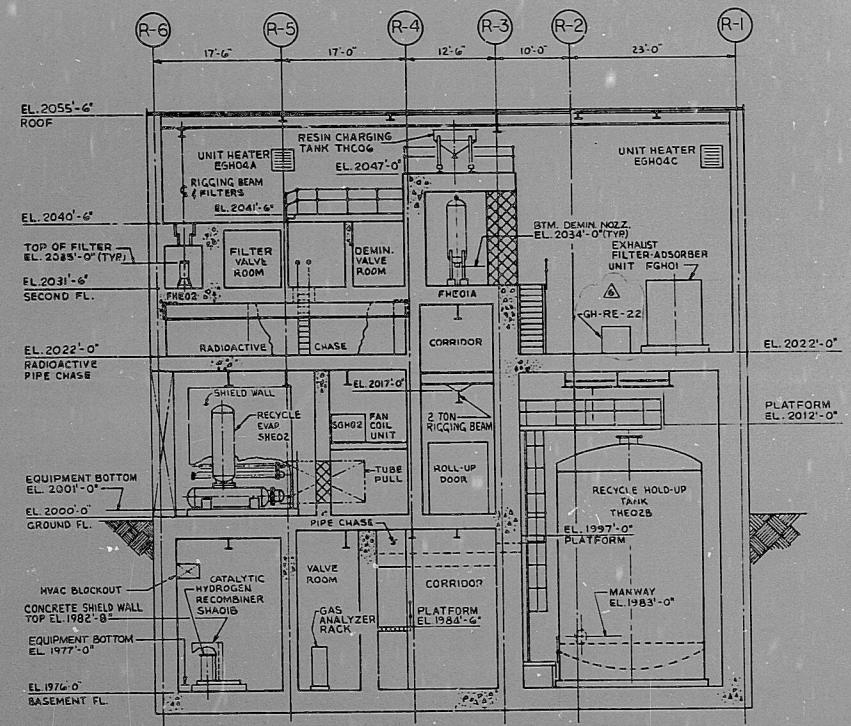

SECTION C
M-0605
SEE DWG. M-0600, M-0601, M-0602 & M-0603

TI
APERTURE
CARD

△	ADDED UNIT HTR. ESH04A. PREL. DRUM. STG. AREA. ADDED RADIATION MONITOR QH-RE-22.								
△	ADDED PROF. SEALS, MOD. SHIELD WALL & DELETED HVAC BLOCKOUT.								
△	MOD. LOCATION & ELEVATION OF SHB07. ADDED CONCRETE SHIELD WALLS.								
△	REVISED SECTIONS TO AGREE WITH PLANS. REMOVED HOLD PLATFORM OPENING. EL. 2047'-0" WAS 2045'-0". ACID PUMP PHC07, PHC08 & PHB03 NOZ. ELEVATIONS ADDED. DRUMMING AREA BRIDGE CRANE AND GRID SYS. ELEVATION ADDED. INTERMEDIATE PLATFORM AT EL. 1997'-0" FOR VERT. LADDER (RECYCLE HOLD-UP AREA).								
△	SECTIONS REVISED TO AGREE WITH PLANS. EQUIPMENT ELEVATIONS ADDED.								
△	REVISED EL. 2022'-0" WAS 2021'-0". EL. 2031'-0" WAS EL. 2030'-0". EL. 2040'-0" WAS EL. 2040'-0". EL. 2047'-0" WAS 2045'-0". EL. 2051'-0" WAS 2050'-0". EL. 2055'-0" WAS 2054'-0". EL. 2062'-0" WAS 2060'-0". REVISED COLUMN LINES IN DRUM STORAGE AREA. HVAC BLOCKOUT WAS PIPE BLOCKOUT.								

COORDINATION SIGN OFF

DATE	BY	FOR
10/15/95

REVIEW LEVEL 1

NOTICE: ALL INFORMATION CONTAINED HEREIN IS THE PROPERTY OF BECHTEL CORPORATION. IT IS LOANED TO YOU BY BECHTEL CORPORATION AND IS NOT TO BE REPRODUCED OR TRANSMITTED IN ANY FORM OR BY ANY MEANS, ELECTRONIC OR MECHANICAL, INCLUDING PHOTOCOPYING, RECORDING, OR BY ANY INFORMATION STORAGE AND RETRIEVAL SYSTEM, WITHOUT THE WRITTEN PERMISSION OF BECHTEL CORPORATION.

DATE: 10/15/95
BY: [Signature]
FOR: [Signature]

SCALE: AS SHOWN

BECHTEL
GAITHERSBURG, MARYLAND

SNUPPS
EQUIPMENT LOCATION
RADWASTE BUILDING
SECTIONS C & E

UTILITY DRAWING NO.	REV.
10466	M-06015
6	

This drawing and the design it covers is the property of SNUPPS which was prepared in the SNUPPS Project. It is loaned to the borrower's representative and it will not be reproduced, altered, copied, or used in any way without the written consent of SNUPPS. Utility to the borrower.

8410050614

PDR RIDS

