

17"

11"

8.5"

8.5"

11"

17"

17"


11"

8.5"

8.5"

11"

17"

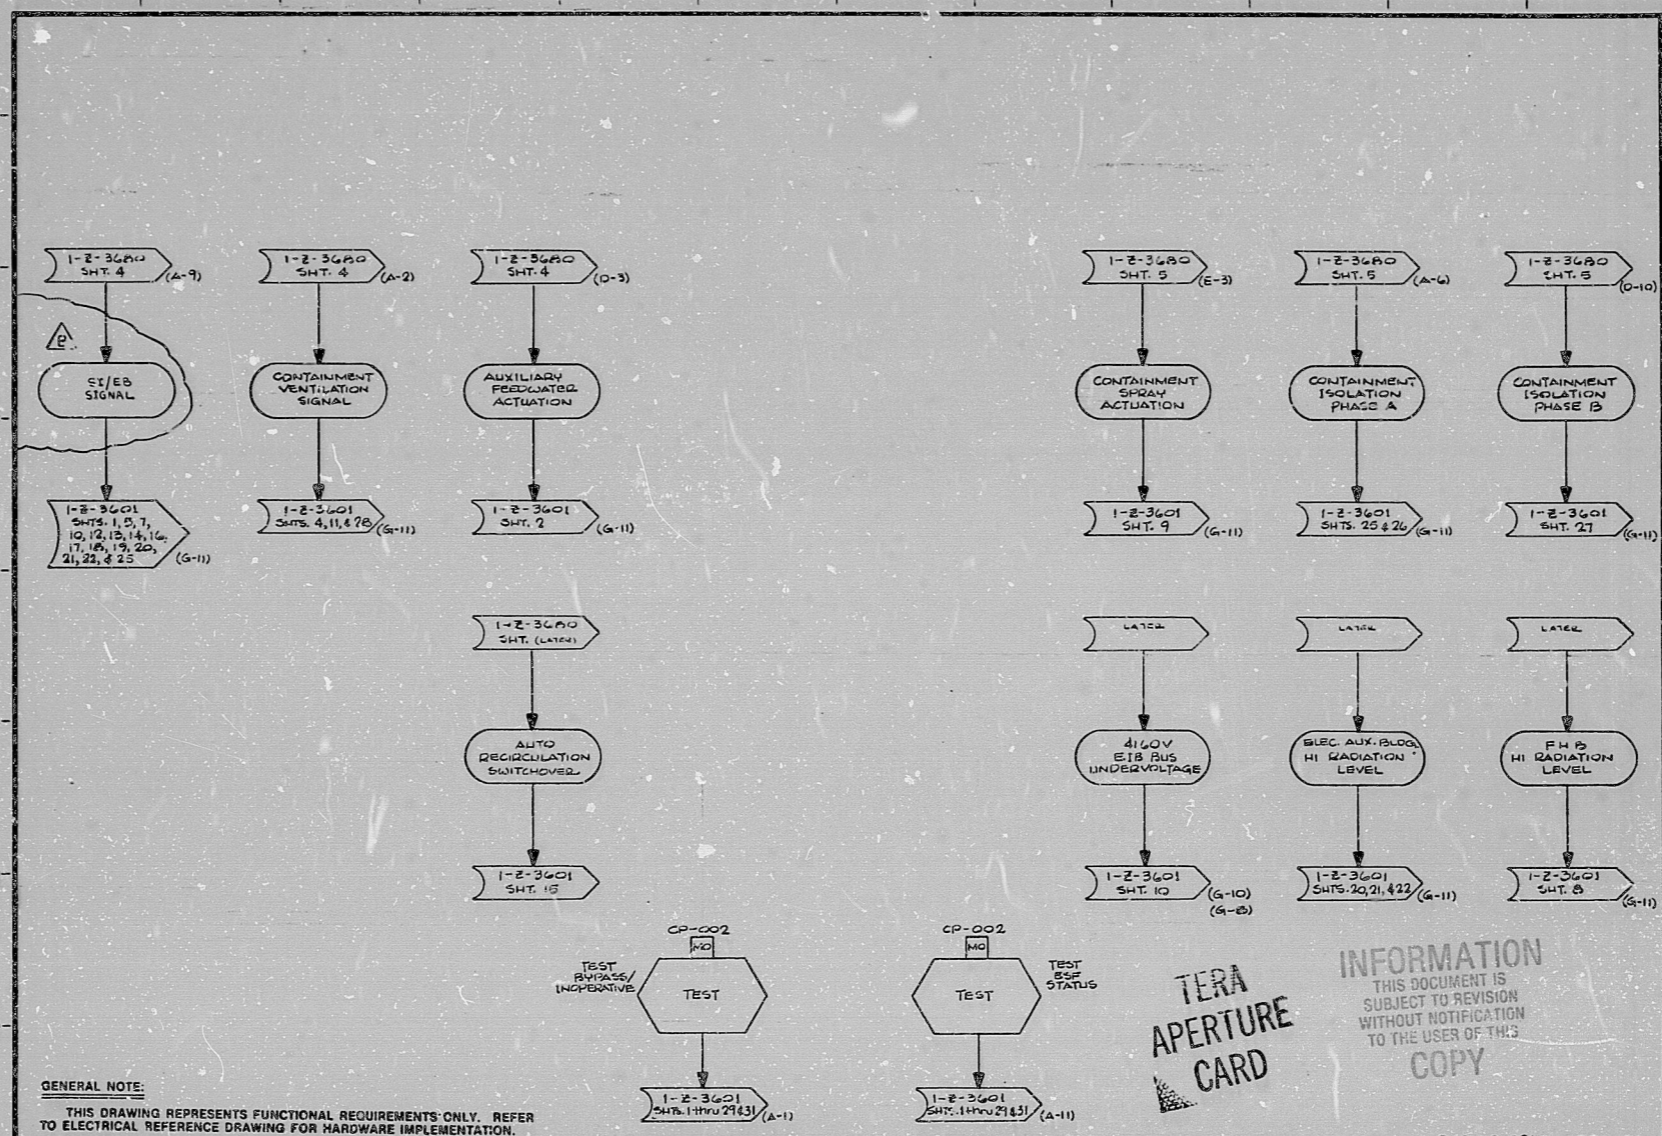


**GENERAL NOTE:**  
 THIS DRAWING REPRESENTS FUNCTIONAL REQUIREMENTS ONLY. REFER TO ELECTRICAL REFERENCE DRAWING FOR HARDWARE IMPLEMENTATION.

TERA APERTURE CARD  
 INFORMATION  
 THIS DOCUMENT IS SUBJECT TO REVISION WITHOUT NOTIFICATION TO THE USER OF THIS COPY

B 1277 REVISION AS NOTED A BIRTH LOGIC WAS REVISIONED AS SHW 1-2-3600				PKG. NO. 0658A AREA 102 CONTRACT NO. SCALE CR-0241 NA DRAWING NO. 2-26 SYSTEM: 2-26 SHEET: 30			
DATE	DESCRIPTION	BY	CHK	DATE	DESCRIPTION	BY	CHK

**BROWN & ROOT INC.**  
**MICROFILM SERVICES**

THURSDAY, SEPT. 22 1977

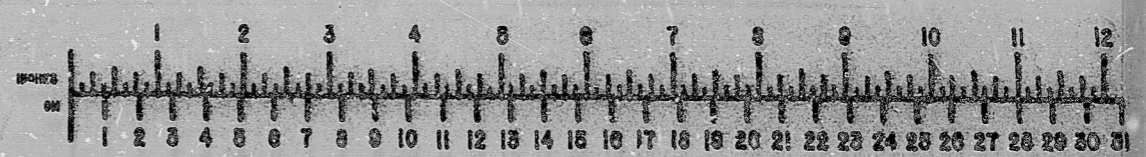

RIDS

812080221

