



11
8.5
11
8.5
17

11
8.5
11
8.5
17

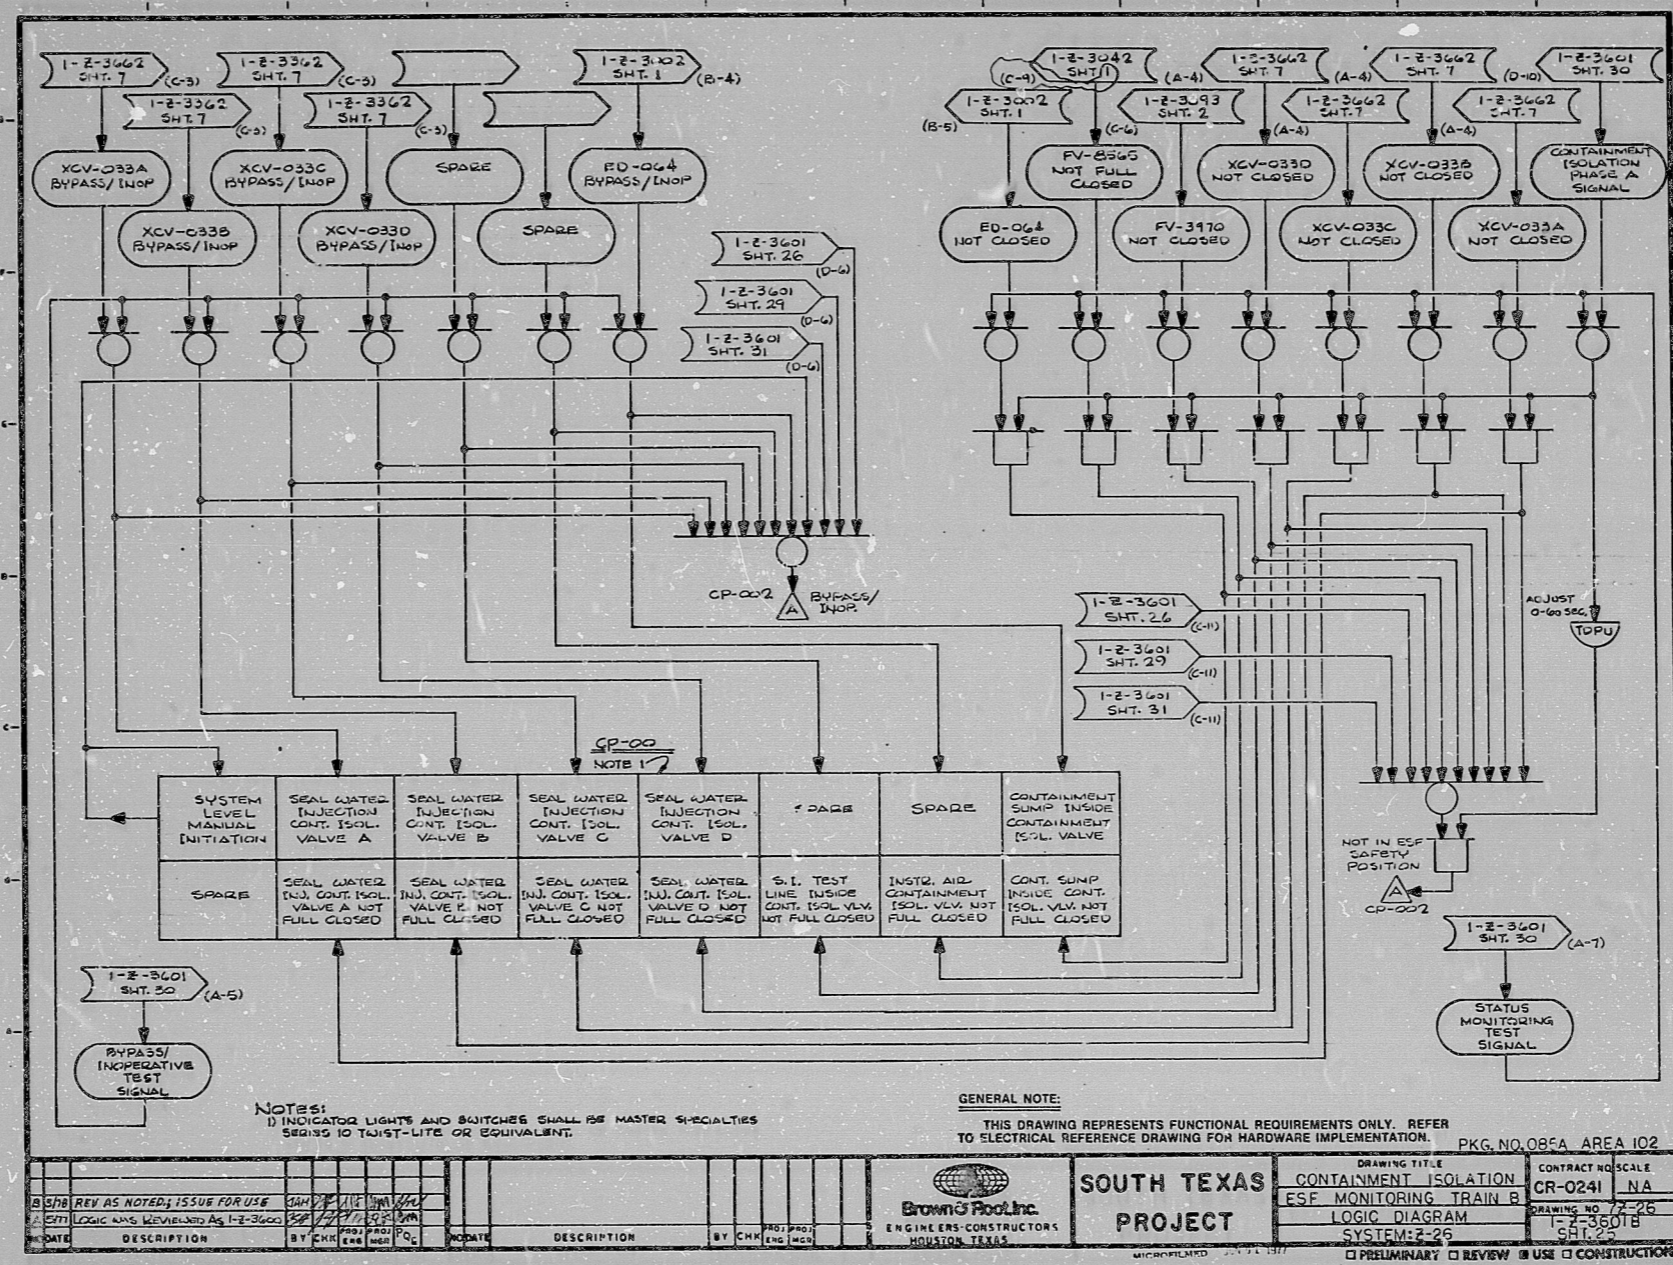

BROWN & ROOT INC.
MICROFILM SERVICES

FRIDAY, JUNE 5 1978

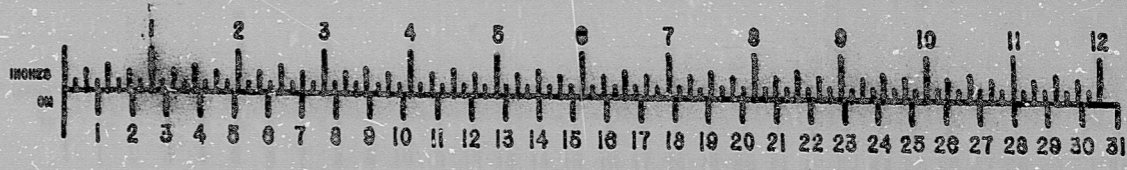

TERA
APERTURE
CARD

INFORMATION
THIS DOCUMENT IS
SUBJECT TO REVISION
WITHOUT NOTIFICATION
TO THE USER OR THIS
COPY

KIDS

812080225

