

17"

11"

8.5"

8.5"

11"

17"

17"


11"

8.5"

8.5"

11"

17"

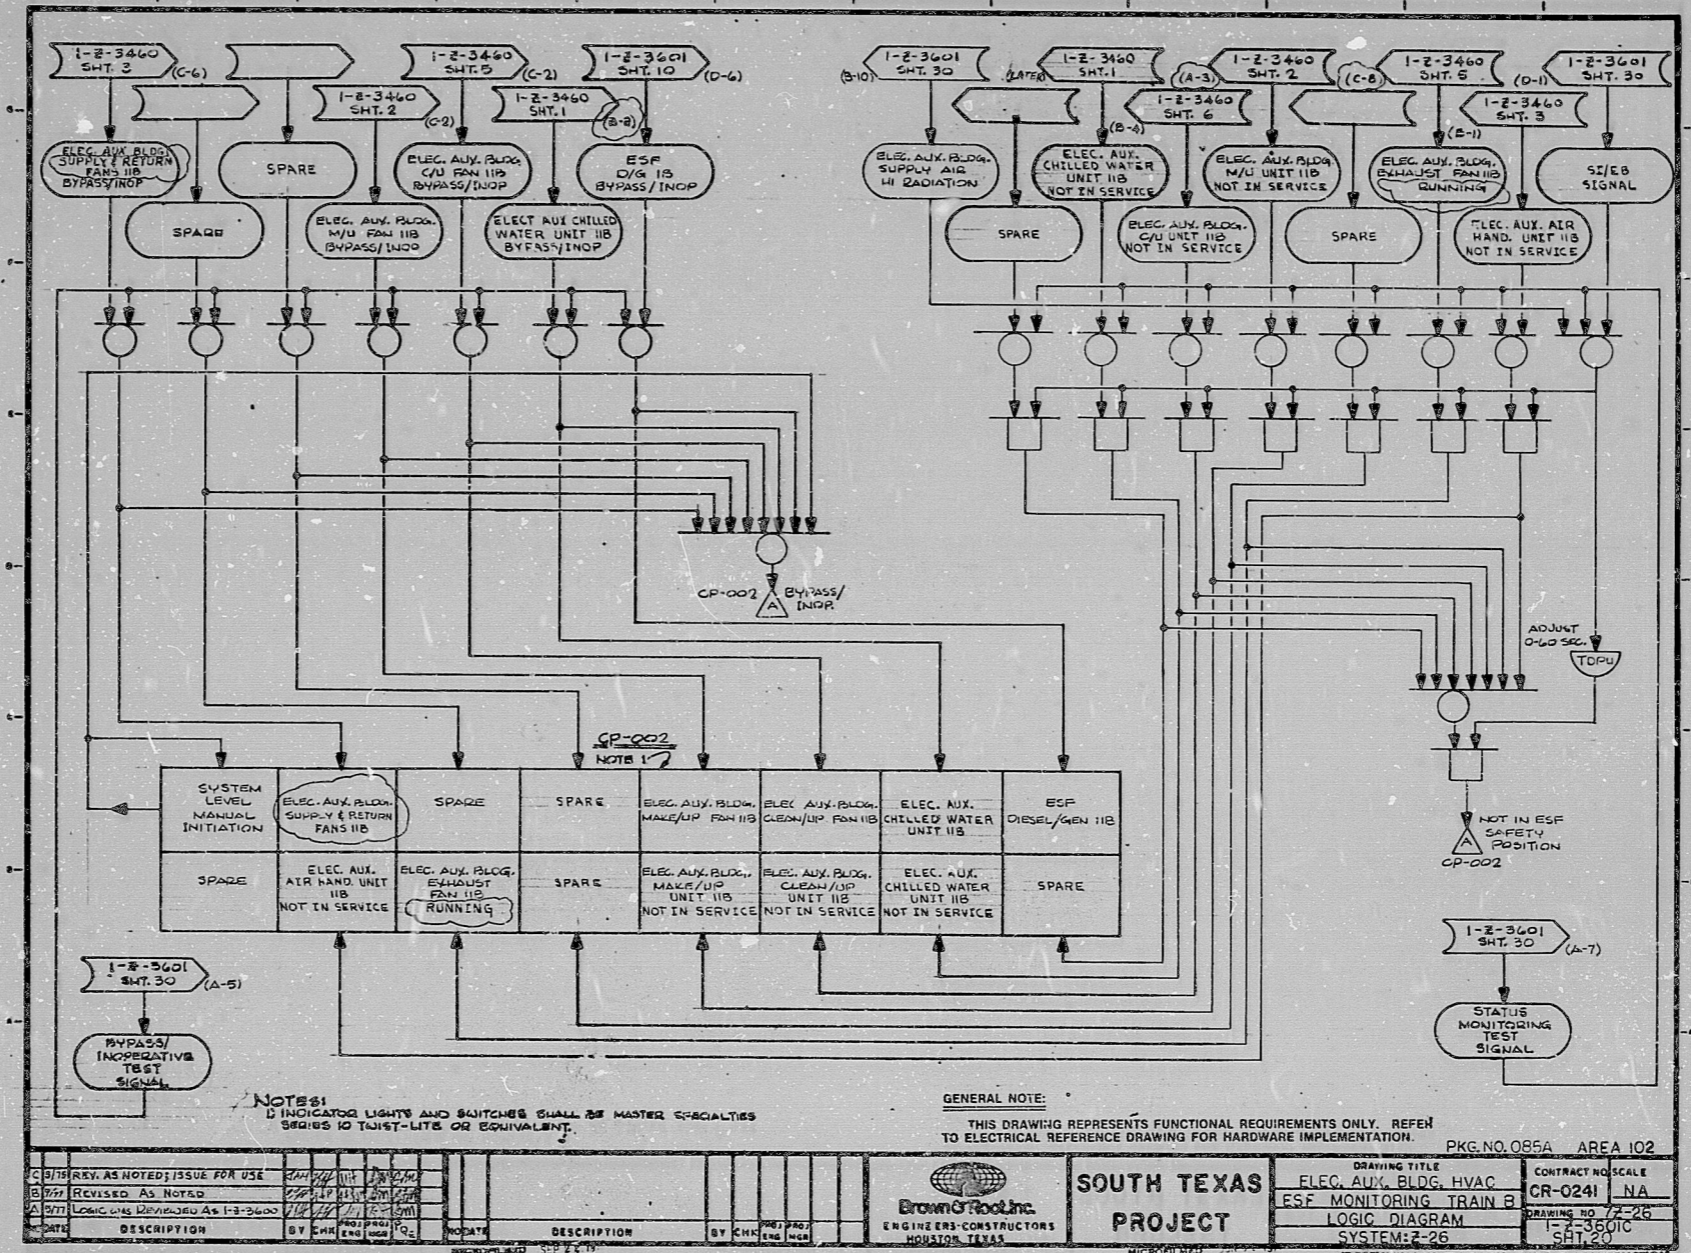

BROWN & ROOT INC. MICROFILM SERVICES

FRIDAY, JUNE 9 1978



TERA APERTURE CARD

INFORMATION THIS DOCUMENT IS SUBJECT TO REVISION WITHOUT NOTIFICATION TO THE USER OF THIS COPY

RIDS

8112080227

