


17  
11  
8.5  
8.5  
11  
17

17  
11  
8.5  
8.5  
11  
17

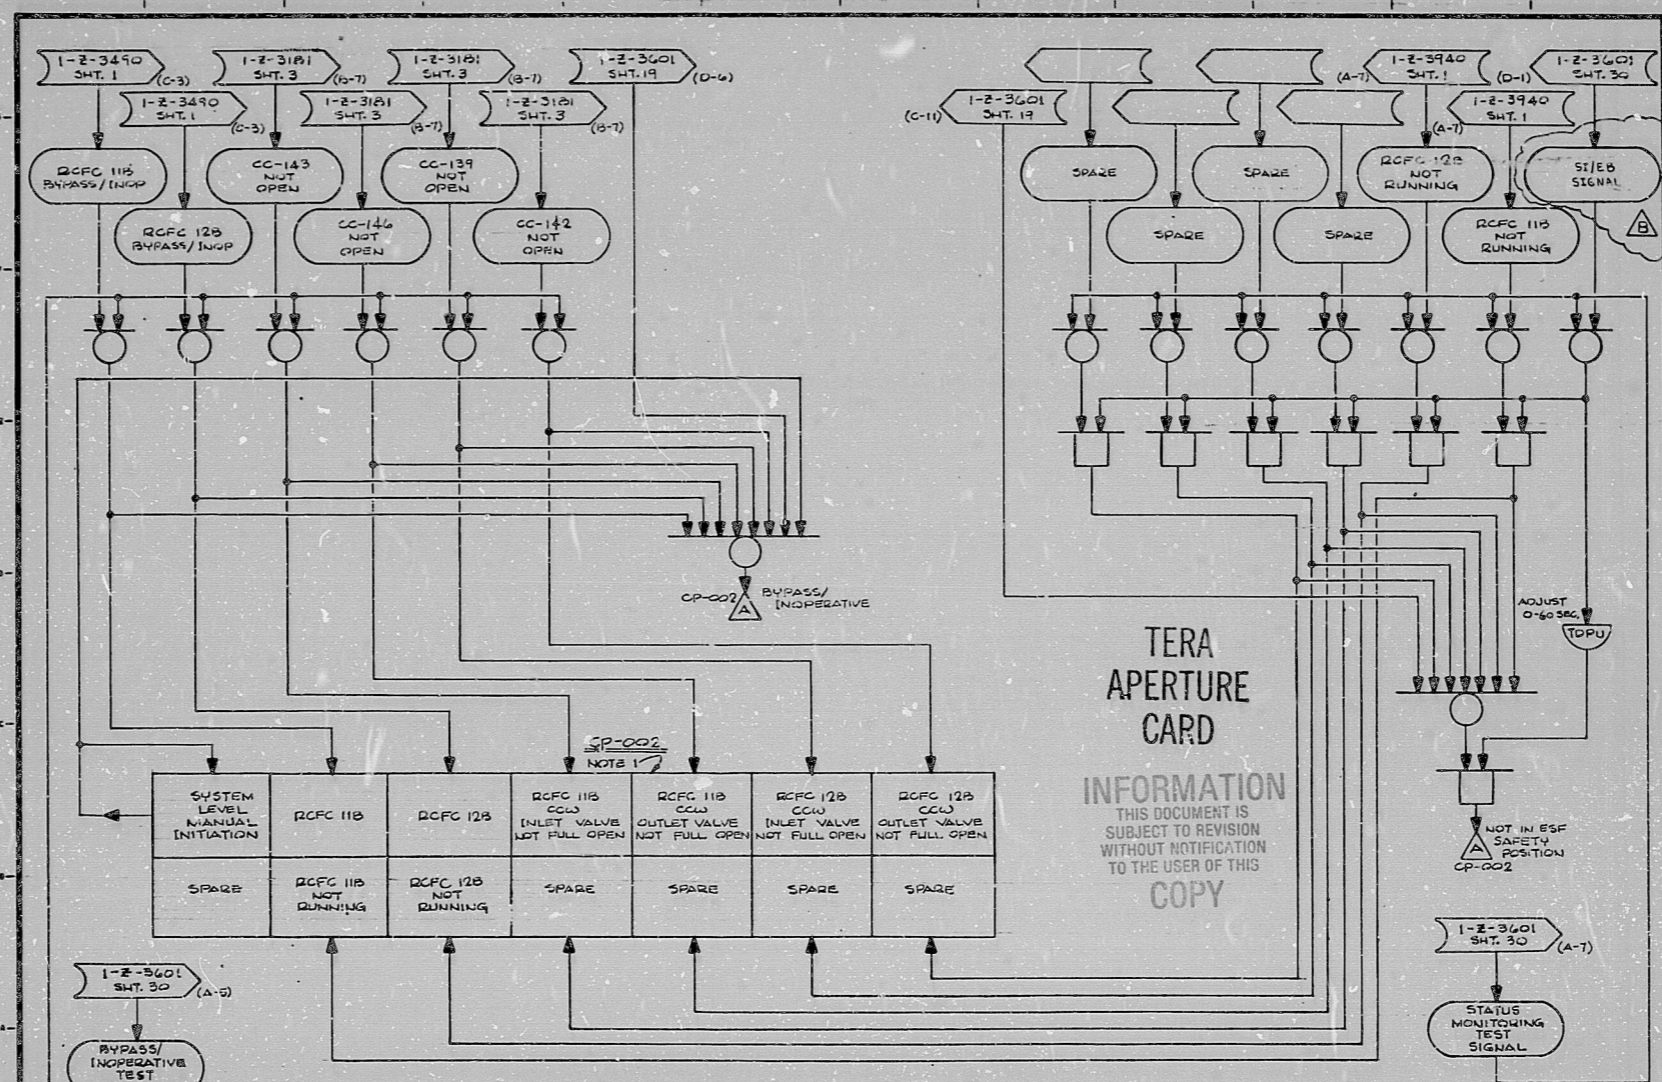

**NOTES:**  
1. INDICATOR LIGHTS AND SWITCHES SHALL BE MASTER SPECIALTIES SERIES 10 TWIST-LITE OR EQUIVALENT.

**GENERAL NOTE:**  
THIS DRAWING REPRESENTS FUNCTIONAL REQUIREMENTS ONLY. REFER TO ELECTRICAL REFERENCE DRAWING FOR HARDWARE IMPLEMENTATION.

PKG. NO. 085A AREA 102

REVISIONS	DATE	DESCRIPTION	BY	CHKD	APP'D
B-1077	REVISED AS NOTED				
A-1077	LOGIC WAS REVISED AS 1-2-3-000				

DRAWING TITLE: CONT. HEAT REMOVAL ESF MONITORING TRAIN B LOGIC DIAGRAM SYSTEM: Z-26  
CONTRACT NO. SCALE: CR-0241 N/A  
DRAWING NO. 7-26  
SHEET NO. 5/13

MICROFILMED JUN 31 1977  
PRELIMINARY □ REVIEW □ USE □ CONSTRUCTION

**BROWN & ROOT INC.**  
**MICROFILM SERVICES**  
THURSDAY, SEPT. 22 1977



RIDS

812080231

