

17

11

8.5

8.5

11

17

17


11

8.5

8.5

11

17

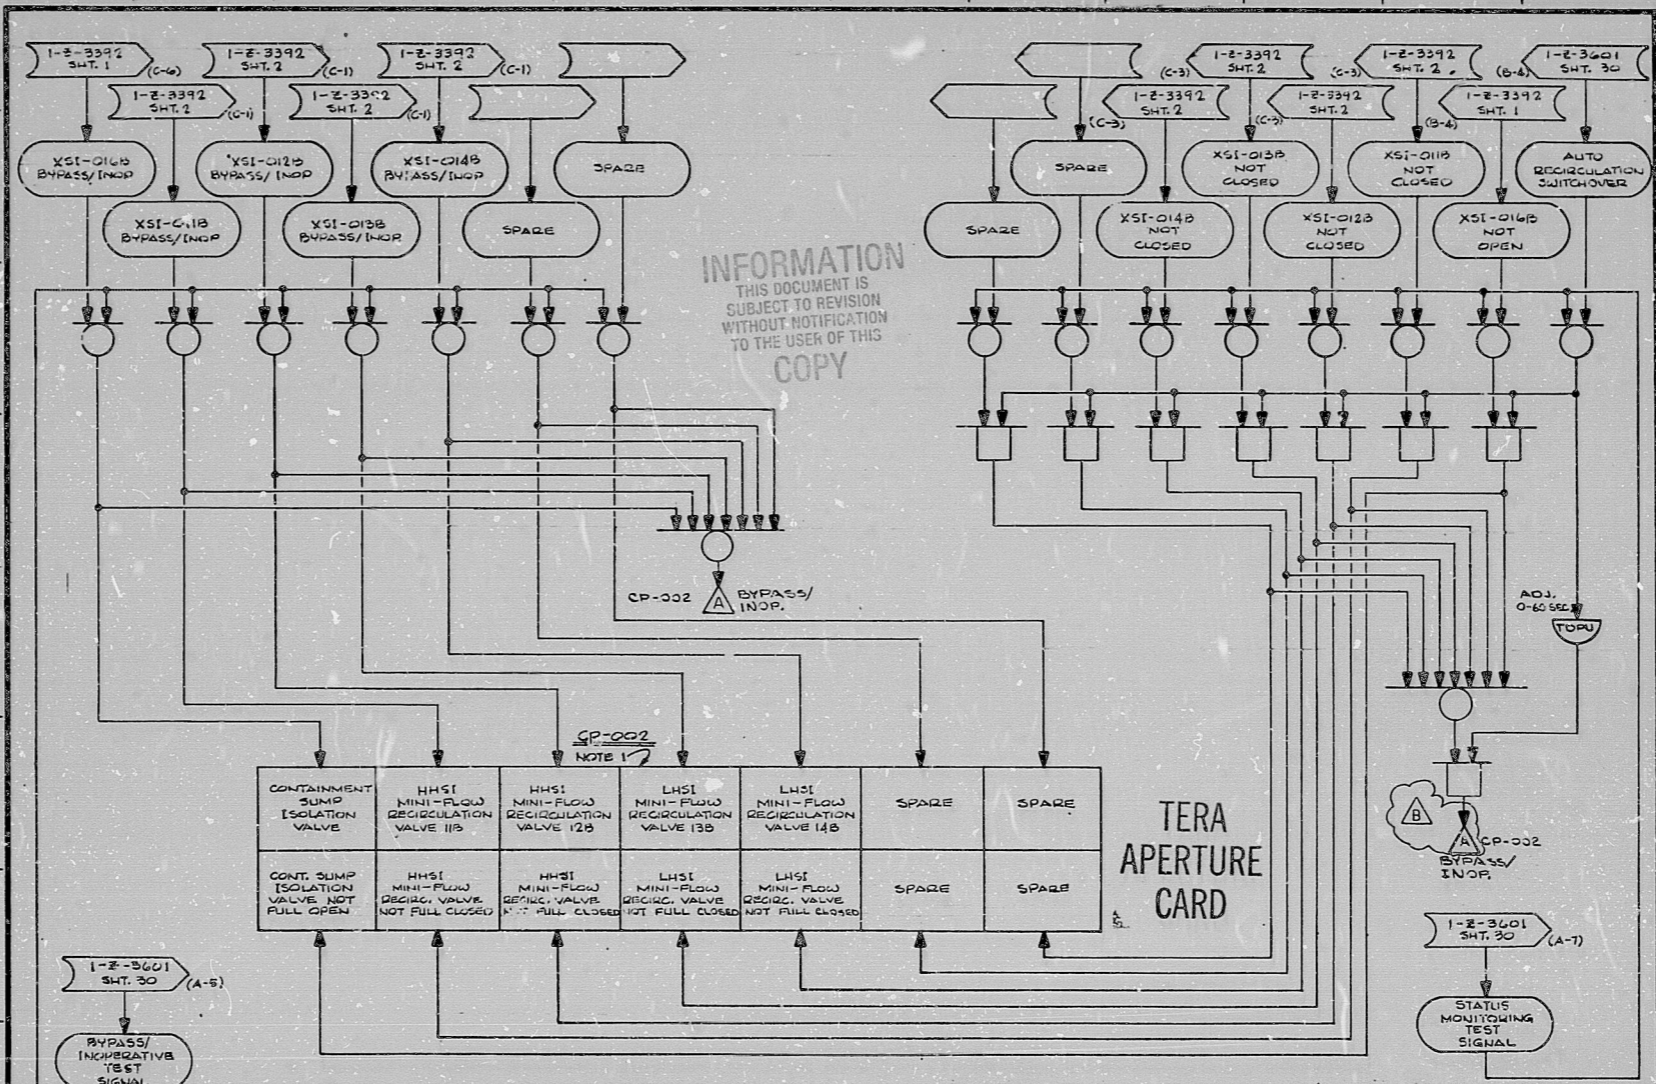

NOTES:
1) INDICATOR LIGHTS AND SWITCHES SHALL BE MASTER SPECALITIES SERIES 10 TWIST-LITE OR EQUIVALENT.

GENERAL NOTE:
THIS DRAWING REPRESENTS FUNCTIONAL REQUIREMENTS ONLY. REFER TO ELECTRICAL REFERENCE DRAWING FOR HARDWARE IMPLEMENTATION.

REVISED AS NOTED	DATE	BY	DESCRIPTION	DATE	BY	DESCRIPTION
AS NOTED	1-2-3-3000					

SOUTH TEXAS PROJECT		DRAWING TITLE EMERG. CORE COOLING ESF MONITORING TRAIN B LOGIC DIAGRAM SYSTEM: 2-26	CONTRACT NO. SCALE CR-0241 NA
Brown & Root Inc. ENGINEERS-CONSTRUCTORS HOUSTON, TEXAS		DRAWING NO. 2-26 SHEET 5	PKG. NO. 085A AREA 102
		<input type="checkbox"/> PRELIMINARY <input type="checkbox"/> REVIEW <input checked="" type="checkbox"/> USE <input type="checkbox"/> CONSTRUCTION	

BROWN & ROOT INC.
MICROFILM SERVICES

THURSDAY, SEPT. 22 1977



RIDS

812080237

