


11
11
8.5
8.5
11
11
8.5
17

11
11
8.5
8.5
11
11
8.5
17

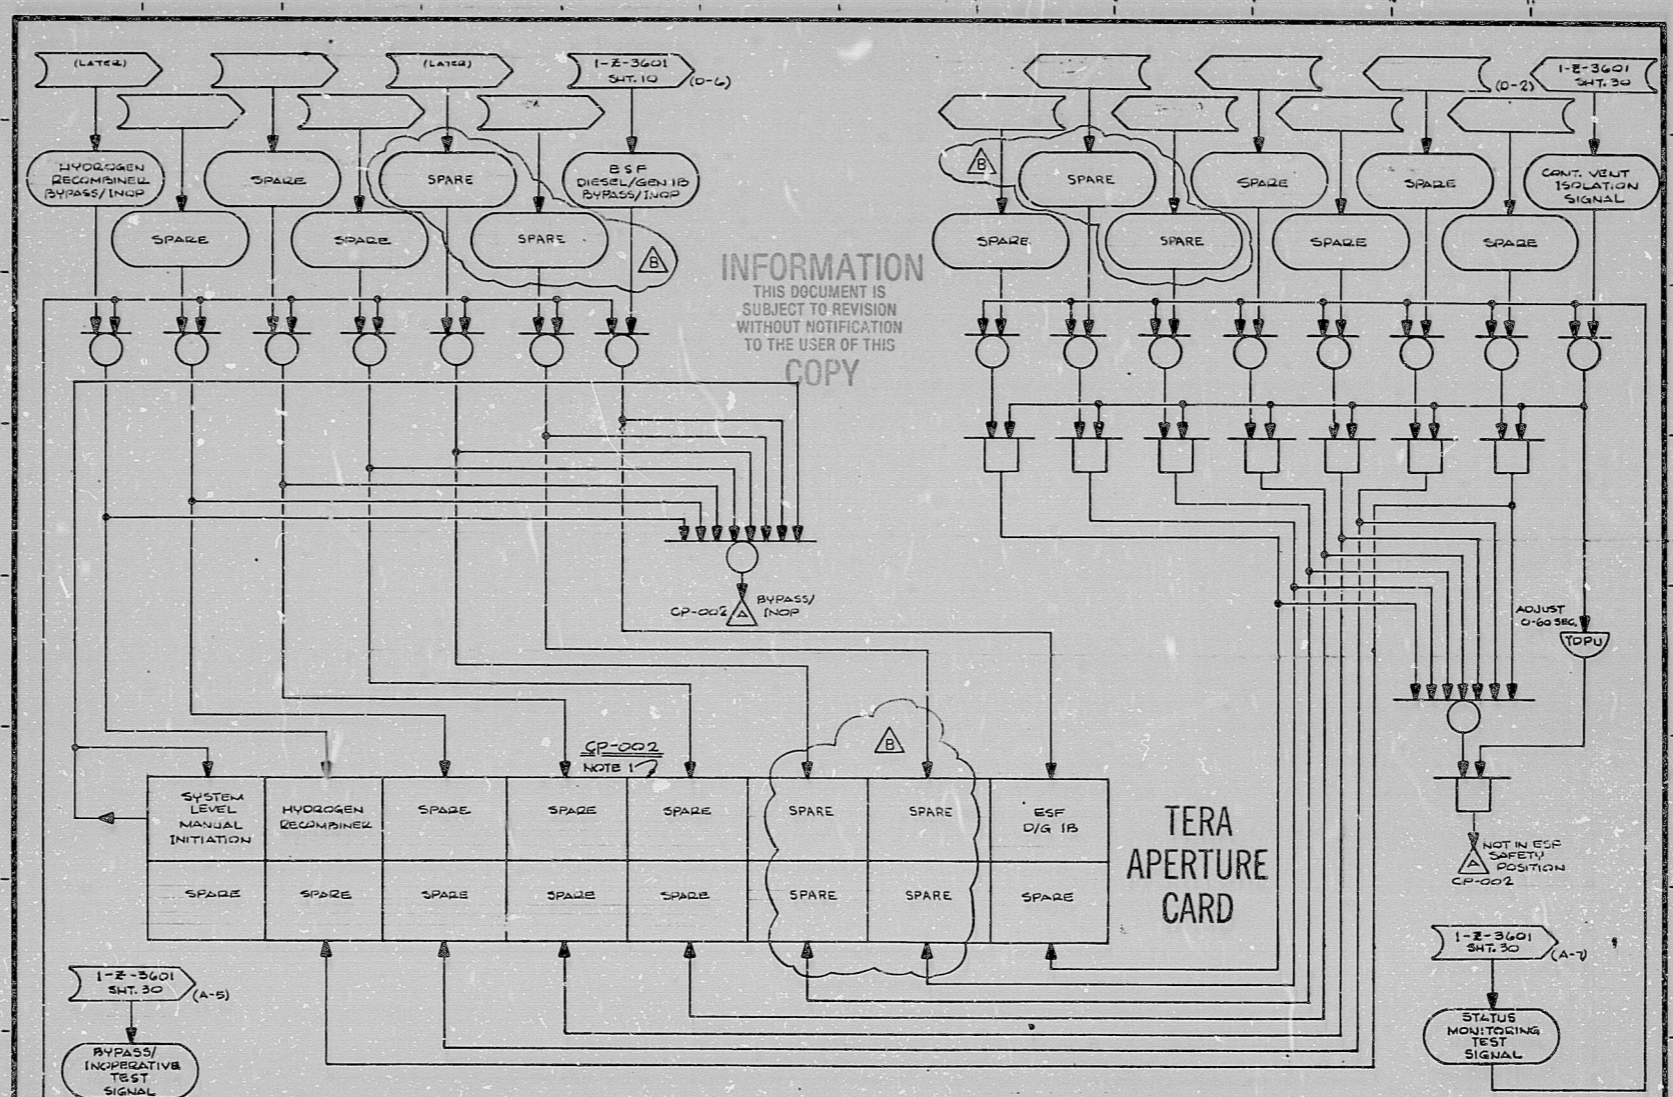


NOTES:
 1) INDICATOR LIGHTS AND SWITCHES SHALL BE IN THE SPECIALTIES SERIES 10 TWIST-LITE OR EQUIVALENT.

GENERAL NOTE:
 THIS DRAWING REPRESENTS FUNCTIONAL REQUIREMENTS ONLY. REFER TO ELECTRICAL REFERENCE DRAWING FOR HARDWARE IMPLEMENTATION.

REVISED AS NOTED	DATE	BY	DESCRIPTION	DATE	BY	DESCRIPTION	DATE	BY	DESCRIPTION	DATE	BY	DESCRIPTION	DATE	BY	DESCRIPTION	DATE	BY	DESCRIPTION	DATE	BY	DESCRIPTION
1-2-3601 SH-T. 10 (D-4)																					
1-2-3601 SH-T. 30 (A-5)																					
1-2-3601 SH-T. 30 (D-2)																					
1-2-3601 SH-T. 30 (A-7)																					

PKG. NO. 085A AREA 102
 SOUTH TEXAS PROJECT
 CONT. COMBUSTIBLE GAS
 ESF MONITORING TRAIN B
 LOGIC DIAGRAM
 SYSTEM 2-26
 CONTRACT NO. CR-0241
 DRAWING NO. 72-26
 1-2-3601B
 SH-T. 11
 ENGINEERS-CONSTRUCTORS
 HOUSTON, TEXAS
 MICROFILMED
 PRELIMINARY REVIEW IN USE CONSTRUCTION

BROWN & ROOT INC.
 MICROFILM SERVICES
 THURSDAY, SEPT. 22 1977

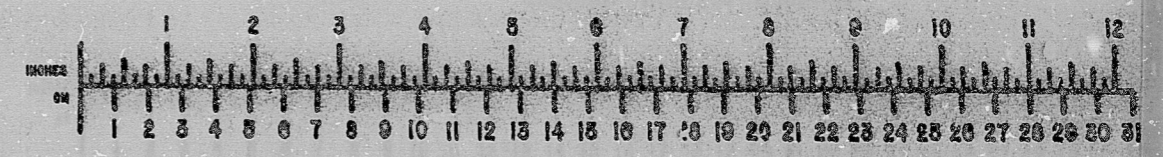

RIDS

812080245

