

17

11

8.5

8.5

11

17

17


11

8.5

8.5

11

17

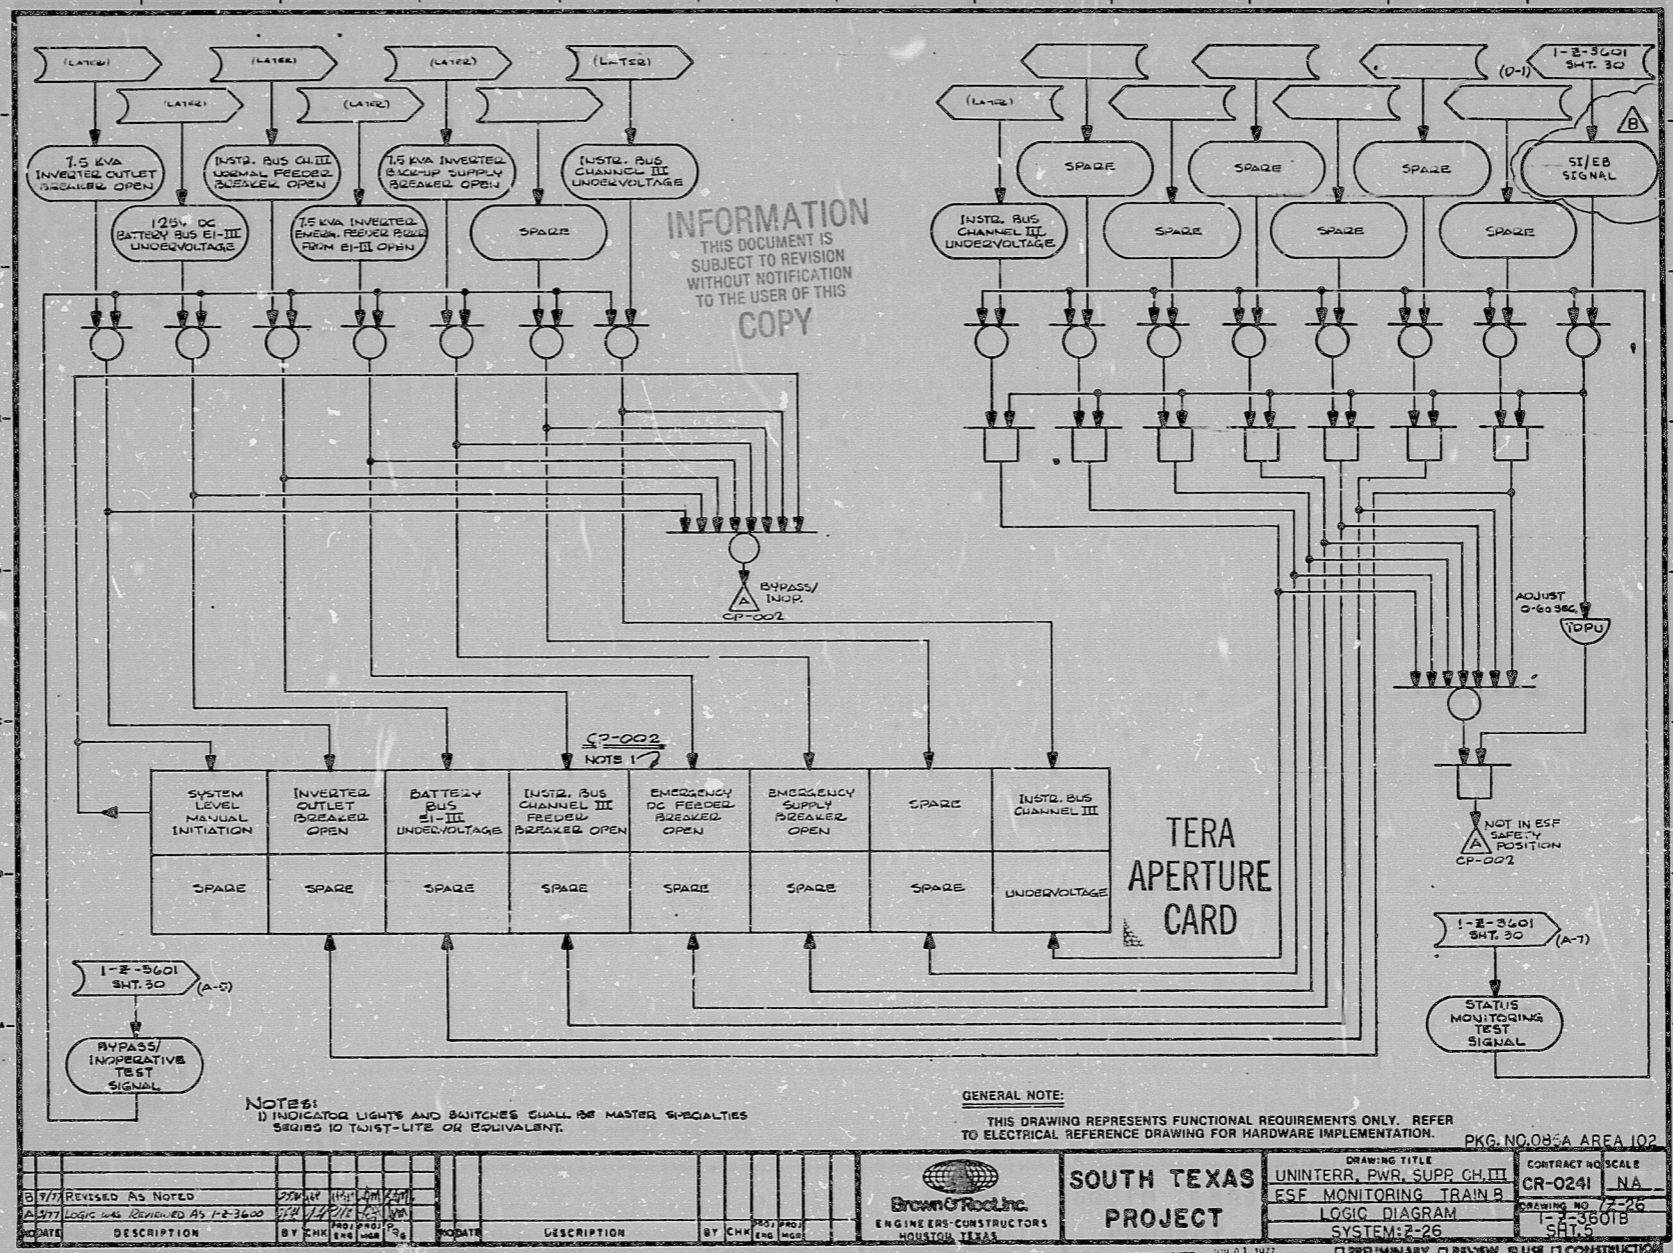

NOTES:
 1) INDICATOR LIGHTS AND SWITCHES SHALL BE MASTER SPECIALTIES
 SWITCHES TO TWIST-LIFE OR EQUIVALENT.

GENERAL NOTE:
 THIS DRAWING REPRESENTS FUNCTIONAL REQUIREMENTS ONLY. REFER
 TO ELECTRICAL REFERENCE DRAWING FOR HARDWARE IMPLEMENTATION.

REVISED AS NOTED	DATE	BY	CHK	ENG	MOD	DATE	DESCRIPTION	BY	CHK	ENG	MOD	DATE	DESCRIPTION	BY	CHK	ENG	MOD	DATE	DESCRIPTION

PKG. NO. OR: A AREA 102
 CONTRACT NO. SCALE
 CR-0241 N.A.
 DRAWING NO. 2-26
 SYSTEM: 2-26
 SHT. 3

UNINTERR. PWR. SUPP. CH. III
 ESF MONITORING TRAIN B
 LOGIC DIAGRAM
 SYSTEM: 2-26

BROWN & ROOT INC.
 ENGINEERS-CONSTRUCTORS
 HOUSTON, TEXAS

SOUTH TEXAS PROJECT

MICROFILMED JUN 01 1977
 PRELIMINARY REVIEW USE CONSTRUCTION

BROWN & ROOT INC.
 MICROFILM SERVICES

THURSDAY, SEPT. 22 1977



RIDS

8112080255

