

11

11

8.5"

8.5"

11"

17"

11


11

8.5"

8.5"

11"

17"

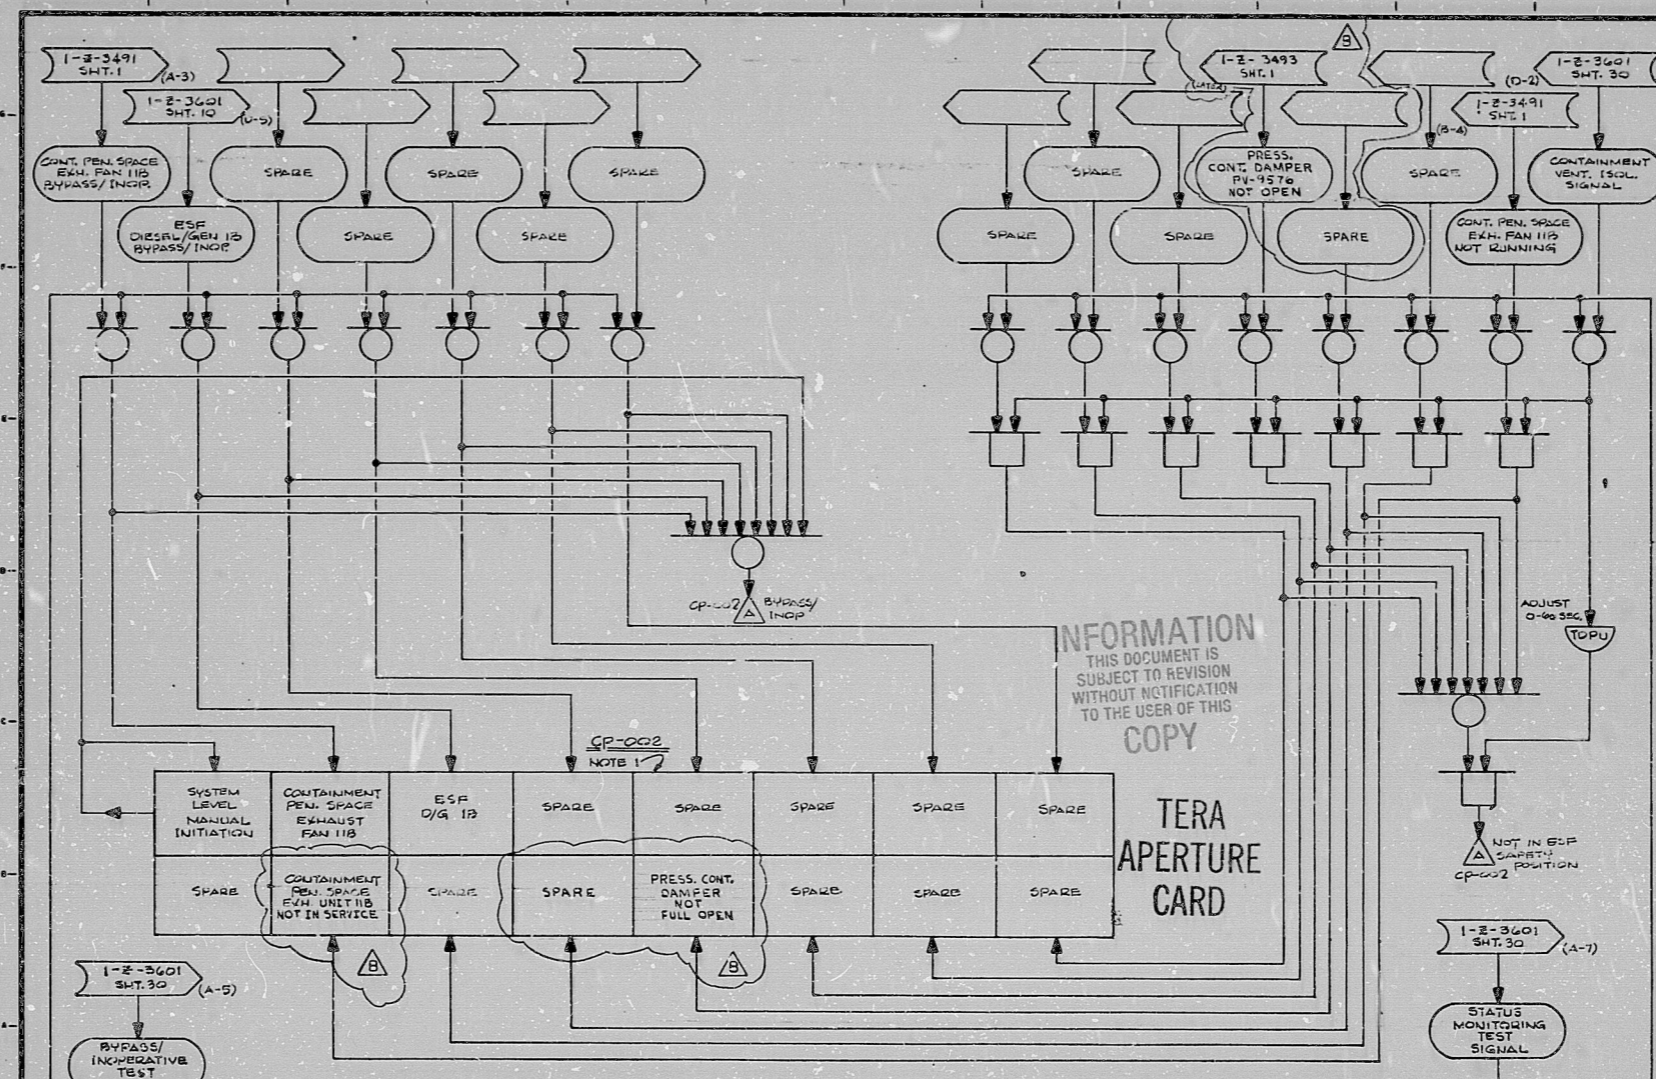

INFORMATION
THIS DOCUMENT IS
SUBJECT TO REVISION
WITHOUT NOTIFICATION
TO THE USER OF THIS
COPY

TERA
APERTURE
CARD

NOTES:
1) INDICATOR LIGHTS AND SWITCHES SHALL BE MASTER SPECIALTIES SERIES 10 TEST-LITE OR EQUIVALENT.

GENERAL NOTE:
THIS DRAWING REPRESENTS FUNCTIONAL REQUIREMENTS ONLY. REFER TO ELECTRICAL REFERENCE DRAWING FOR HARDWARE IMPLEMENTATION.

NO.	DATE	DESCRIPTION	BY	CHK	APP	PROJ.	NO.	DESCRIPTION	BY	CHK	APP
1		REVISED AS NOTED									
2		LOGIC DIAGRAM REVIEWED AS 1-2-8000									

Brown & Root Inc.
ENGINEERS CONSTRUCTORS
HOUSTON, TEXAS

SOUTH TEXAS PROJECT

DRAWING TITLE
PEN. SPACE HVAC
ESF MONITORING TRAIN B
LOGIC DIAGRAM
SYSTEM: 2-26

CONTRACT NO./SCALE
CR-0241 NA
DRAWING NO. / 2-26
1-E-3601B
SHT. 30

PKG. NO. 055A AREA 10P

MICROFILMED 1-11-1977

PRELIMINARY REVIEW USE CONSTRUCTION

BROWN & ROOT INC.
MICROFILM SERVICES

THURSDAY, SEPT. 23 1977



RIDS

812080259

