

17"

11"

8.5"

8.5"

11"

17"

17"


11"

8.5"

8.5"

11"

17"

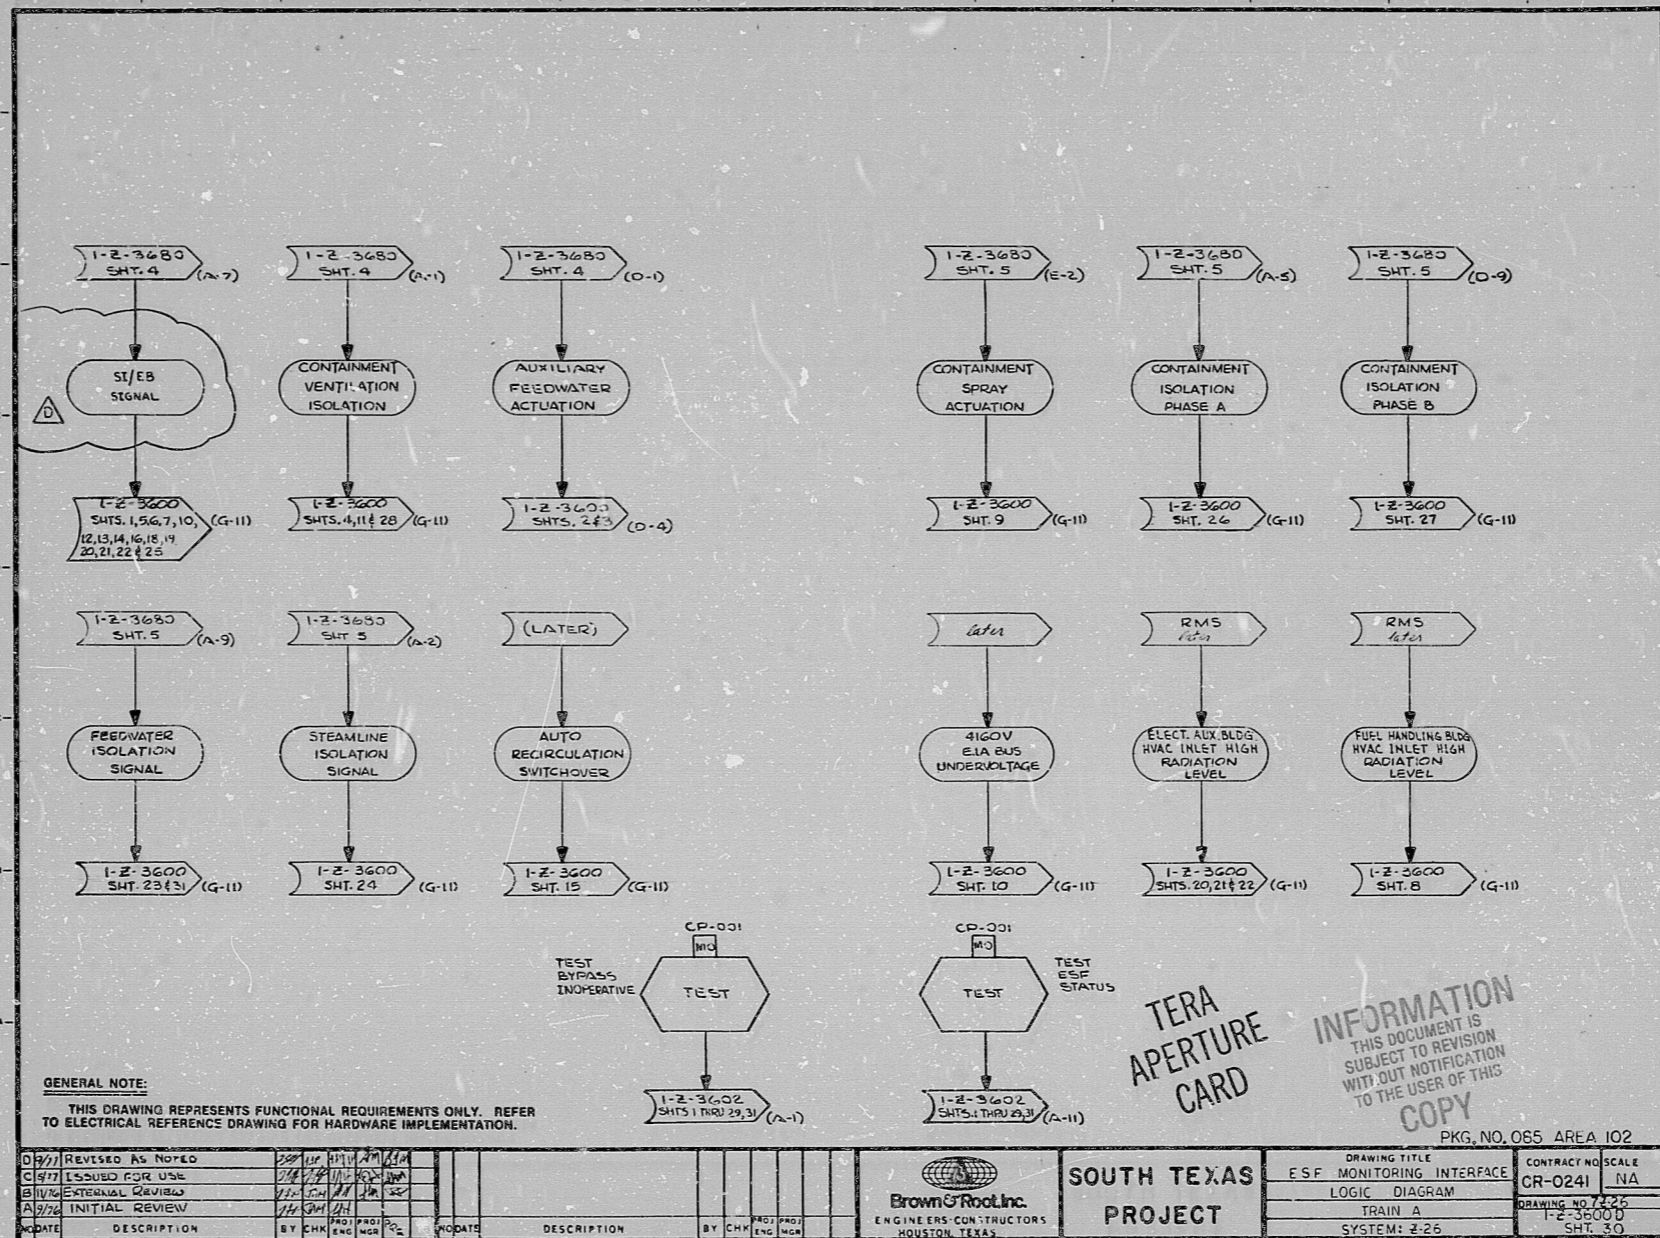

| | | | | | | | | | | | | | | | | | | | | | | |
|-------|------------------|-------|----------------|-------|-----------------|-------|----------------|-------|------|-------------|----|-----|------|-----|------|------|-------------|----|-----|------|-----|------|
| 09/77 | REVISED AS NOTED | 09/77 | ISSUED FOR USE | 09/77 | EXTERNAL REVIEW | 09/77 | INITIAL REVIEW | 09/77 | DATE | DESCRIPTION | BY | CHK | PROJ | ENG | INCH | DATE | DESCRIPTION | BY | CHK | PROJ | ENG | INCH |
| | | | | | | | | | | | | | | | | | | | | | | |

BROWN & ROOT INC.
MICROFILM SERVICES

THURSDAY, SEPT. 23 1977



SOUTH TEXAS PROJECT

DRAWING TITLE: E.S.F. MONITORING INTERFACE
LOGIC DIAGRAM
TRAIN A
SYSTEM: 2-26

CONTRACT NO. CR-0241
SCALE: NA
DRAWING NO. 1-2-3600
SHEET: 30

PRELIMINARY REVIEW USE CONSTRUCTION

RIDS

8112080270

