

17"

11"

8.5"

8.5"

11"

17"

17"


11"

8.5"

8.5"


11"

17"

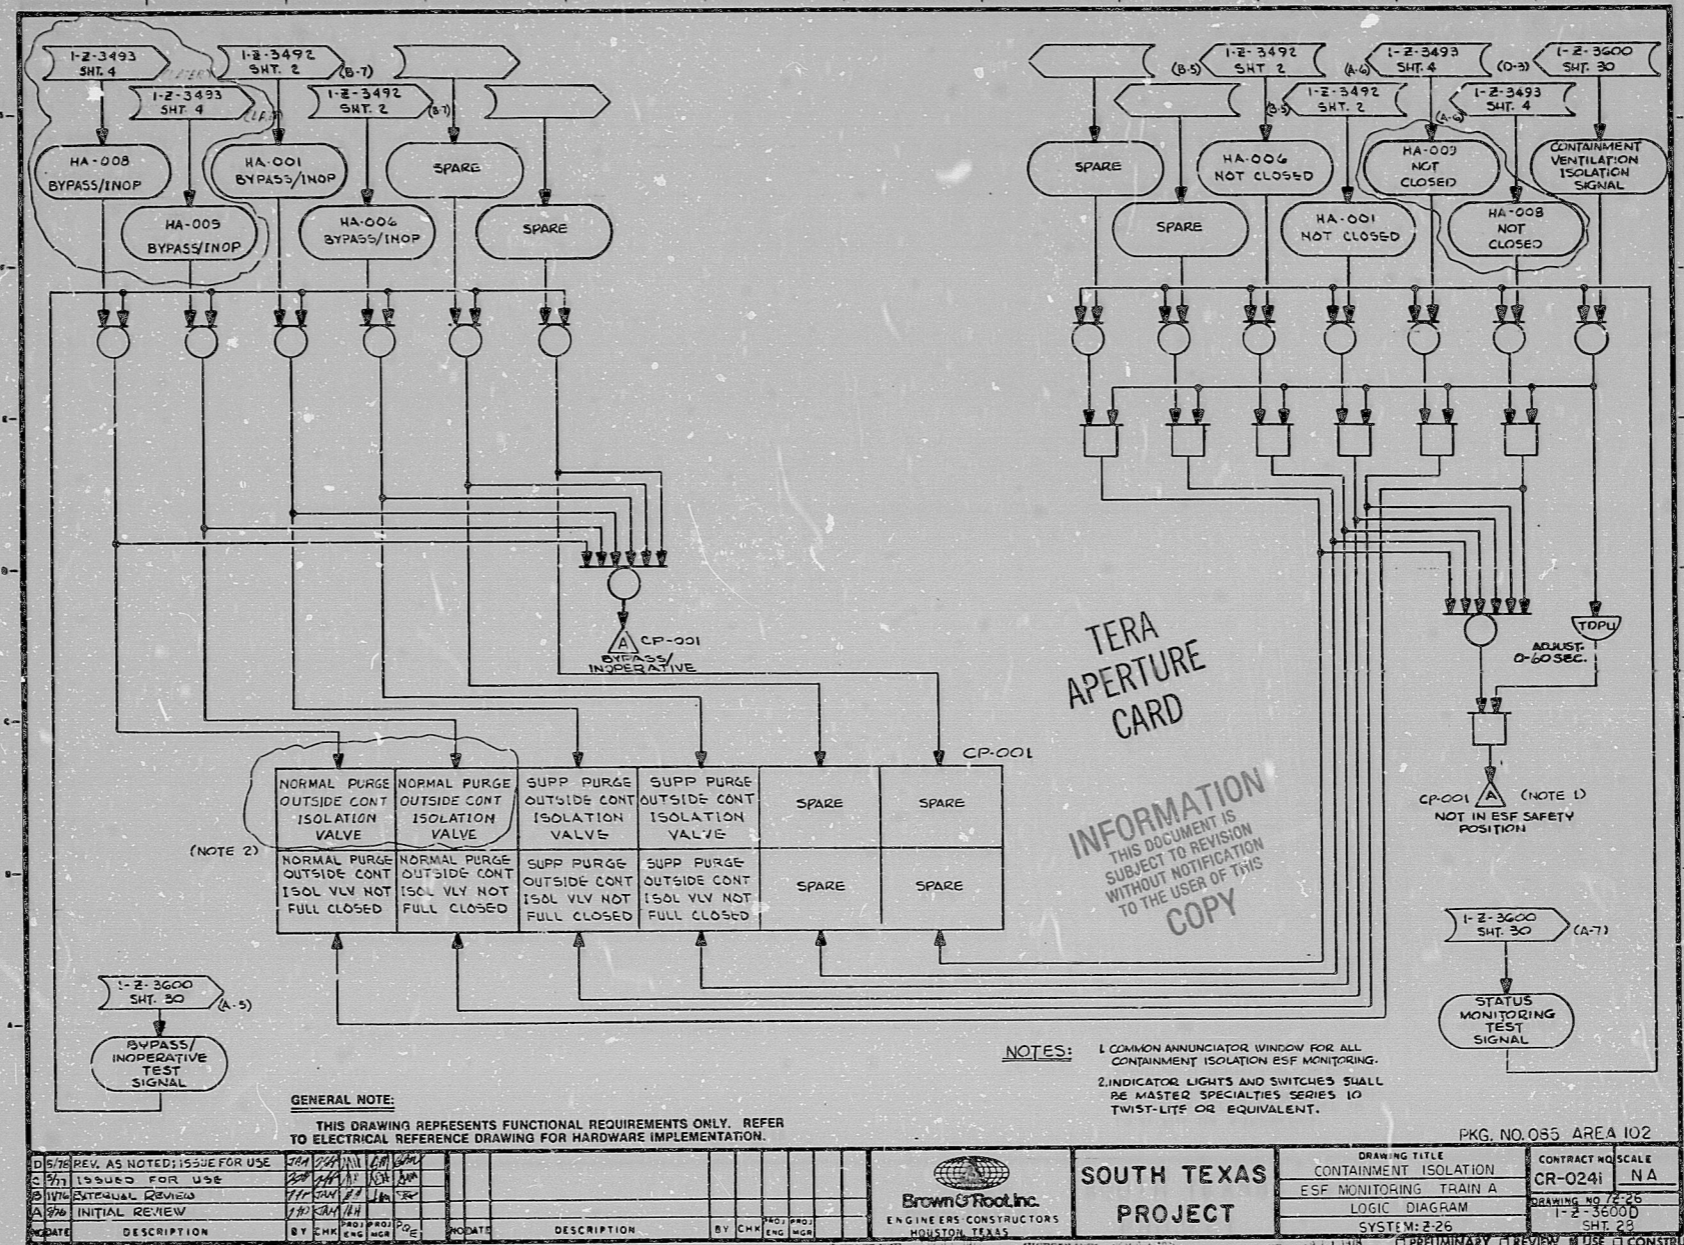

BROWN & ROOT INC.
MICROFILM SERVICES

FRIDAY, JUNE 9 1978

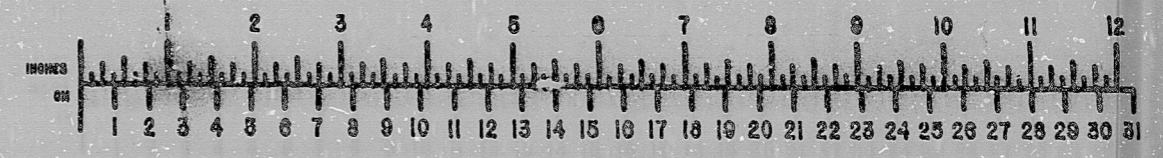

17"

RIDS

8112080276

