


LEGEND:
 [Symbol] BLOCK WALL
 [Symbol] CONSTRUCTION OPENING

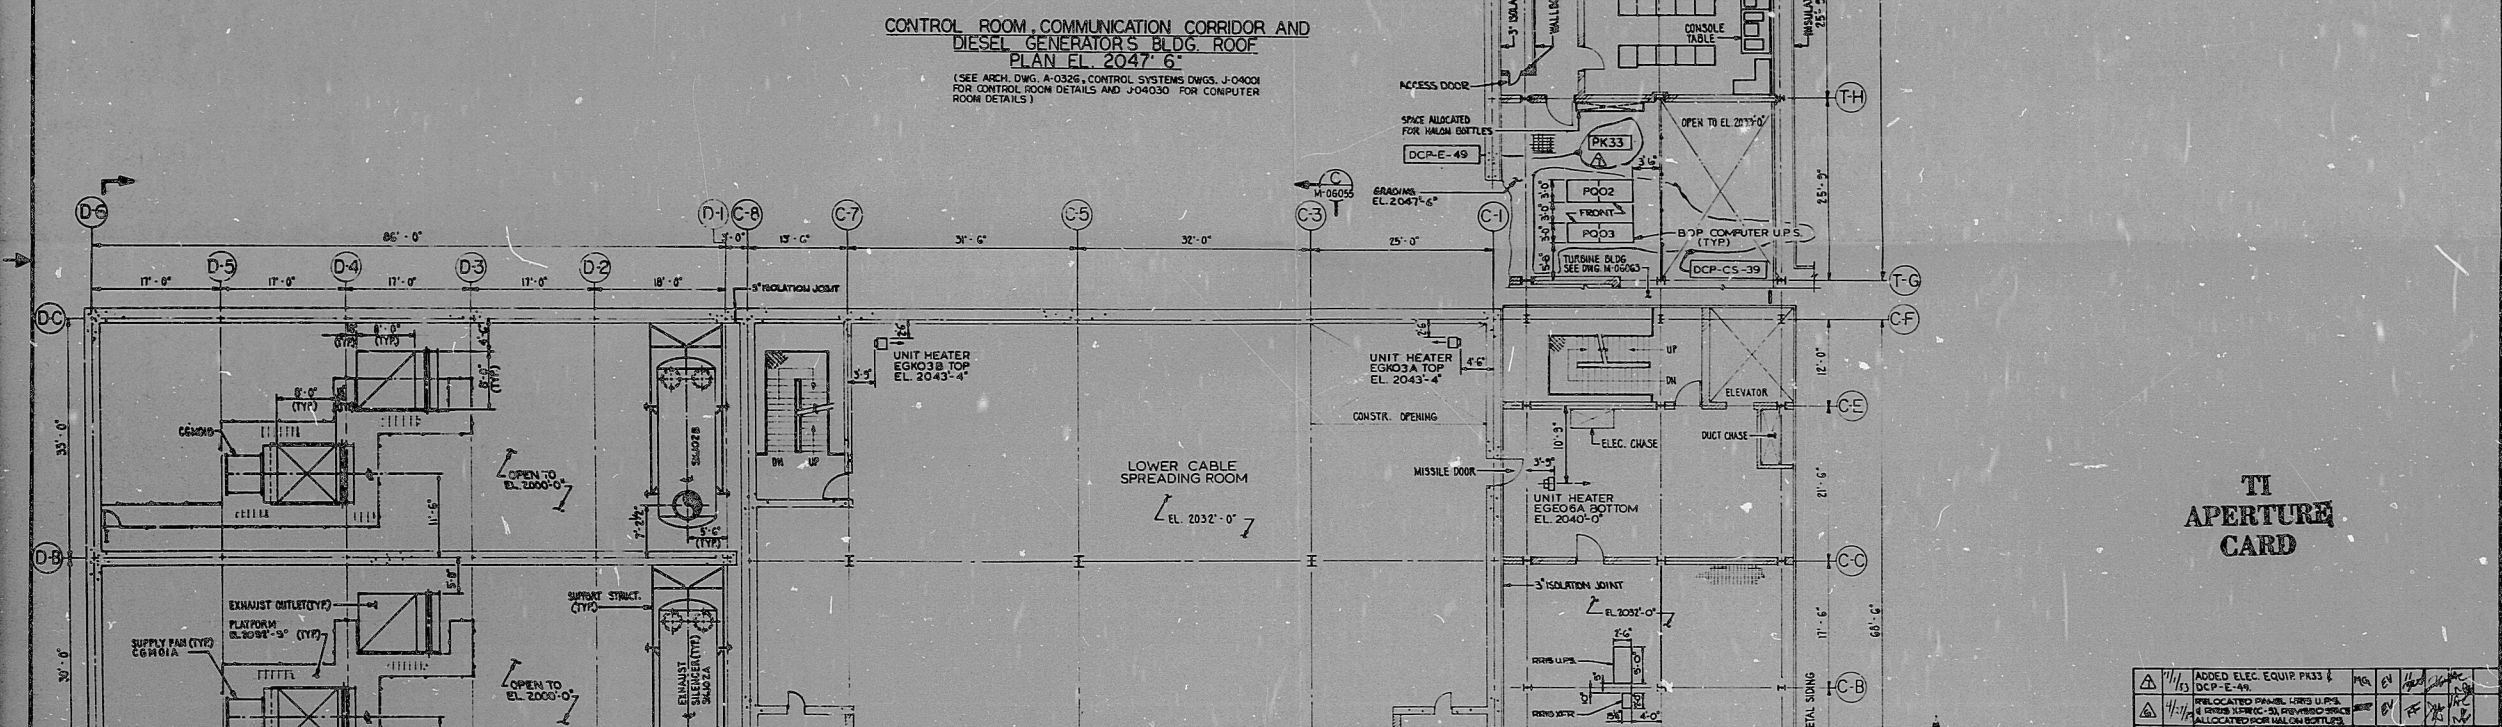

TH APERTURE CARD

NO.	DATE	REVISIONS	BY	CHKD	APP'D
1	11/13	ADDED ELEC. EQUIP. PASS & DCP-E-49	CH	CH	CH
2	11/13	RELOCATED TRAILER CABINETS & RELOCATED FROM MAIN CONTROL BOARD TO COMMUNICATION CORRIDOR	CH	CH	CH
3	11/13	RELOCATED SPACE FOR HALON BOTTLES FROM MAIN CONTROL BOARD TO COMMUNICATION CORRIDOR	CH	CH	CH
4	11/13	RELOCATED SPACE FOR HALON BOTTLES FROM MAIN CONTROL BOARD TO COMMUNICATION CORRIDOR	CH	CH	CH
5	11/13	RELOCATED SPACE FOR HALON BOTTLES FROM MAIN CONTROL BOARD TO COMMUNICATION CORRIDOR	CH	CH	CH

LOWER CABLE SPREADING SEPARATION GROUPS 1, 3 & 5 DIESEL GENERATORS BLDG. EQUIP. ROOM & COMMUNICATION CORRIDOR PLAN EL. 2032'-0"

NO.	DATE	REVISIONS	BY	CHKD	APP'D
1	11/13	ADDED ELEC. EQUIP. PASS & DCP-E-49	CH	CH	CH
2	11/13	RELOCATED TRAILER CABINETS & RELOCATED FROM MAIN CONTROL BOARD TO COMMUNICATION CORRIDOR	CH	CH	CH
3	11/13	RELOCATED SPACE FOR HALON BOTTLES FROM MAIN CONTROL BOARD TO COMMUNICATION CORRIDOR	CH	CH	CH
4	11/13	RELOCATED SPACE FOR HALON BOTTLES FROM MAIN CONTROL BOARD TO COMMUNICATION CORRIDOR	CH	CH	CH
5	11/13	RELOCATED SPACE FOR HALON BOTTLES FROM MAIN CONTROL BOARD TO COMMUNICATION CORRIDOR	CH	CH	CH

BECHTEL
 GAITHERSBURG, MARYLAND

SHUPPS
 EQUIPMENT LOCATIONS
 CONTROL & DIESEL GEN. BLDGS. AND COMM. CORRIDOR PLAN EL. 2032'-0" & EL. 2047'-6"

Job No. 10466
 BECHTEL DRAWING NO. M-06052
 SHEET 7

I certify that the image contained on this frame was made in the normal and regular course of my business, on the date stated below and that it is an accurate reproduction of the document(s) submitted to Micrographics, INC. 7777 W. PARKWAY, Dallas, TEXAS 75247-1000

8410090024

PDR RIDS

