

11


11

8.5"

11

11

8.5"

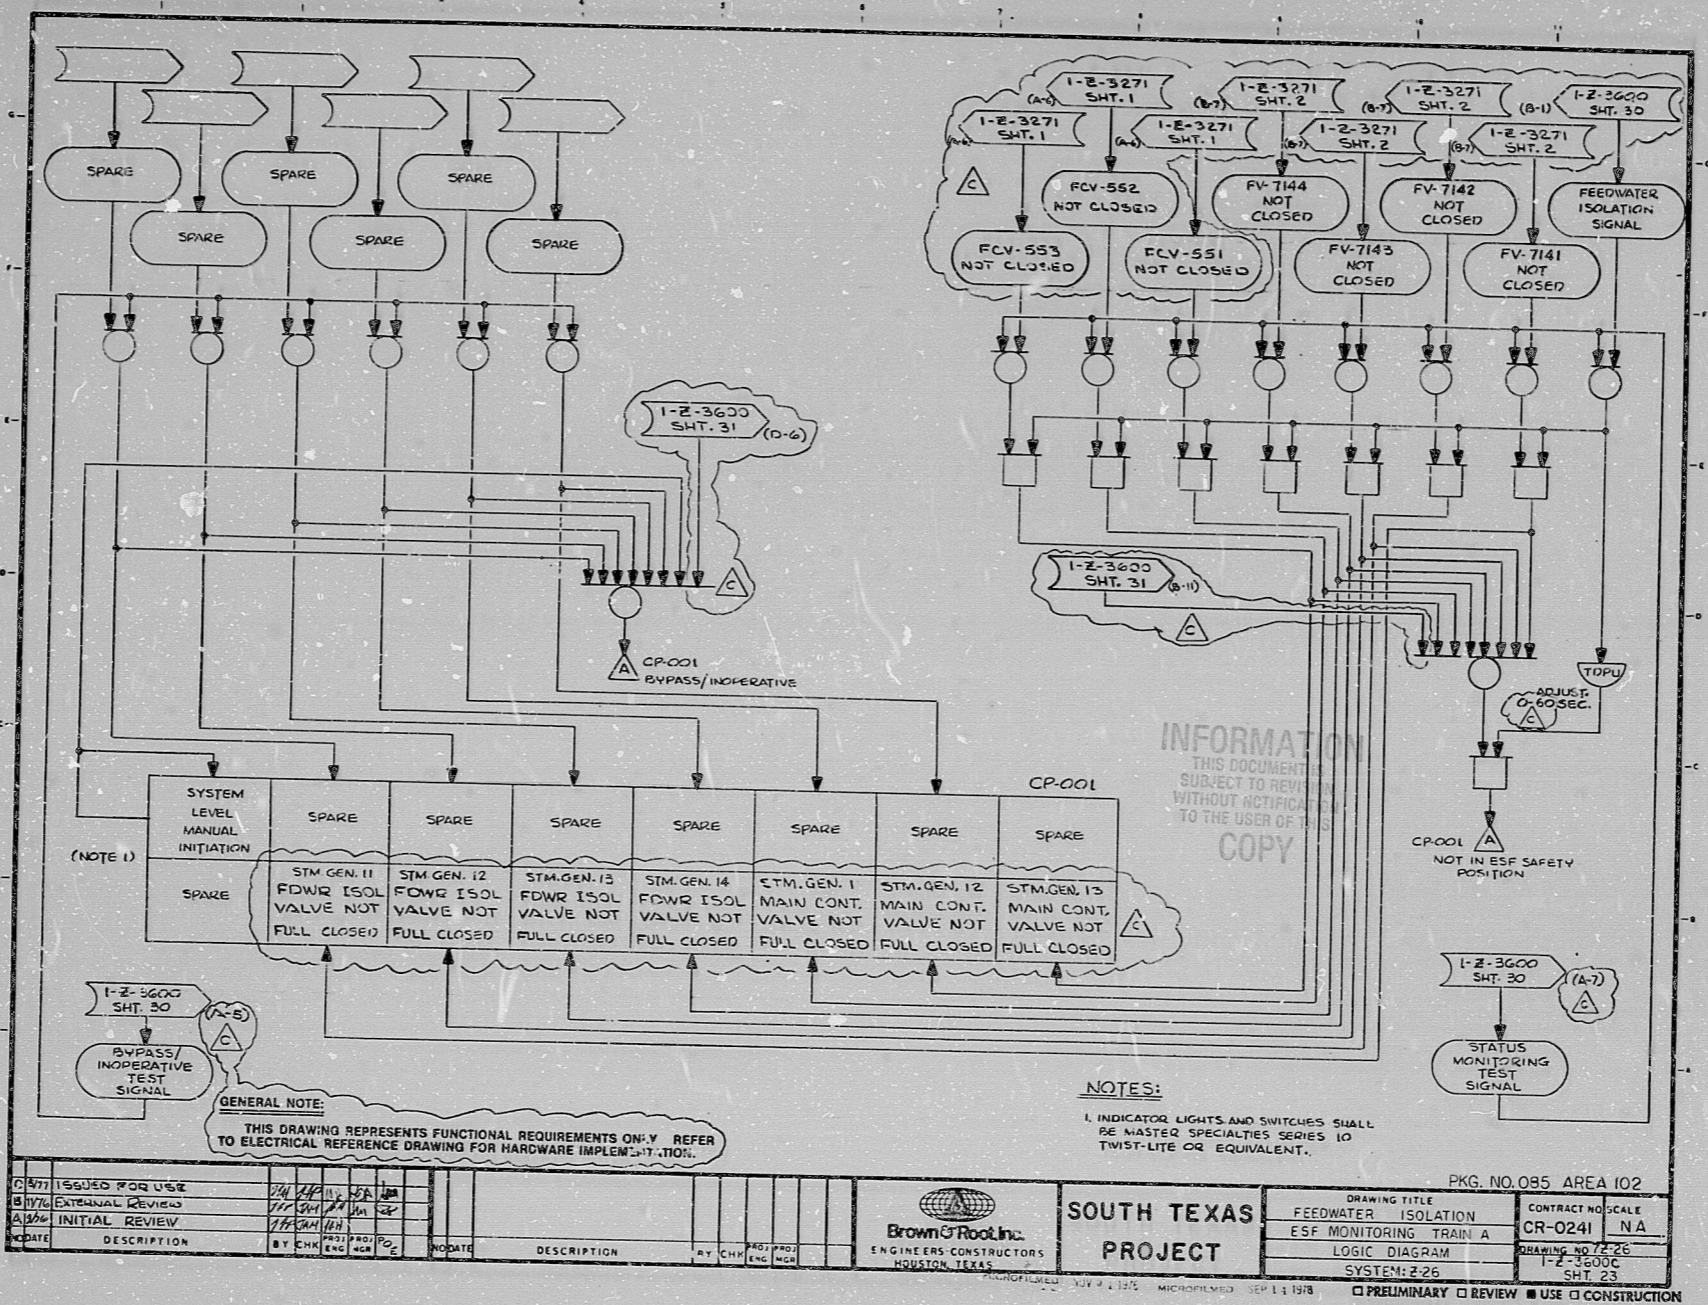

8.5"

11"

8.5"

11"

DATE	DESCRIPTION	BY	CHK	ENG	SCR	DATE	DESCRIPTION	BY	CHK	ENG	SCR
04/11	ISSUED FOR USE	SM	BA	SR	JA						
05/17/76	EXTERNAL REVIEW	SM	BA	SR	JA						
05/24/76	INITIAL REVIEW	SM	BA	SR	JA						

PKG. NO. 095 AREA 102

**Brown & Root Inc.**  
ENGINEERS-CONSTRUCTORS  
HOUSTON, TEXAS

**SOUTH TEXAS PROJECT**

DRAWING TITLE: FEEDWATER ISOLATION  
ESF MONITORING TRAIN A  
LOGIC DIAGRAM  
SYSTEM: Z-26


CONTRACT NO. SCALE: CR-0241 N/A  
DRAWING NO. Z-26  
1-Z-3600C  
SHT. 23

PRELIMINARY  REVIEW  USE  CONSTRUCTION

TERA APERTURE CARD

BROWN & ROOT INC. MICROFILM SERVICES

WEDNESDAY, JUNE 1 1977

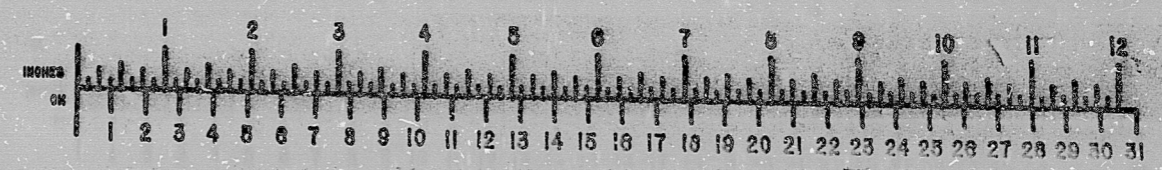

17"

17"

RIDS

8112090187

