



17"
11"
8.5"
11"
17"

17"
11"
8.5"
11"
17"

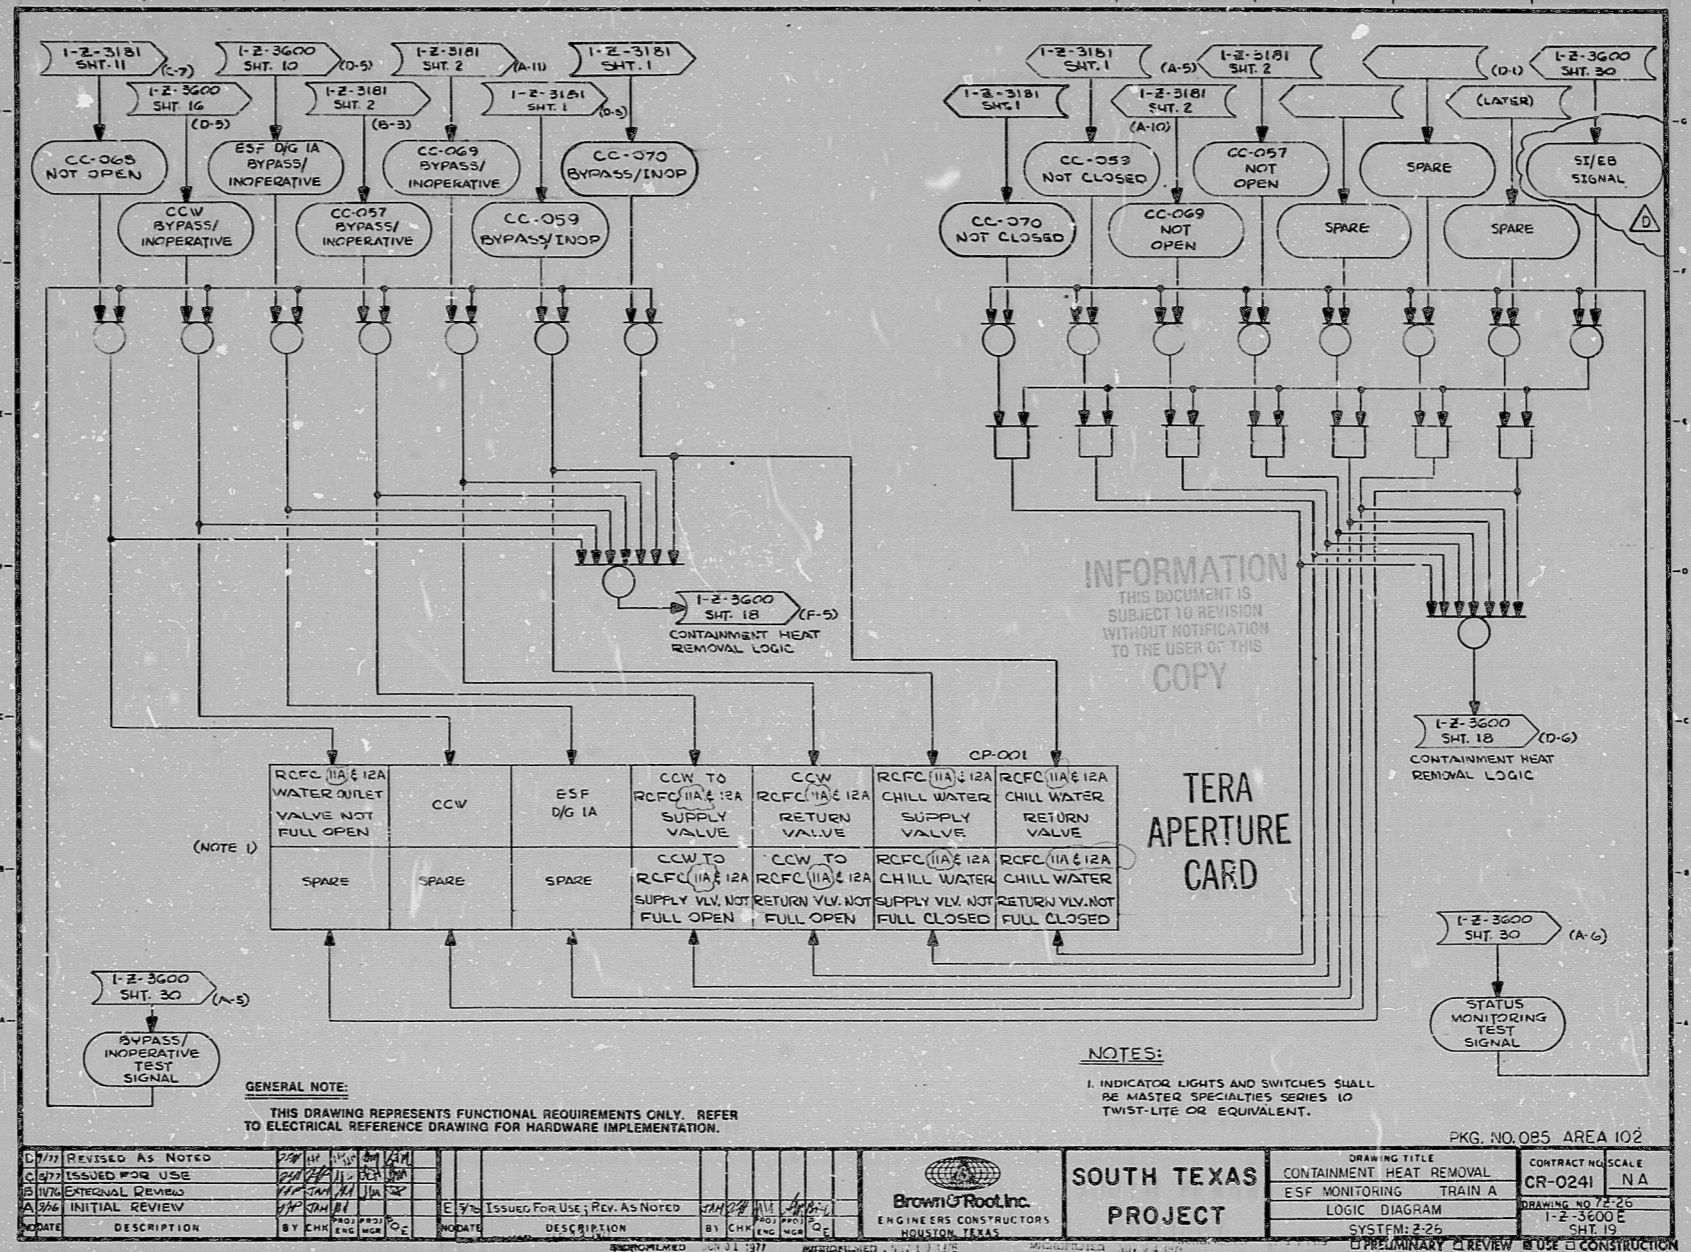

DATE	DESCRIPTION	BY	CHK	ENG	PROJ	DATE	DESCRIPTION	BY	CHK	ENG	PROJ	DATE	DESCRIPTION	BY	CHK	ENG	PROJ
11/26/77	REVISED AS NOTED	11/26/77	ISSUED FOR USE; RCV. AS NOTED	11/26/77

BROWN & ROOT INC.
MICROFILM SERVICES
FRIDAY, JUNE 9 1978

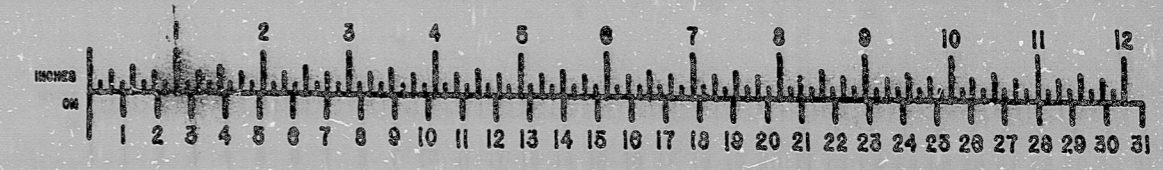

INFORMATION
THIS DOCUMENT IS SUBJECT TO REVISION WITHOUT NOTIFICATION TO THE USER OF THIS COPY

RIDS

8/12090196

