

17"

11"

8.5"

8.5"

11"

17"

17"


11"

8.5"

8.5"


11"

17"

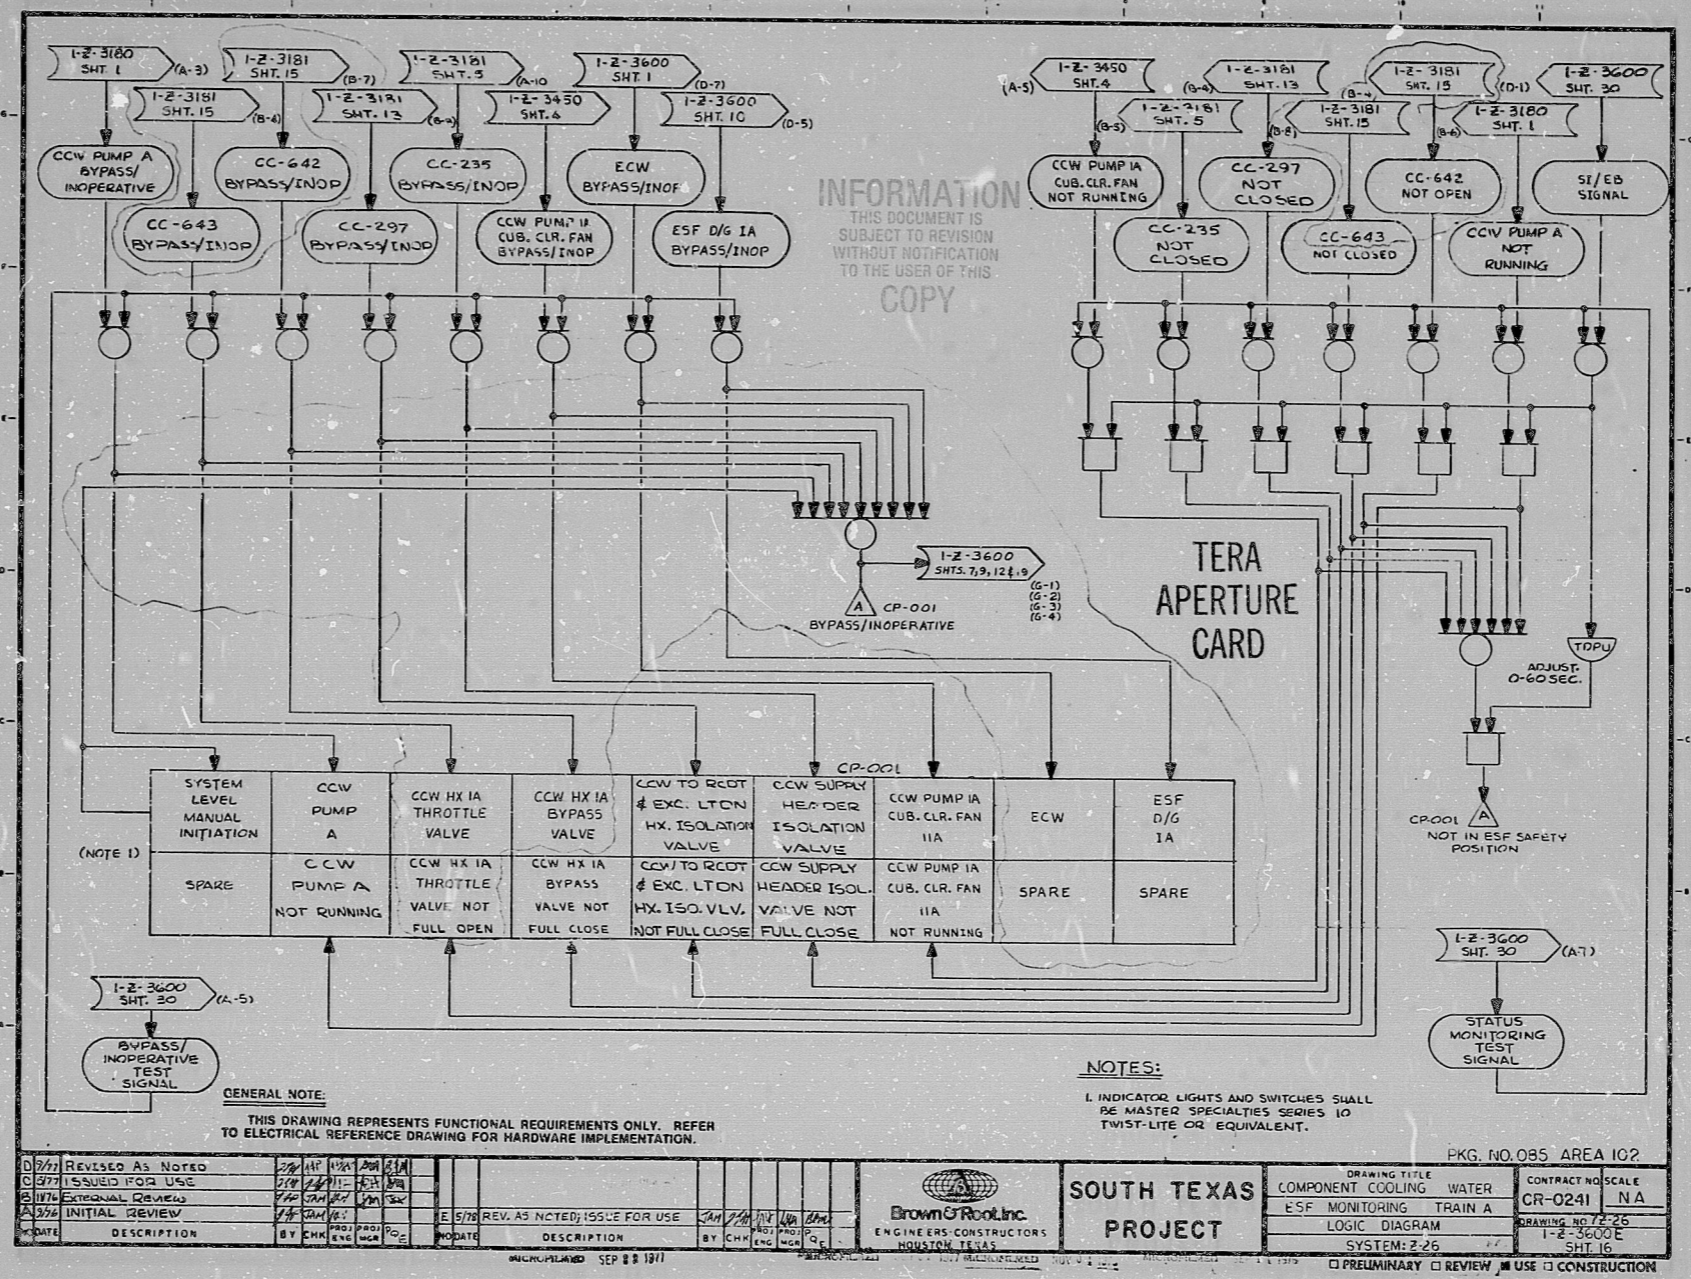

BROWN & ROOT INC. MICROFILM SERVICES

FRIDAY, JUNE 9 1978

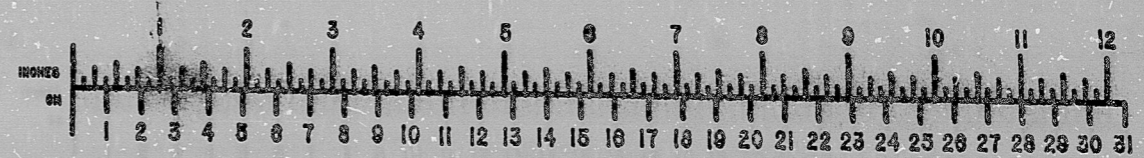

RIDS

8112090202

