




BROWN & ROOT INC.
MICROFILM SERVICES

WEDNESDAY, JUNE 1 1977

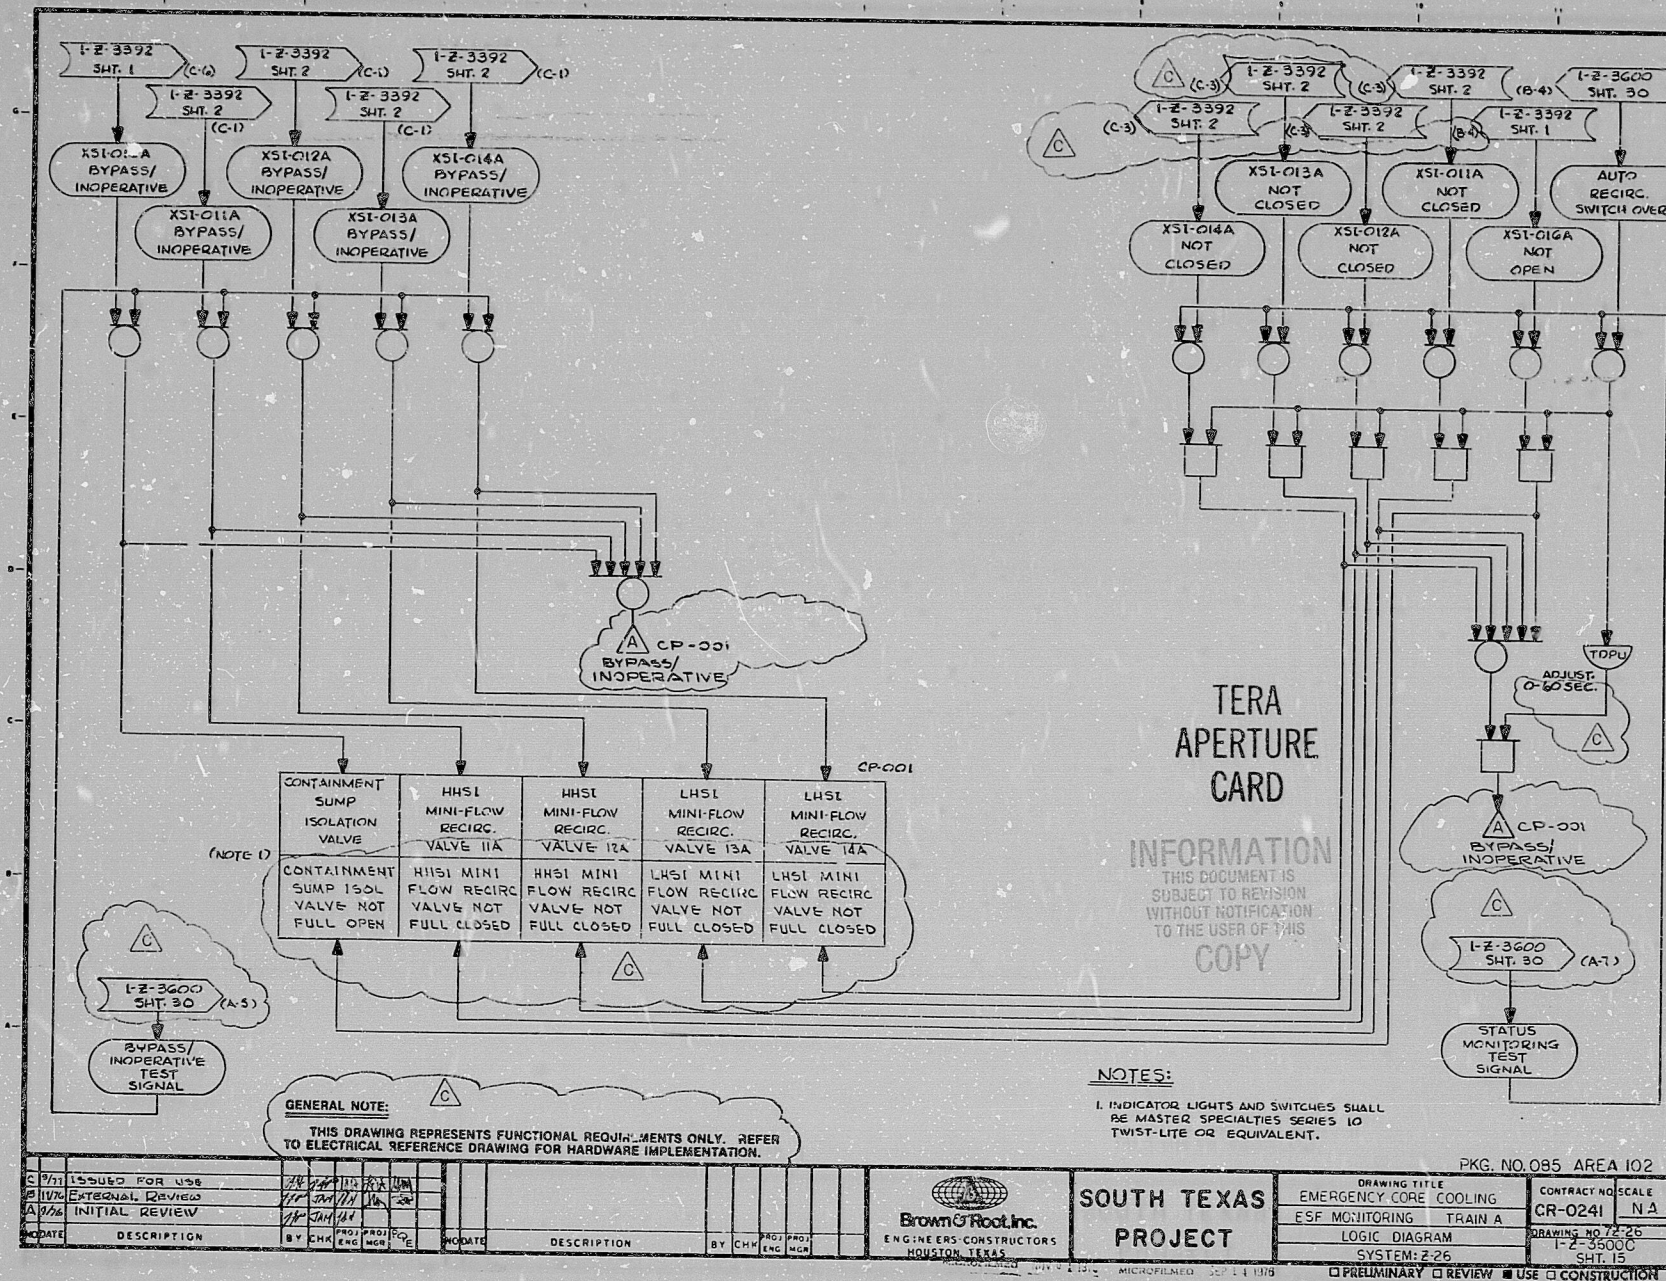

RIDS

8112090205

