

17"

11"

8.5"

8.5"

11"

17"

17"


11"

8.5"

8.5"

11"

17"

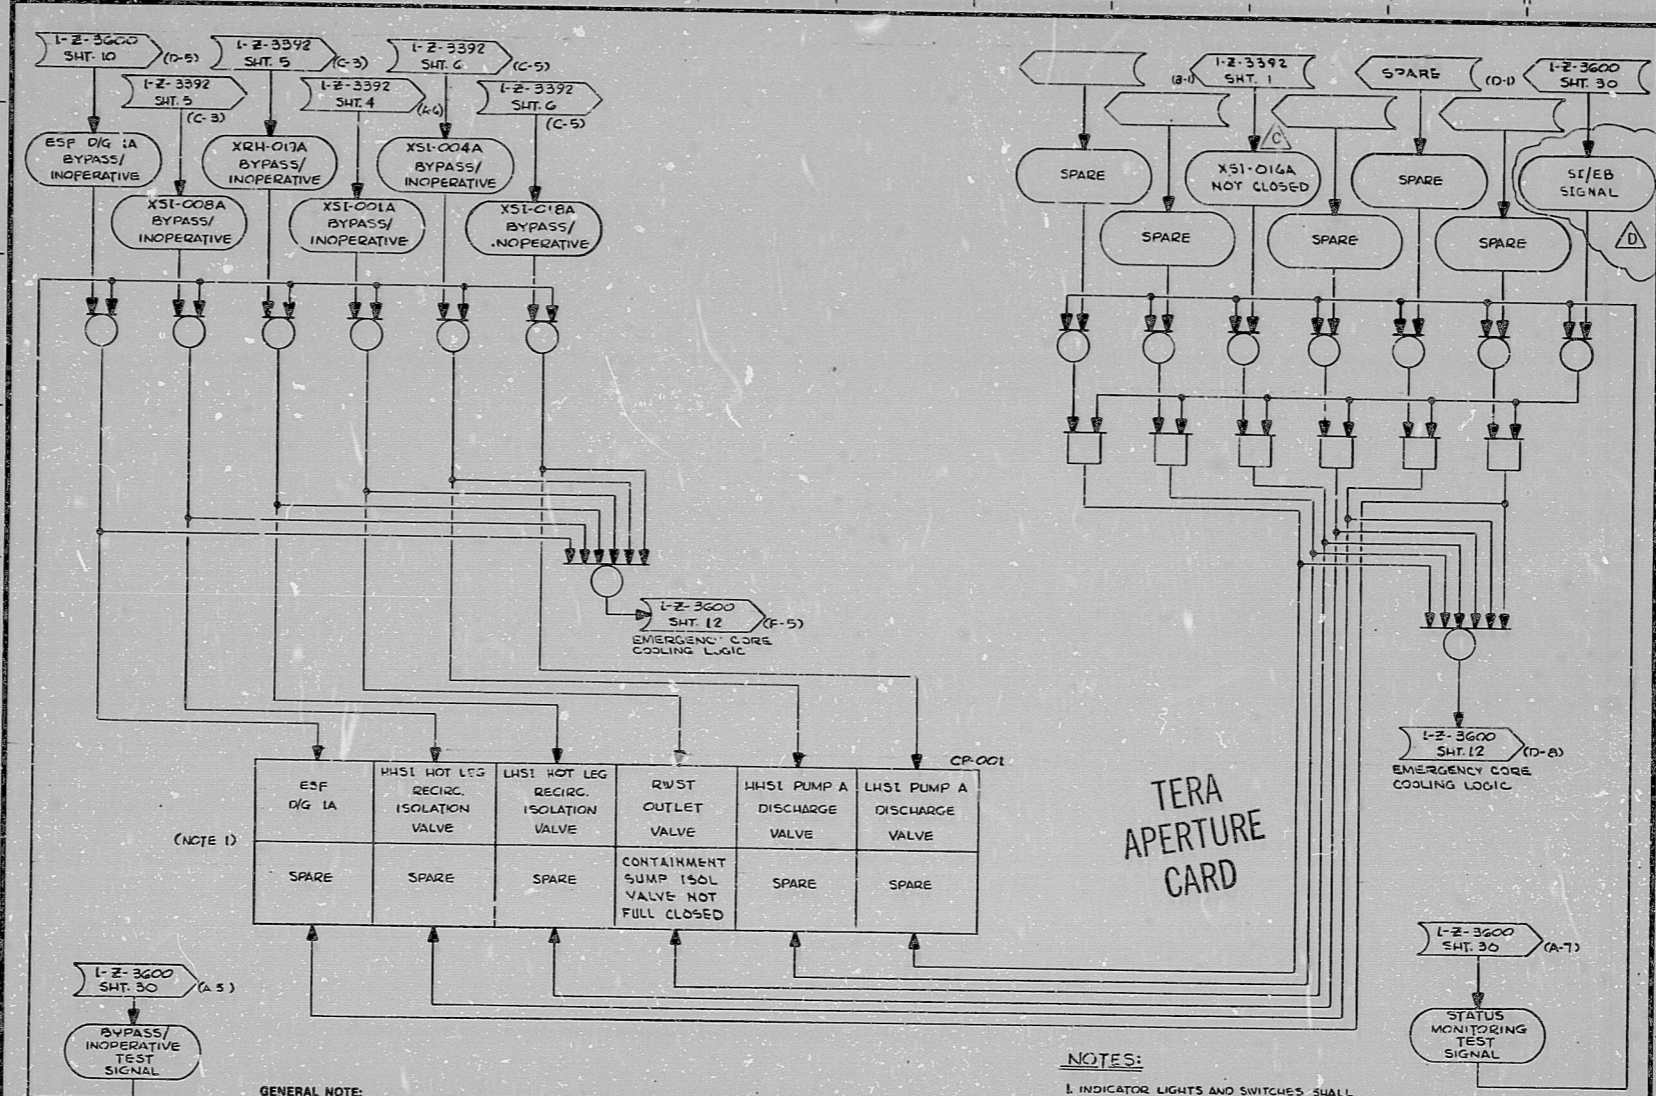

GENERAL NOTE:
THIS DRAWING REPRESENTS FUNCTIONAL REQUIREMENTS ONLY. REFER TO ELECTRICAL REFERENCE DRAWING FOR HARDWARE IMPLEMENTATION.


NOTES:
1. INDICATOR LIGHTS AND SWITCHES SHALL BE MASTEC SPECIALTIES SERIES 10 TWIST-LITE OR EQUIVALENT.

DATE	DESCRIPTION	BY	CHK	ENG	NO	DATE	DESCRIPTION	BY	CHK	ENG	NO
10/27/77	REVISED AS NOTED	JW	WJ	WJ	WJ						
10/27/77	ISSUED FOR USE	JW	WJ	WJ	WJ						
10/27/77	EXTERNAL REVIEW	JW	WJ	WJ	WJ						
10/27/77	INITIAL REVIEW	JW	WJ	WJ	WJ						

PKG. NO. 085 AREA 102
 DRAWING TITLE: EMERGENCY CORE COOLING
 SOUTH TEXAS PROJECT
 ENGINEERS-CONSTRUCTORS HOUSTON, TEXAS
 CONTRACT NO. SCALE: CR-0241 NA
 DRAWING NO. 13-25
 SYSTEM: 2-25
 SHEET: 13 OF 13
 PRELIMINARY REVIEW USE IN CONSTRUCTION

BROWN & ROOT INC.
 MICROFILM SERVICES

THURSDAY, SEPT. 22 1977

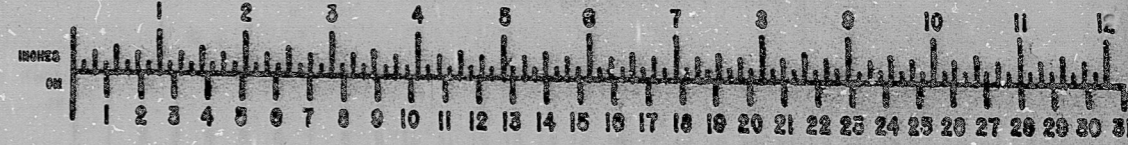

INFORMATION
 THIS DOCUMENT IS
 SUBJECT TO REVISION
 WITHOUT NOTIFICATION
 TO THE USER OF THIS
 COPY

RIDS

812090210

