


11
8.5
11
8.5
17

11
8.5
11
8.5
17

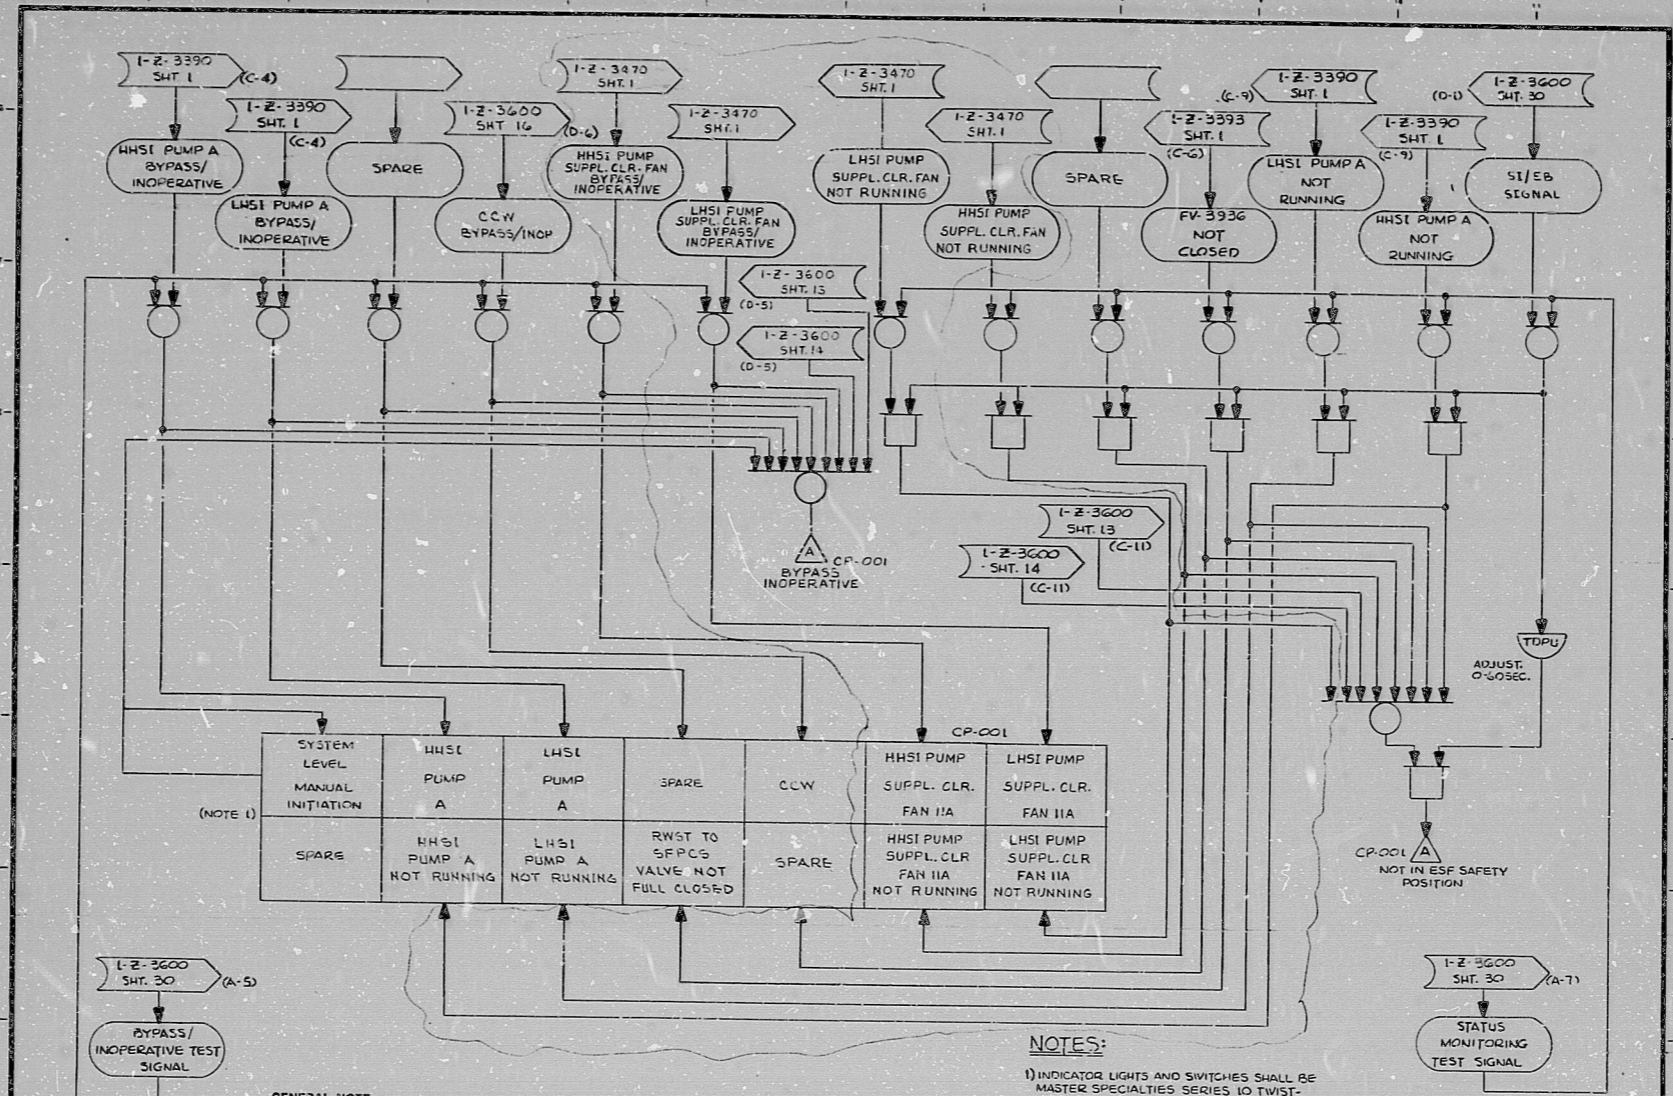

GENERAL NOTE:
THIS DRAWING REPRESENTS FUNCTIONAL REQUIREMENTS ONLY. REFER TO ELECTRICAL REFERENCE DRAWING FOR HARDWARE IMPLEMENTATION.

NOTES:
1) INDICATOR LIGHTS AND SWITCHES SHALL BE MASTER SPECIALTIES SERIES 10 TWIST-LITE OR EQUIVALENT.

DATE	DESCRIPTION	BY	CHK	PROJ	ENGR	DATE	DESCRIPTION	BY	CHK	PROJ	ENGR

PKG. NO. 085 AREA 102

DRAWING TITLE	CONTRACT NO	SCALE
EMERGENCY CORE COOLING	CR-0241	NA
ESF MONITORING TRAIN A		
LOGIC DIAGRAM	DRAWING NO. 2-26	
SYSTEM: 2-26	12-3600 E	
	SHT. 12	


PRELIMINARY □ REVIEW ■ USE □ CONSTRUCTION

TERA APERTURE CARD

INFORMATION
THIS DOCUMENT IS
SUBJECT TO REVISION
WITHOUT NOTIFICATION
TO THE USER OF THIS
COPY

BROWN & ROOT INC.
MICROFILM SERVICES

FRIDAY, JUNE 9 1978

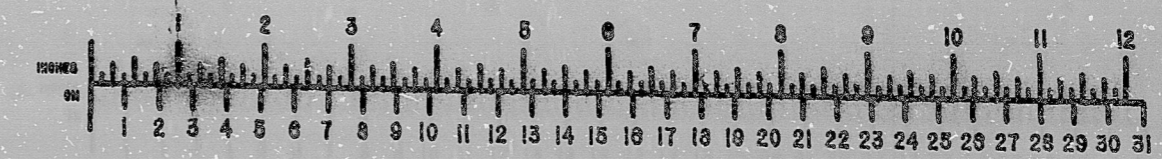

RIDS

8/2090212

