

11

11

8.5

8.5

11

17

11


11

8.5

8.5

11

17

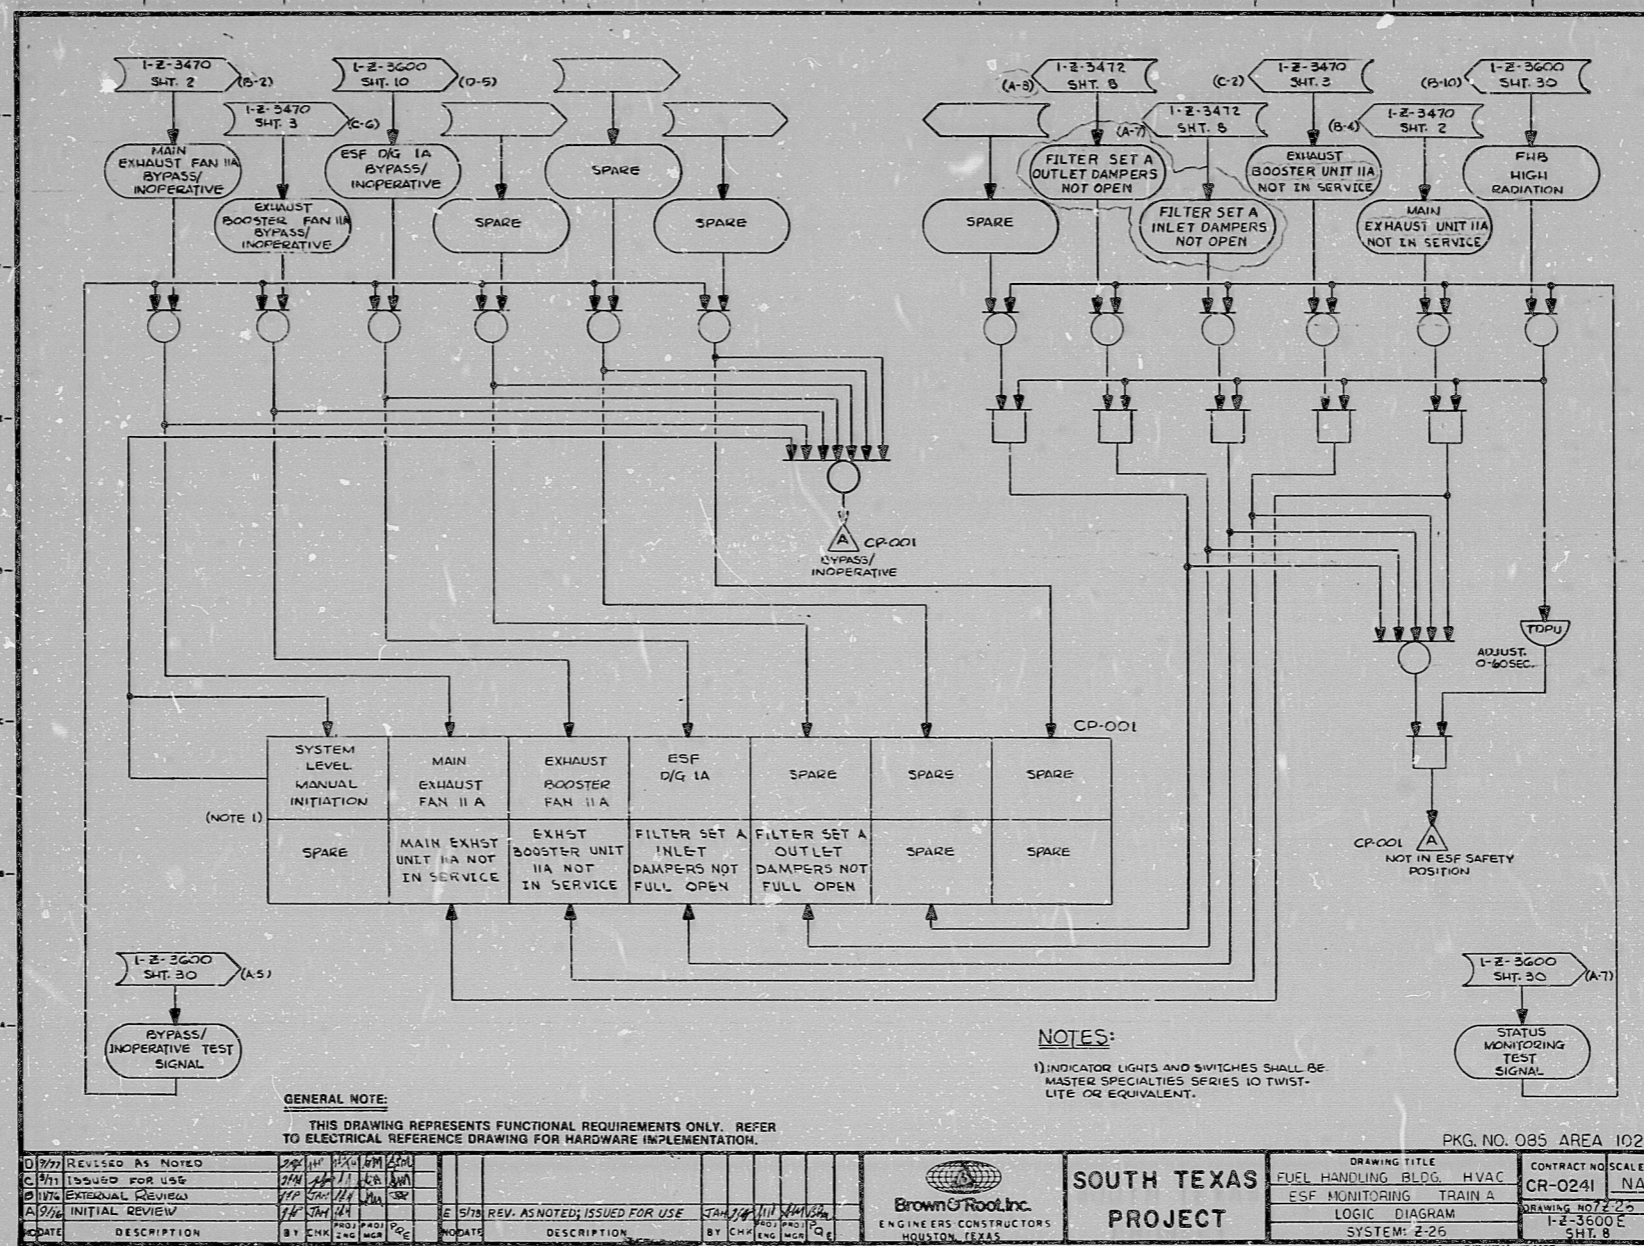

REVISED AS NOTED	ISSUED FOR USE	EXTERNAL REVIEW	INITIAL REVIEW	DATE	DESCRIPTION	BY	CHK	APP	PG	DATE	DESCRIPTION	BY	CHK	APP	PG

Brown & Root Inc.
ENGINEERS, CONSTRUCTORS
HOUSTON, TEXAS

SOUTH TEXAS PROJECT

DRAWING TITLE: FUEL HANDLING BLDG. HVAC
ESF MONITORING TRAIN A
LOGIC DIAGRAM
SYSTEM: Z-25

CONTRACT NO: CR-0241
SCALE: NA
DRAWING NO: Z-25
I-Z-3600 E SHT. 8


PRELIMINARY REVIEW USE IN CONSTRUCTION

TERA APERTURE CARD

INFORMATION THIS DOCUMENT IS SUBJECT TO REVISION WITHOUT NOTIFICATION TO THE USER OF THIS COPY

BROWN & ROOT INC. MICROFILM SERVICES

FRIDAY, JUNE 9 1978

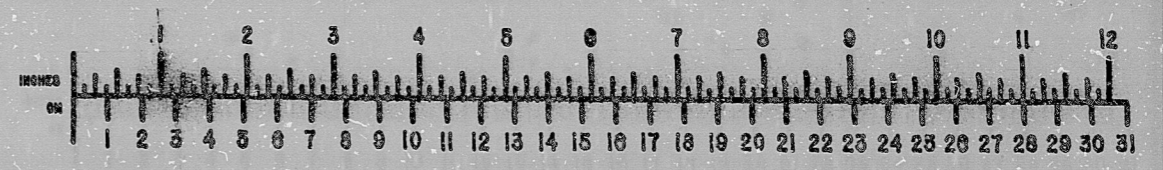

RIDS

812090231

