


8.5"
11"
17"

8.5"
11"
17"

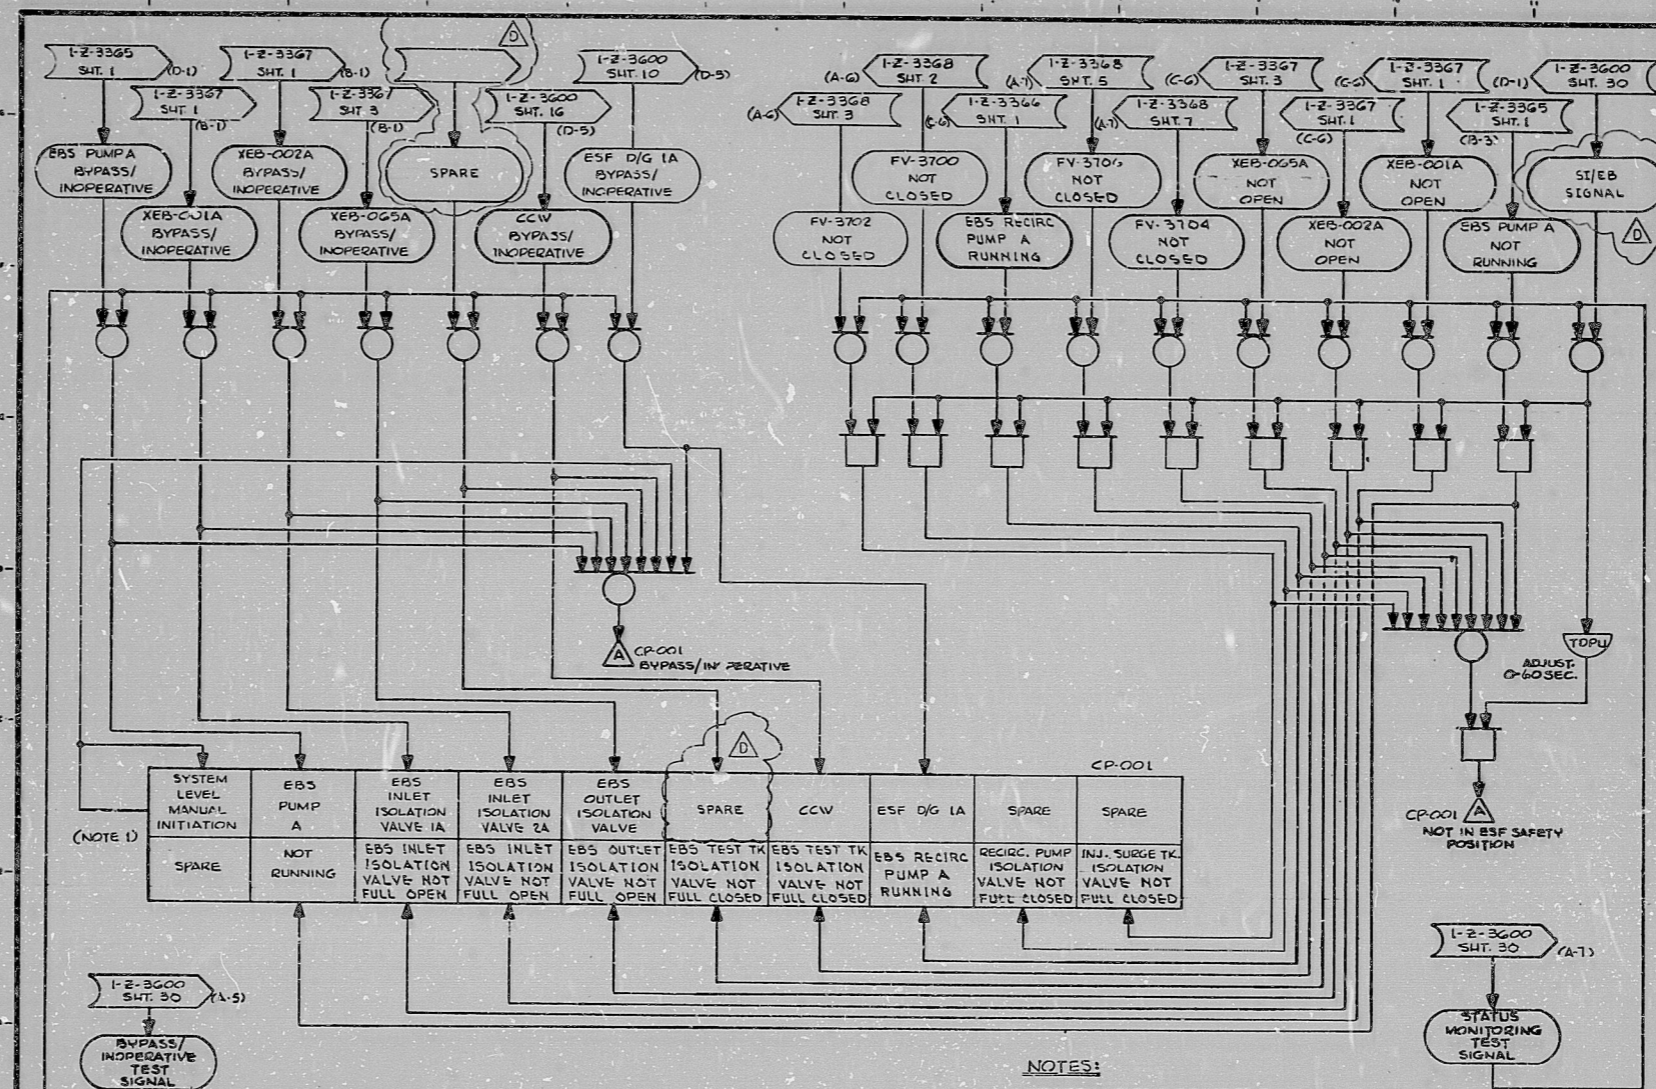

GENERAL NOTE:
THIS DRAWING REPRESENTS FUNCTIONAL REQUIREMENTS ONLY. REFER TO ELECTRICAL REFERENCE DRAWING FOR HARDWARE IMPLEMENTATION.

NOTES:
1. INDICATOR LIGHTS AND SWITCHES SHALL BE MASTER SPECIALTIES SERIES 10 TWIST-LITE OR EQUIVALENT.

PKG. NO. 085 AREA 102

DATE	DESCRIPTION	BY	CHK	REV	PROJ	ENC	LOC
10/27/77	REVISED AS NOTED
10/28/77	ISSUED FOR USE
10/28/77	EXTERNAL REVIEW
10/28/77	INITIAL REVIEW

BROWN & ROOT INC.
ENGINEERS CONSTRUCTORS
HOUSTON, TEXAS

SOUTH TEXAS PROJECT


DRAWING TITLE: EMERGENCY BORATION
ESF MONITORING TRAIN A
LOGIC DIAGRAM
SYSTEM: 2-26

CONTRACT NO. SCALE: CR-0241 N/A
DRAWING NO. 26-25
1-2-3600 D
SHT. 7

□ PRELIMINARY □ REVIEW □ USE □ CONSTRUCTION

BROWN & ROOT INC.
MICROFILM SERVICES

THURSDAY, SEPT. 23 1977

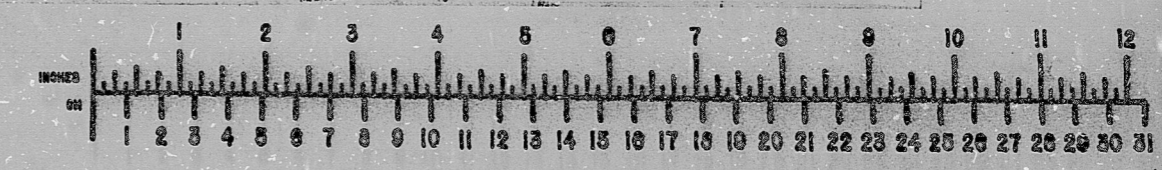

TERA APERTURE CARD

INFORMATION
THIS DOCUMENT IS
SUBJECT TO REVISION
WITHOUT NOTIFICATION
TO THE USER OF THIS
COPY

RIDS

8112090235

