


17  
11  
8.5  
8.5  
11  
17

17  
11  
8.5  
8.5  
11  
17

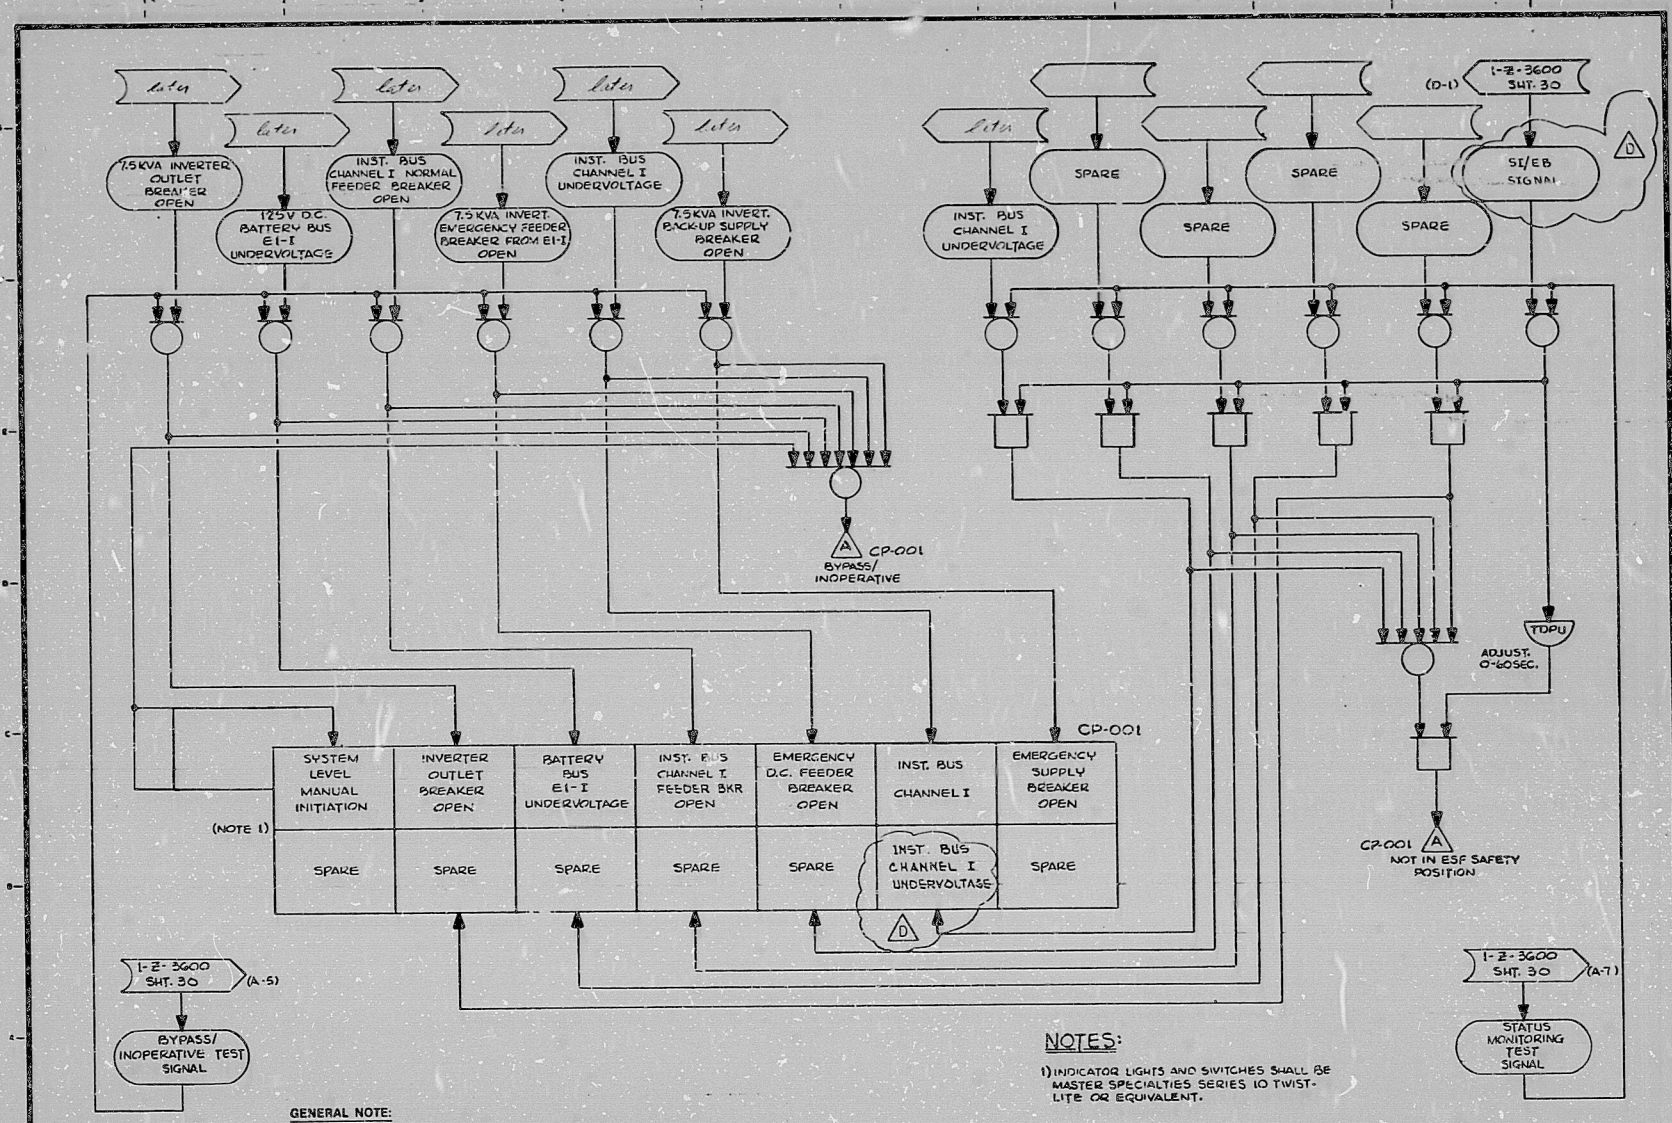

**GENERAL NOTE:**  
THIS DRAWING REPRESENTS FUNCTIONAL REQUIREMENTS ONLY. REFER TO ELECTRICAL REFERENCE DRAWING FOR HARDWARE IMPLEMENTATION.

**NOTES:**  
1) INDICATOR LIGHTS AND SWITCHES SHALL BE MASTER SPECIALTIES SERIES 10 TWIST-LITE OR EQUIVALENT.

PKG. NO. 085 AREA 102

REVISED AS NOTED	DATE	BY	DESCRIPTION
ISSUED FOR USE			
EXTERNAL REVIEW			
INITIAL REVIEW			
DATE			

**BROWN & ROOT INC.**  
ENGINEERS CONSTRUCTORS  
HOUSTON, TEXAS


**SOUTH TEXAS PROJECT**

DRAWING TITLE: UNINTERRUPTED POWER SUPPLY CH1  
ESP MONITORING - TRAIN A  
LOGIC - DIAGRAM  
SYSTEM: 2-25  
SHEET: 5

CONTRACT NO. SCALE: CR-0241 NA  
DRAWING NO. 77-26  
I-2-3600  
SHT. 5

PRELIMINARY REVIEW USE CONSTRUCTION

**BROWN & ROOT INC.**  
MICROFILM SERVICES  
THURSDAY, SEPT. 22 1977

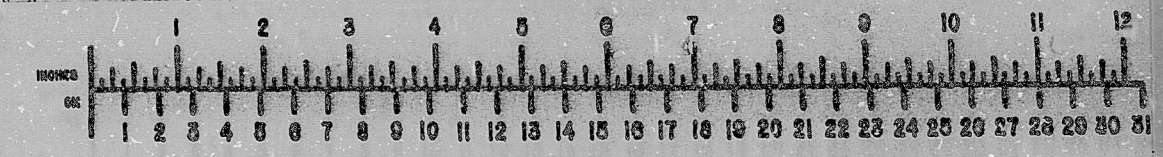

TERA APERTURE CARD  
INFORMATION  
THIS DOCUMENT IS SUBJECT TO REVISION WITHOUT NOTIFICATION TO THE USER OF THIS COPY



RIDS

81120910243

