


69090-W

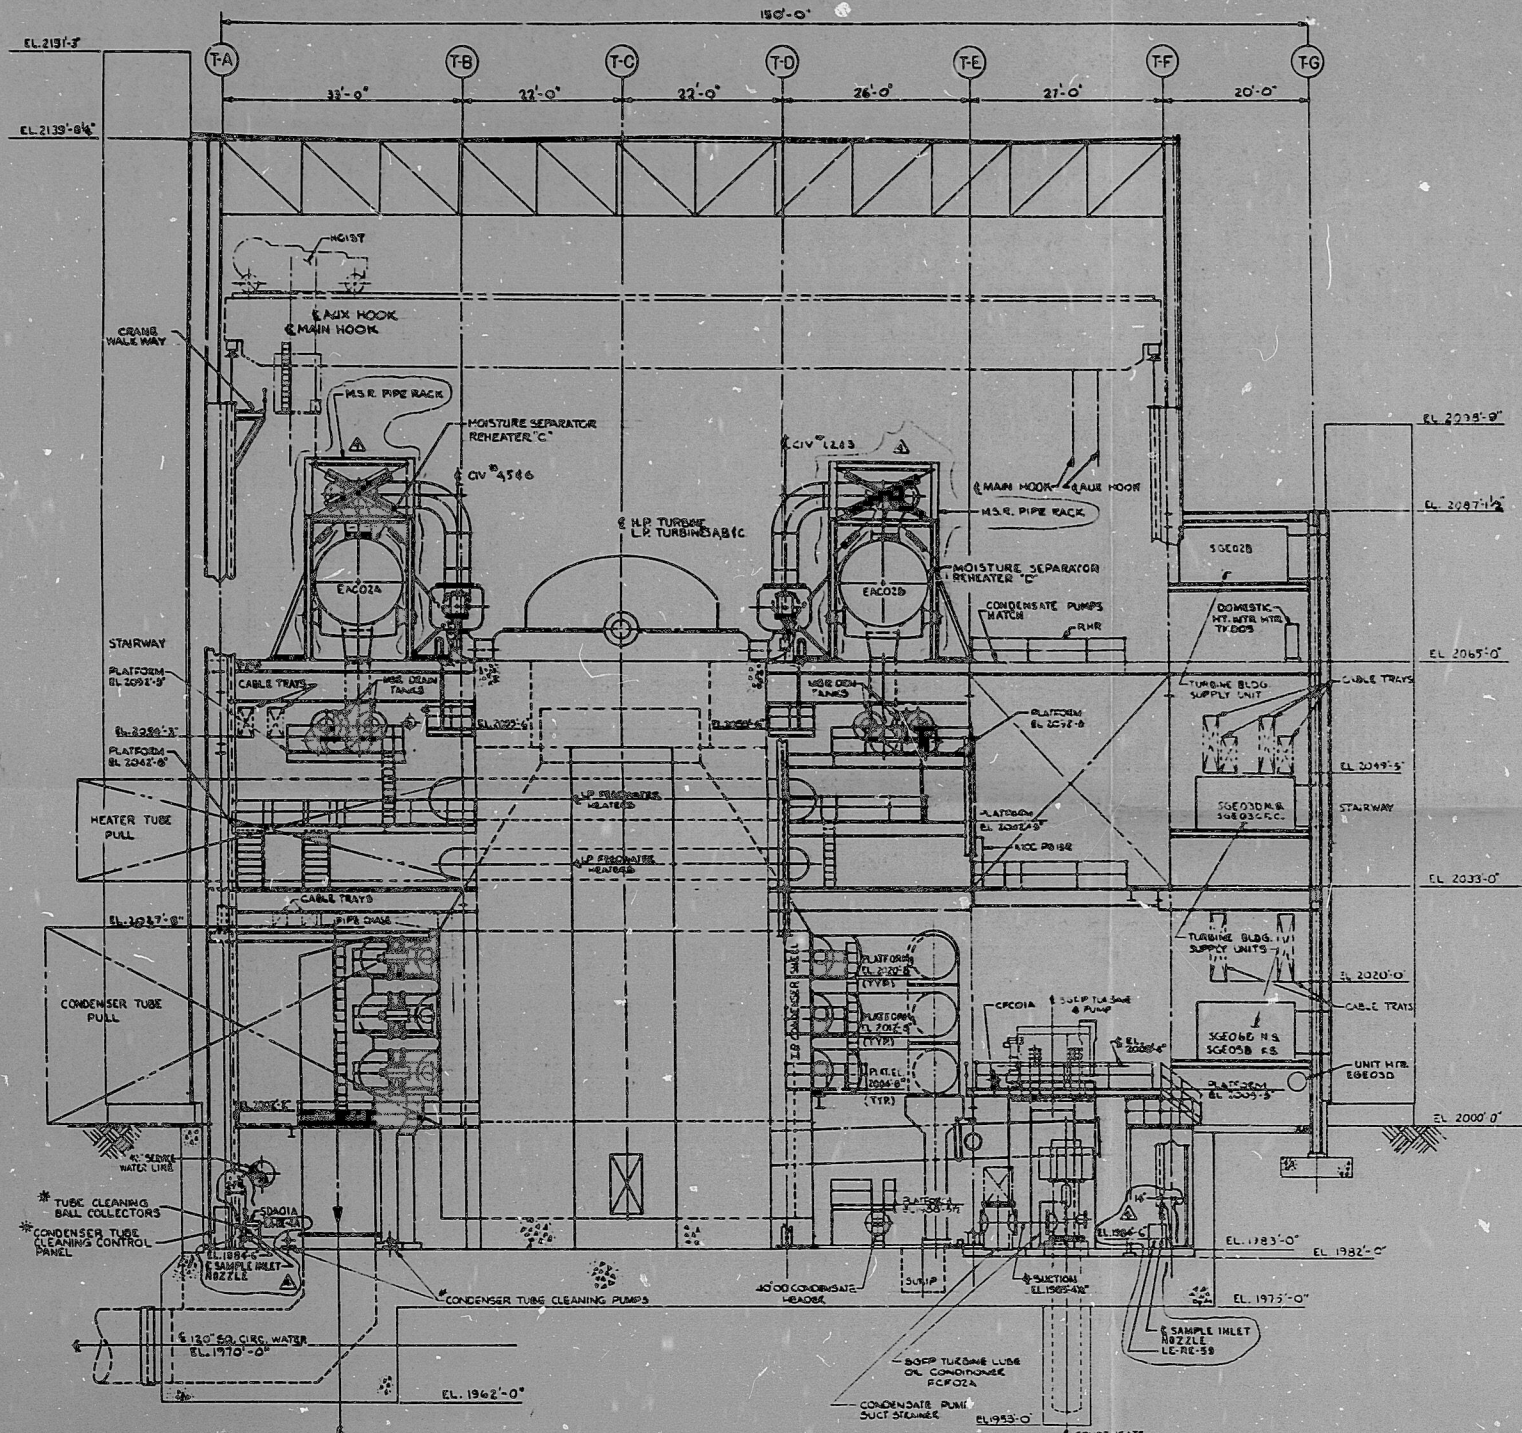

GENERAL NOTES
 * PROVISION FOR FUTURE CONDENSER TUBE CLEANING EQUIPMENT.

TI
 APERTURE
 CARD

SECTION E
 LOOKING SOUTH
 (SEE DAYS M-08080
 THRU M-08084)

NOTICE: ALL ALTERATIONS OF THIS DOCUMENT BY ANY PERSON OTHER THAN A LICENSED PROFESSIONAL ENGINEER OR A PERSON ACTING UNDER HIS OR HER DIRECTOR IS ILLEGAL.
 THE UNDERSIGNED, I HEREBY DISCLAIM ANY RESPONSIBILITY FOR ANY PLANS, SPECIFICATIONS, REPORTS, REVISIONS, REVIEWS OR OTHER DOCUMENTS OR INSTRUMENTS RELATING TO OR INTENDED TO BE USED FOR ANY PART OR PARTS OF THE WORKING PROJECT FOR OR IN CONNECTION WITH WHICH THIS DOCUMENT IS BEING USED IN ANY MANNER, UNLESS SUCH DOCUMENTS, SPECIFICATIONS, REPORTS, REVIEWS, REVISED DOCUMENTS OR INSTRUMENTS BEAR THE SIGNATURE AND THE SEAL OF THE UNDERSIGNED.

| NO. | DATE | REVISIONS | BY | CHKD. | APP'D. |
|-----|------|-----------|----|-------|--------|
| | | | | | |
| | | | | | |
|-------------------------------|--|--|--|--|--|
| REVISIONS TO AGREE WITH PLANS | | | | | |
| REVISIONS TO AGREE WITH PLANS | | | | | |
BECHTEL
 OAKRIDGE, MARYLAND

SNUPPS
 EQUIPMENT LOCATION
 TURBINE BUILDING
 SECTION E

SCALE: 3/4" = 1'-0" (DATE 7-7-75) (DESIGNED) (DRAWN) (E.S.)

NO. 10466
 DATE 7-7-75
 REVISIONS
 BY CHM
 CHECKED BY
 APPROVED BY

REVIEW LEVEL 1

I certify that the design contained on this form was made in the normal and regular course of business on the date stated herein and that it is an accurate representation of the design submitted to the appropriate authority.

8410090063

PDR RIDS

