


M-06072

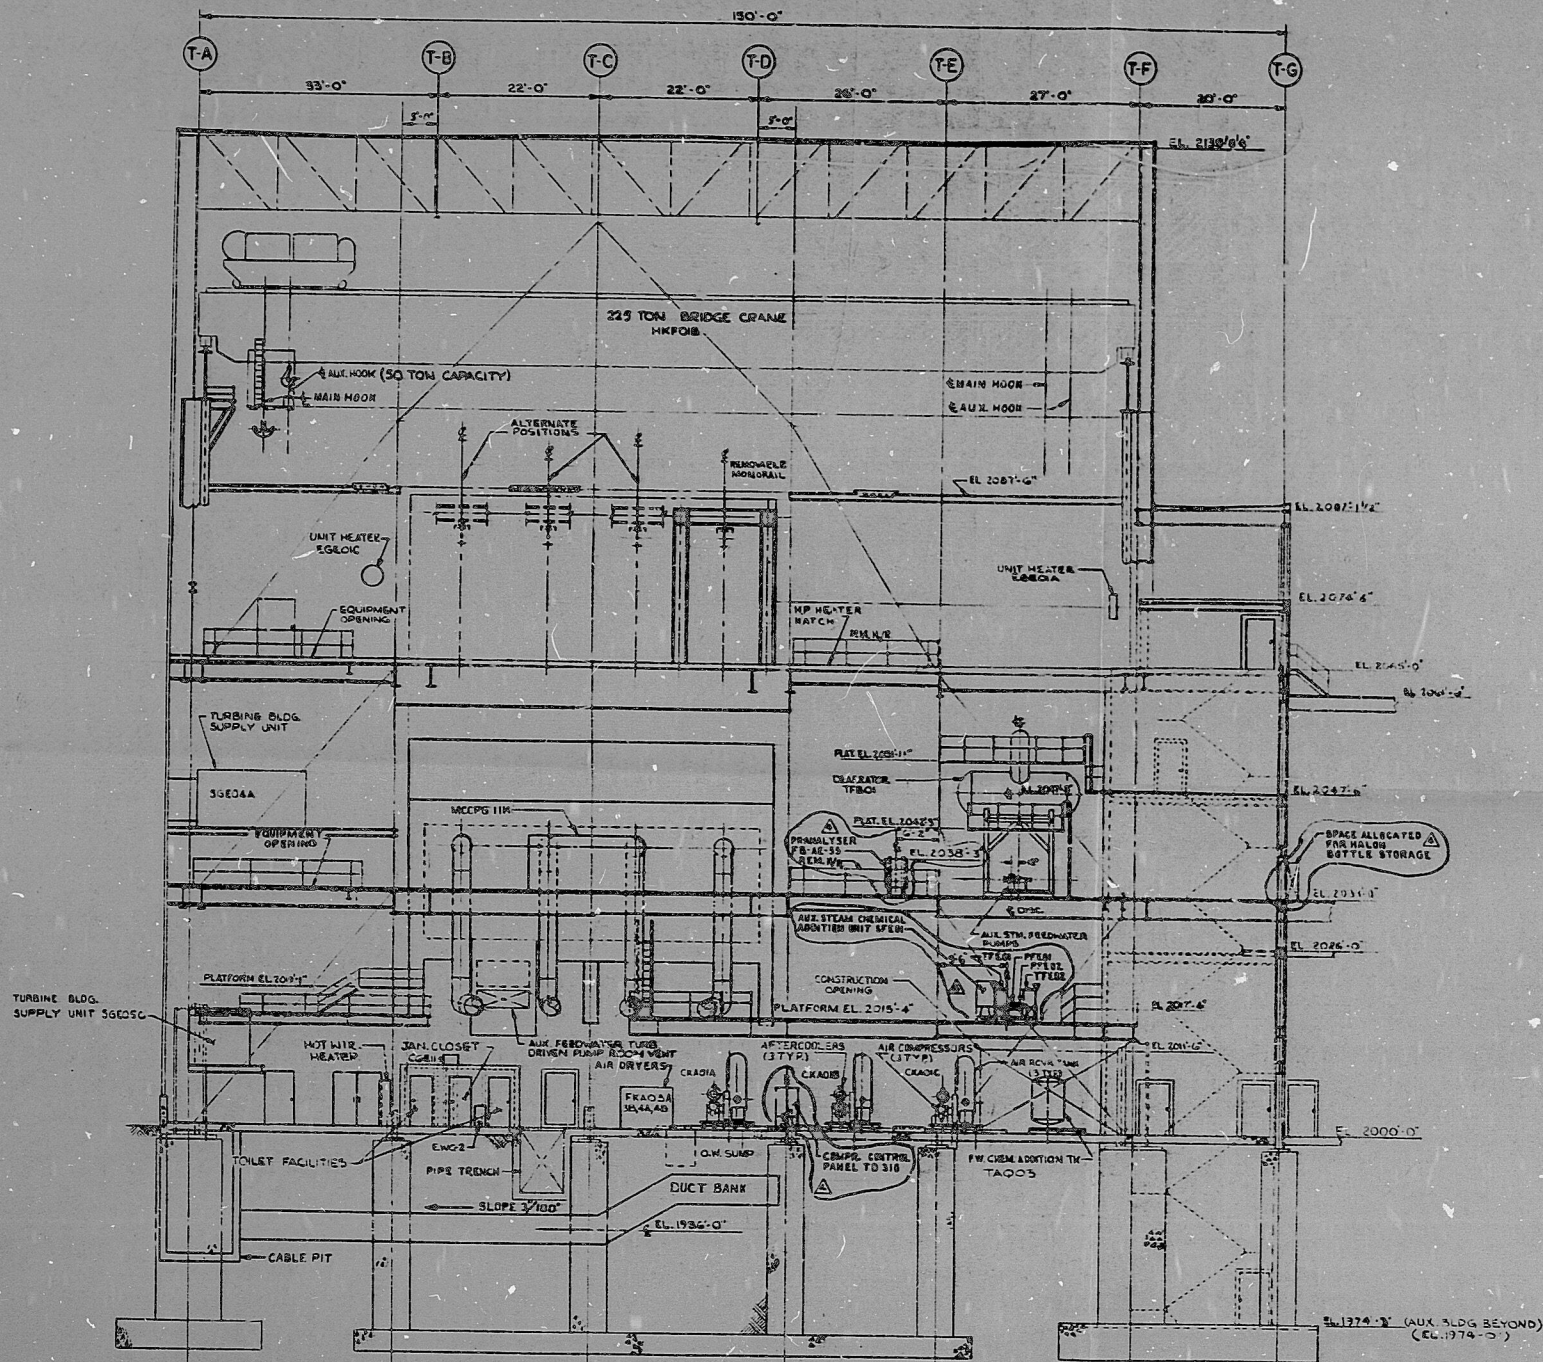

SECTION **H**
 LOOKING SOUTH M-06072
 (SEE DWG'S M-06060
 THRU M-06064)

TI
 APERTURE
 CARD

NOTICE: ALTERATION OF THIS DOCUMENT BY ANY PERSON OTHER THAN A LICENSED PROFESSIONAL ENGINEER OR A PERSON ACTING UNDER HIS OR HER DIRECTION IS ILLEGAL.
 THE UNDERSIGNED HEREBY DISCLAIMS ANY RESPONSIBILITY FOR ANY PLANS, SPECIFICATIONS, ESTIMATES, ETC., IN THIS PROJECT, WHETHER OR NOT SUCH DOCUMENTS OR INSTRUMENTS RELATING TO OR INTENDED TO BE USED FOR ANY PART OR PARTS OF THE ENGINEERING PROJECT FOR OR IN CONNECTION WITH WHICH THIS DOCUMENT IS TO BE USED, EXCEPT AS SHOWN ON THE DRAWING. THE UNDERSIGNED WILL NOT BE RESPONSIBLE FOR ANY OTHER DOCUMENTS OR INSTRUMENTS AS BEING THE SIGNATURE AND THE SEAL OF THE UNDERSIGNED.

DESIGNATION	DATE	BY	CHKD
APR 1974	3-14-74	CJK	CJK
NO.	DATE	REVISIONS	BY
1	3-14-74	DESIGNED FOR CONSTRUCTION	CJK

SCALE: 1/4" = 1'-0" DATE: 3-14-74 DESIGNED BY: CJK DRAWN BY: CJK

BECHTEL
 QUINCYVILLE, MARYLAND

SNUPPS
 EQUIPMENT LOCATION
 TURBINE BUILDING
 SECTION - H

10466 M-06072

8410090080

PDR RIDS

