


17"
11"
8.5"
8.5"
11"
17"

17"
11"
8.5"
8.5"
11"
17"



BROWN & ROOT INC.
KROFILM SERVICES
THURSDAY, JAN. 13 1978

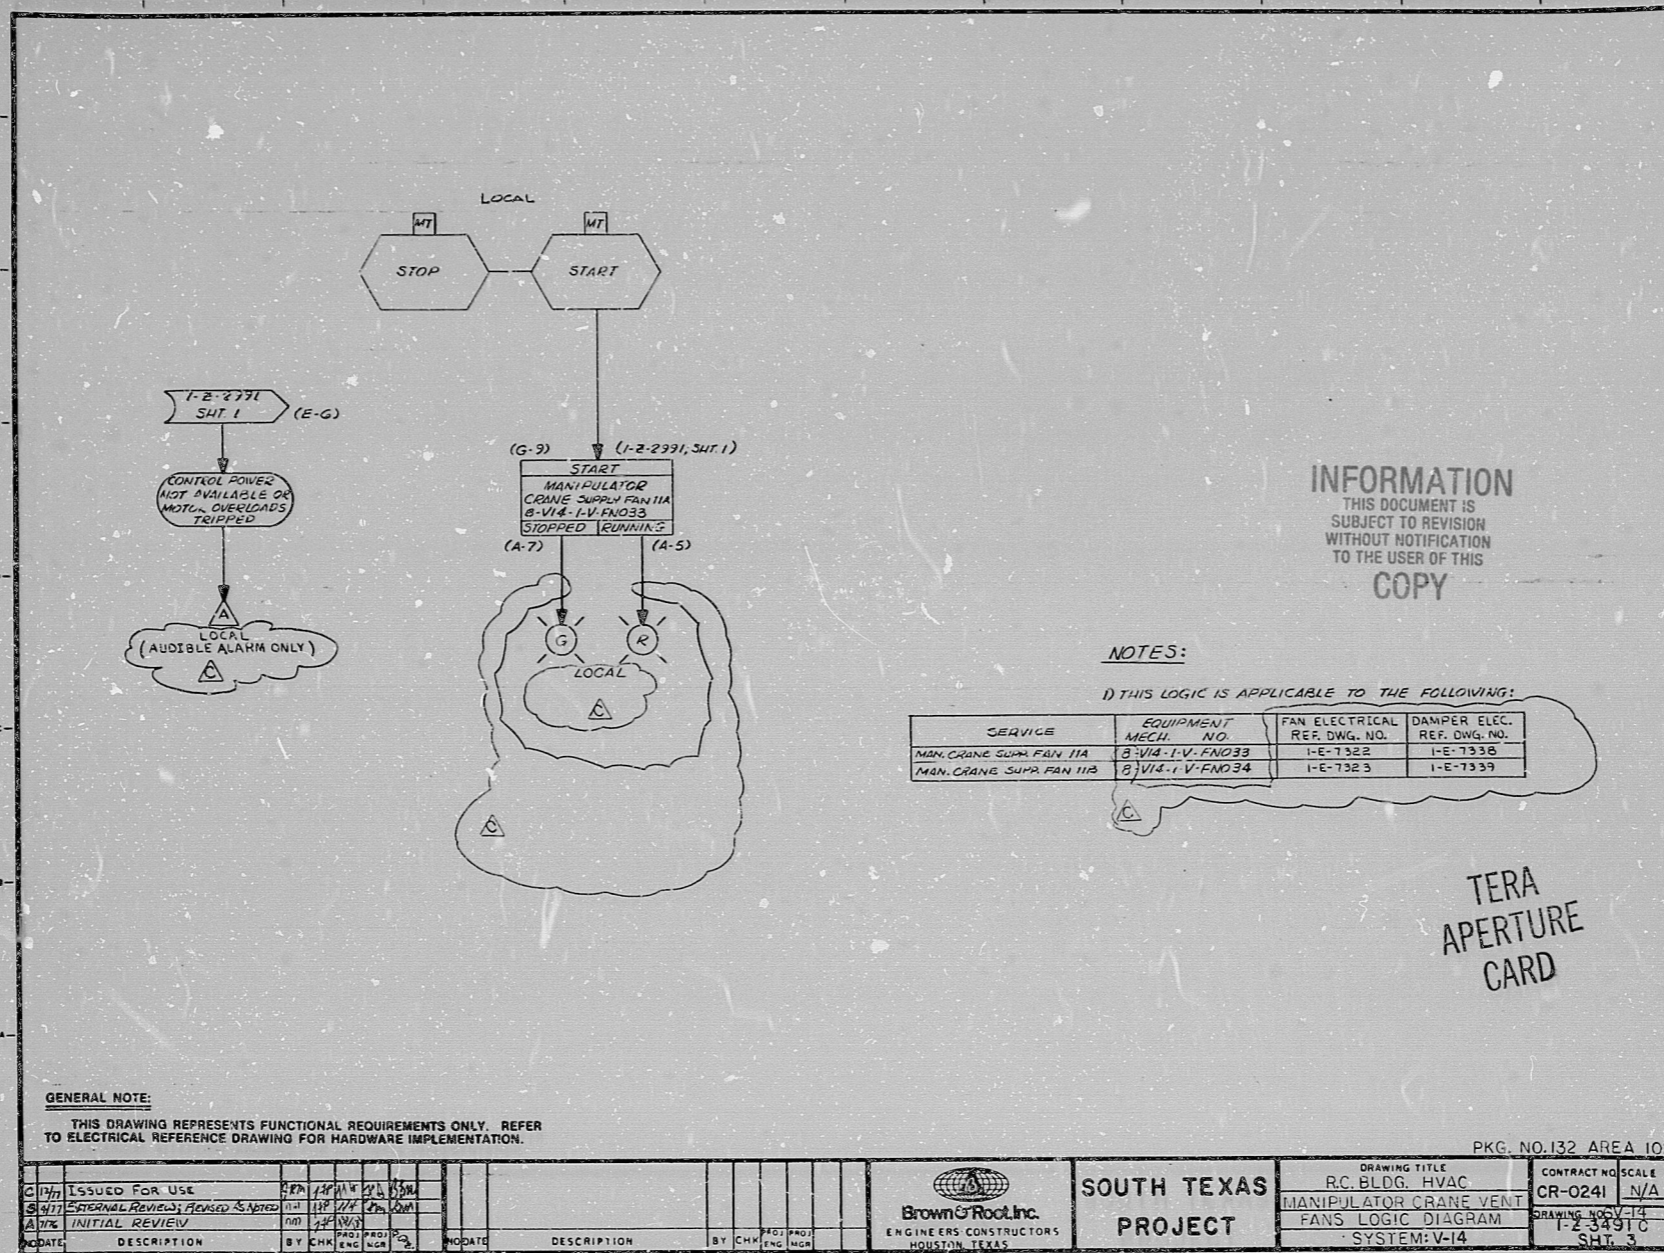

RIDS

81120910319

