



17"  
11"  
8.5"  
8.5"  
11"  
17"

17"  
11"  
8.5"  
8.5"  
11"  
17"

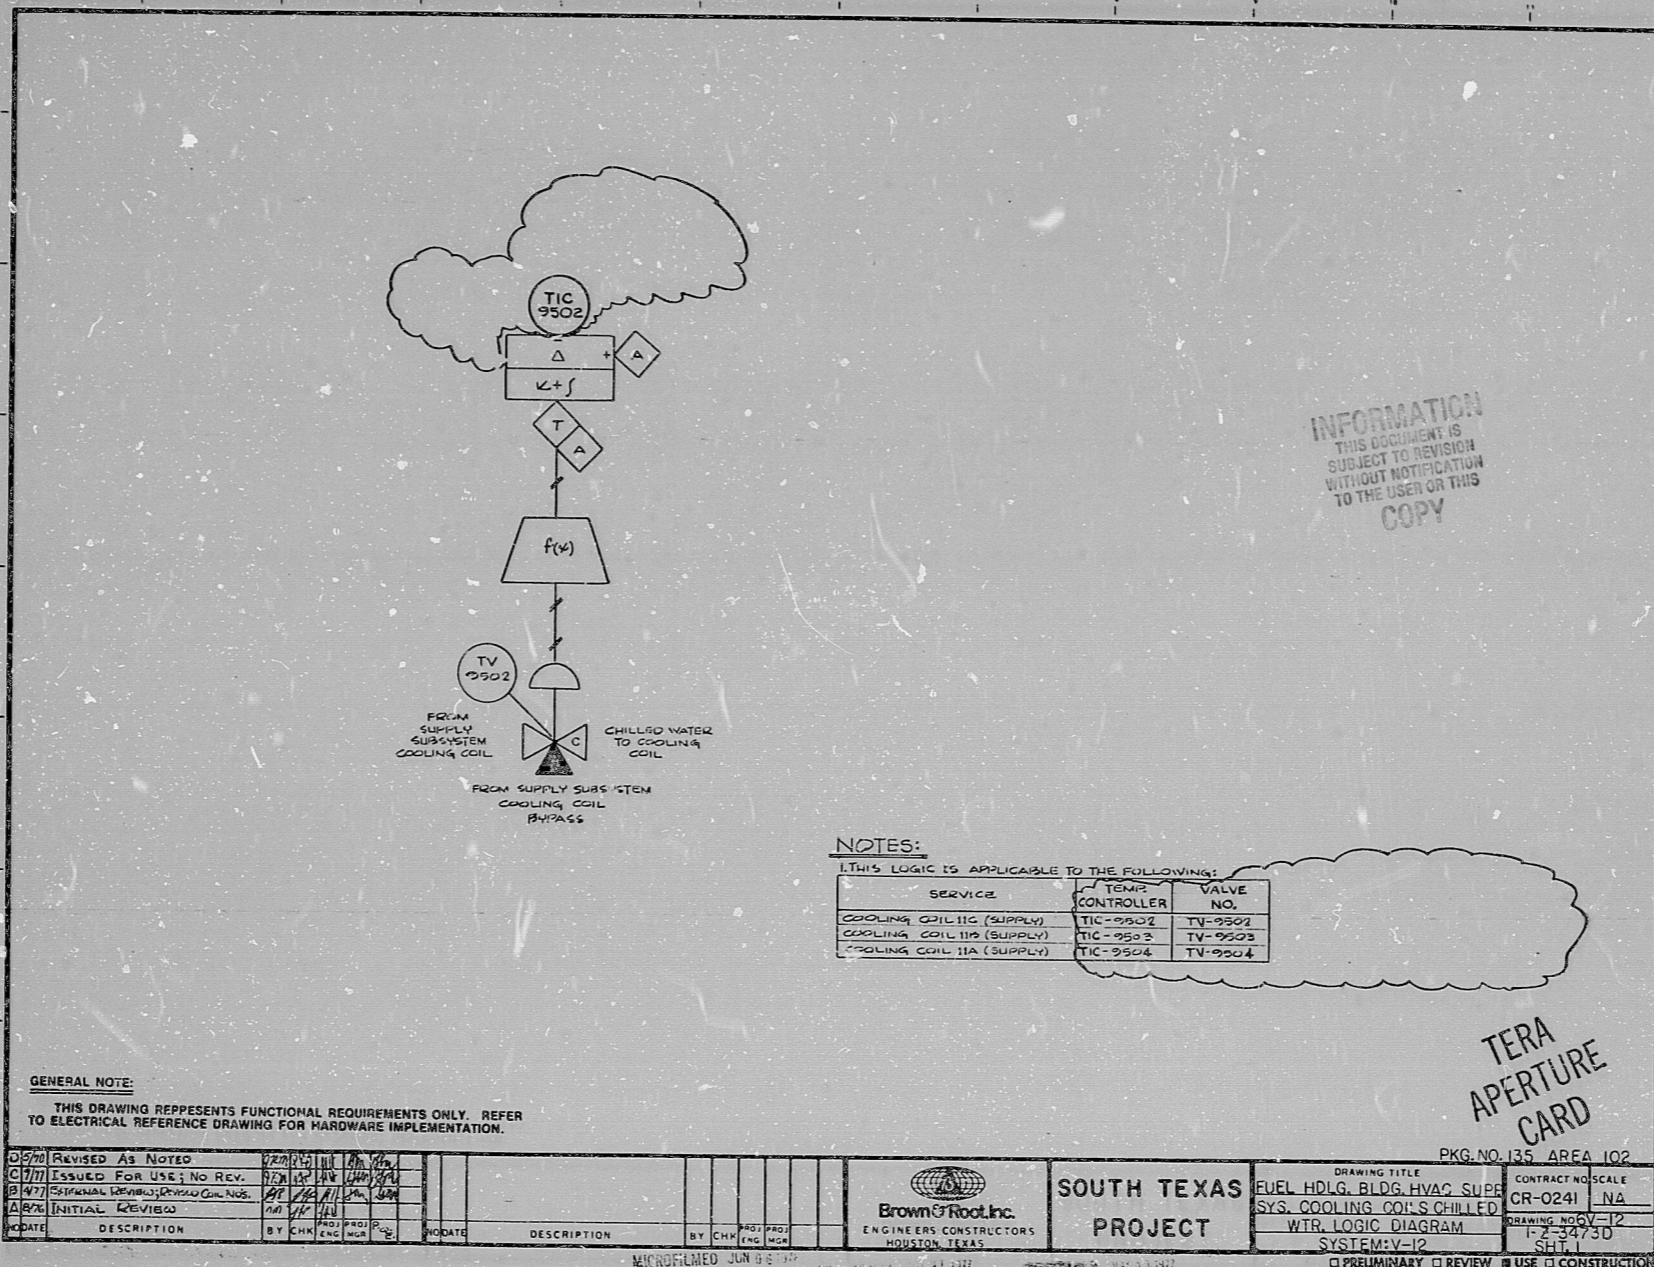

**BROWN & ROOT INC.**  
**MICROFILM SERVICES**  
FRIDAY, JUNE 9 1978

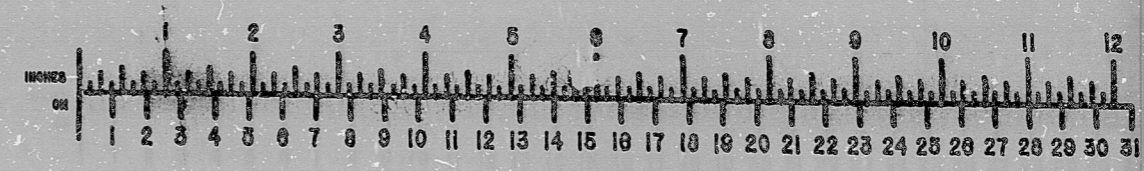

RIDS

8112090332

