

21

11

8.5"

8.5"

11"

17"

21


11

8.5"

8.5"

11"

17"

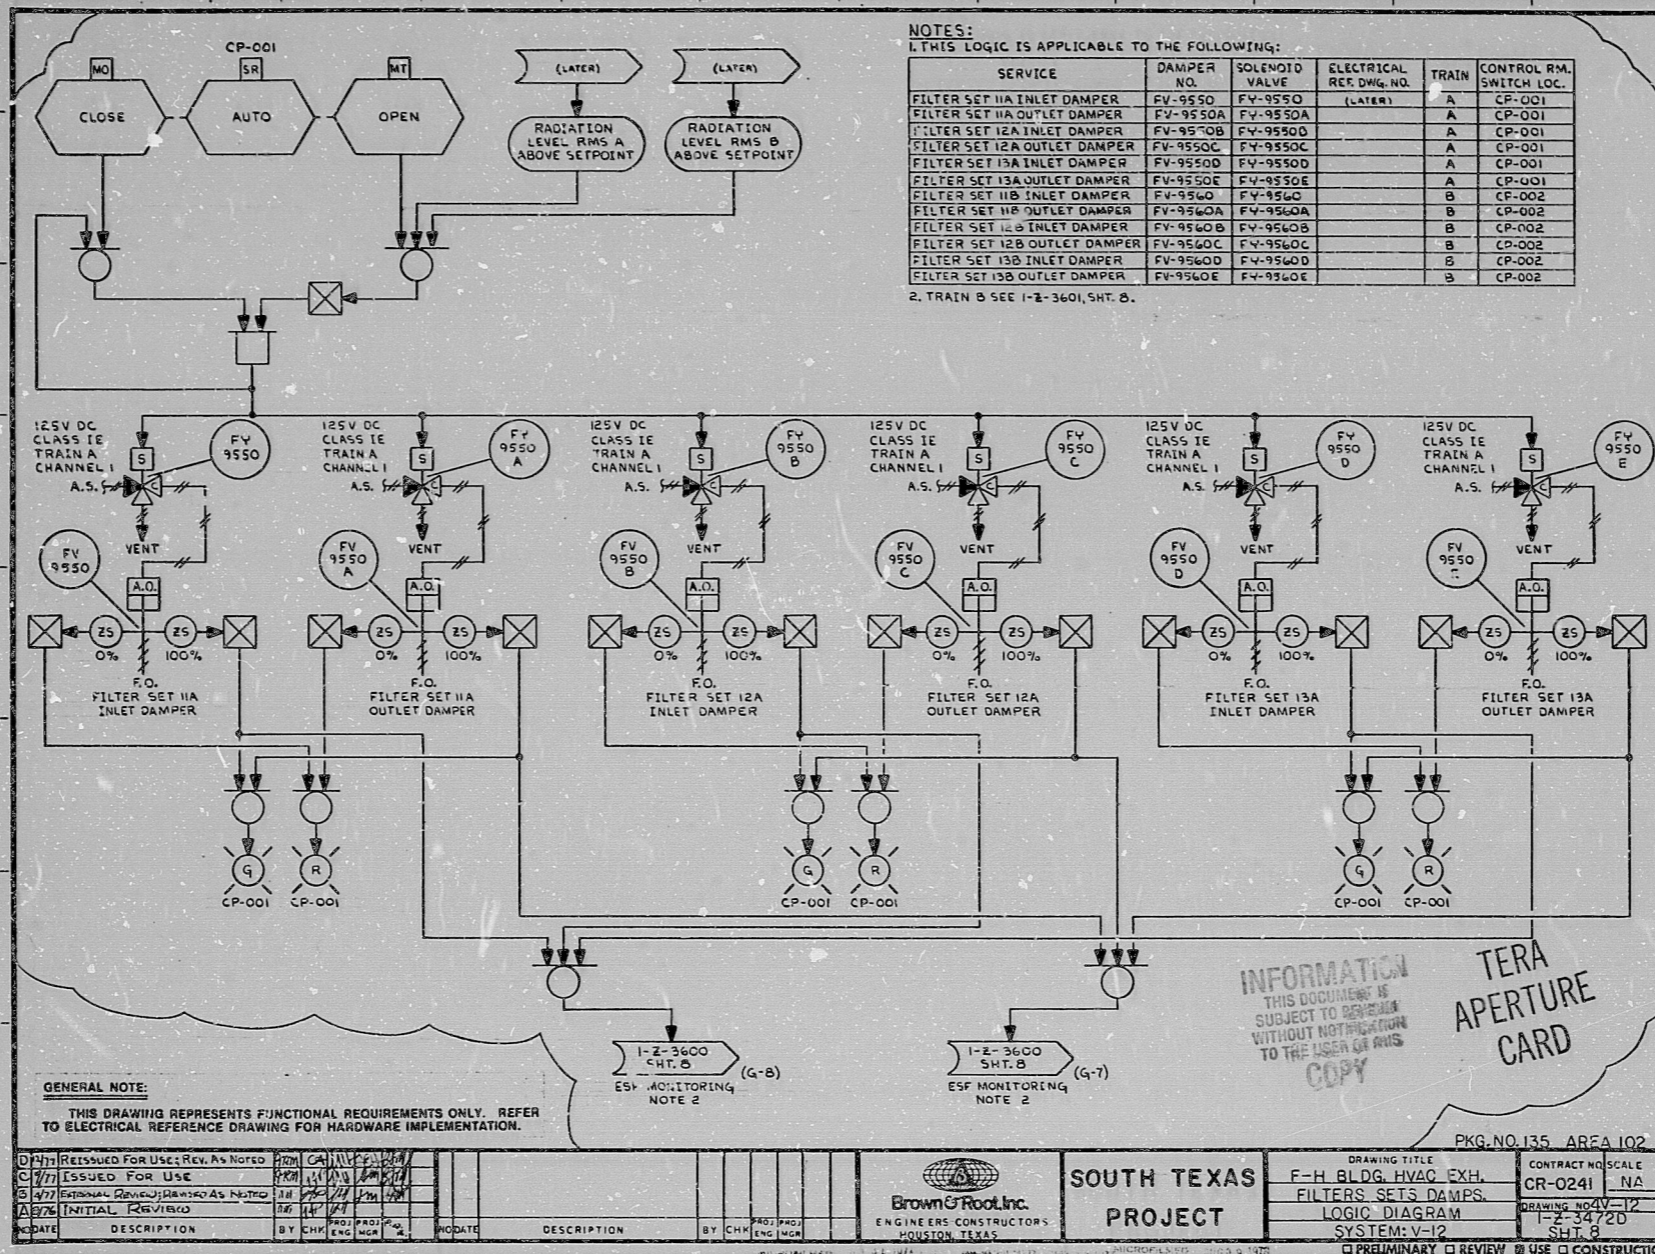

BROWN & ROOT INC. MICROFILM SERVICES

TUESDAY, FEB. 28 1978

