

26

11

8.5

8.5

11

17

26


11

8.5

8.5

11

17

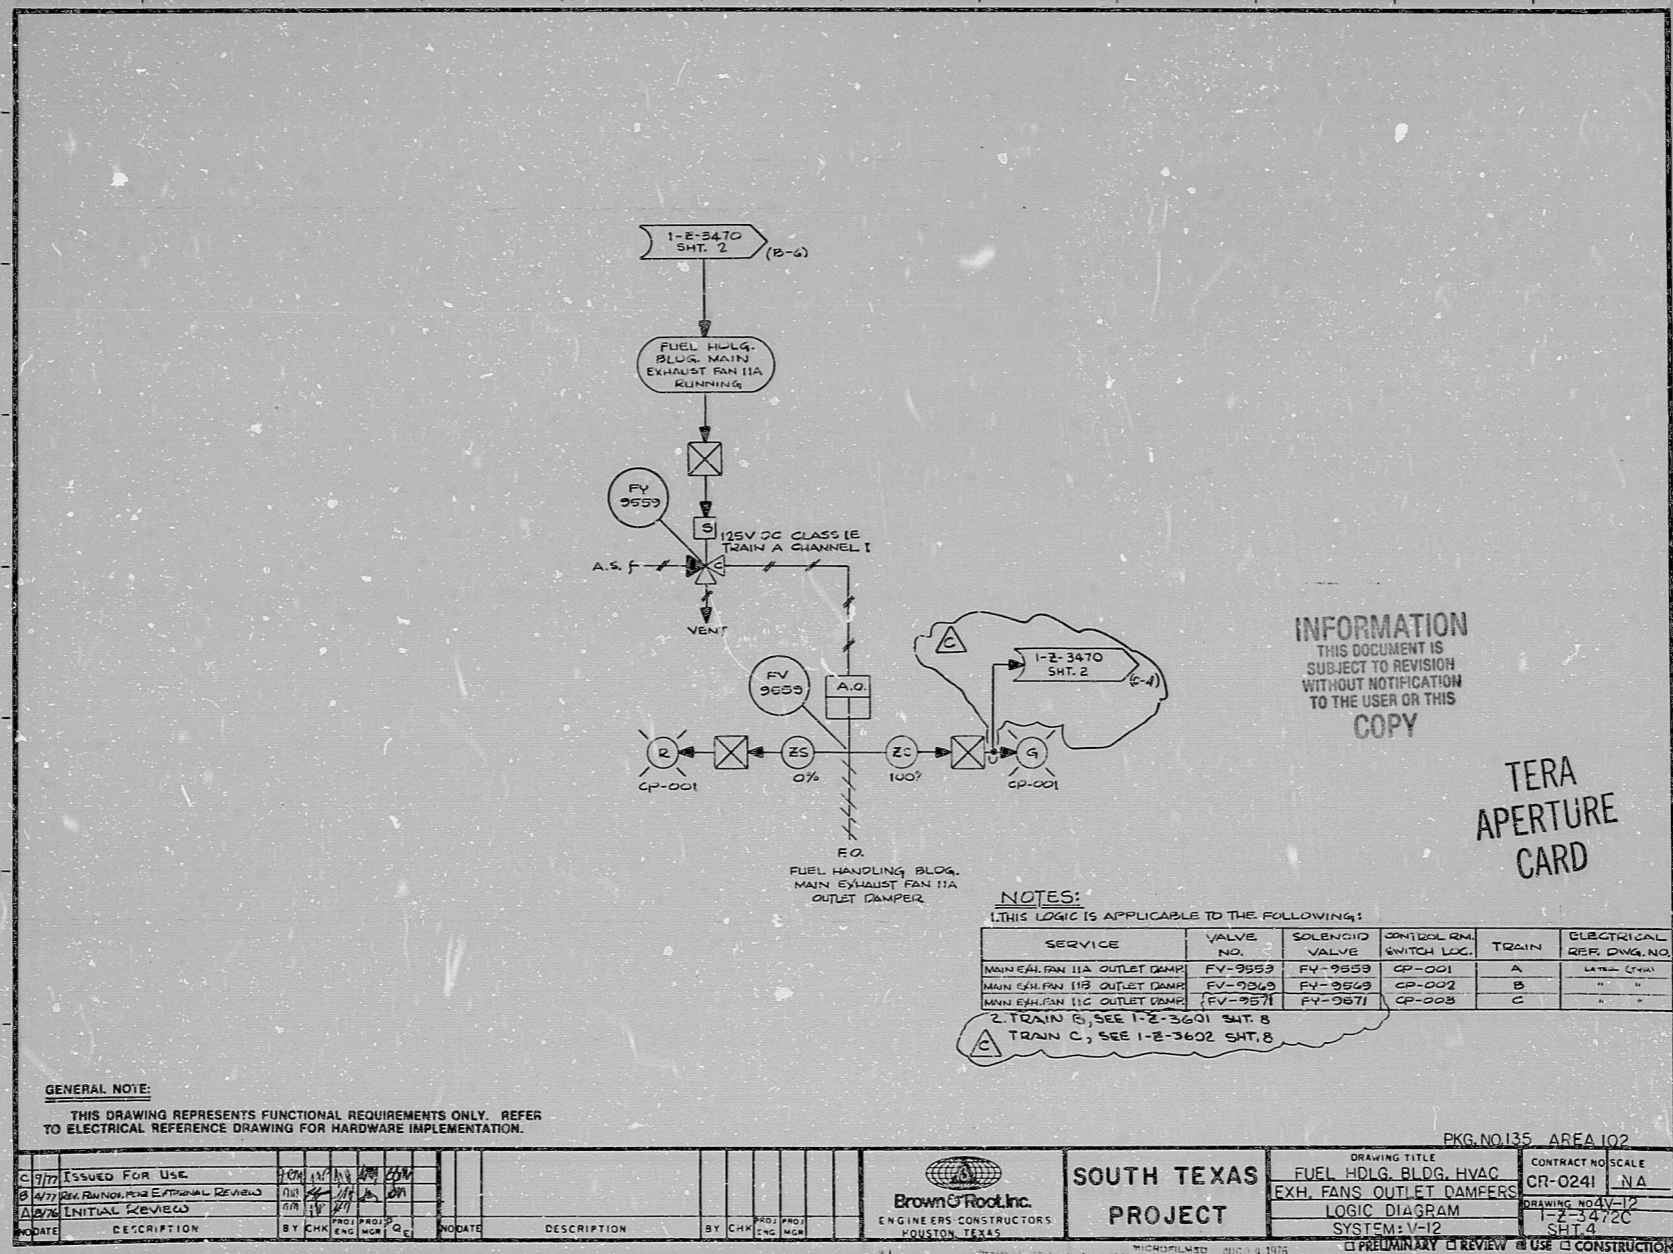

BROWN & ROOT INC. MICROFILM SERVICES

MONDAY, OCT. 31 1977



RIDS

8112090358

