



17"  
11"  
8.5"  
8.5"  
11"  
17"

17"  
11"  
8.5"  
8.5"  
11"  
17"

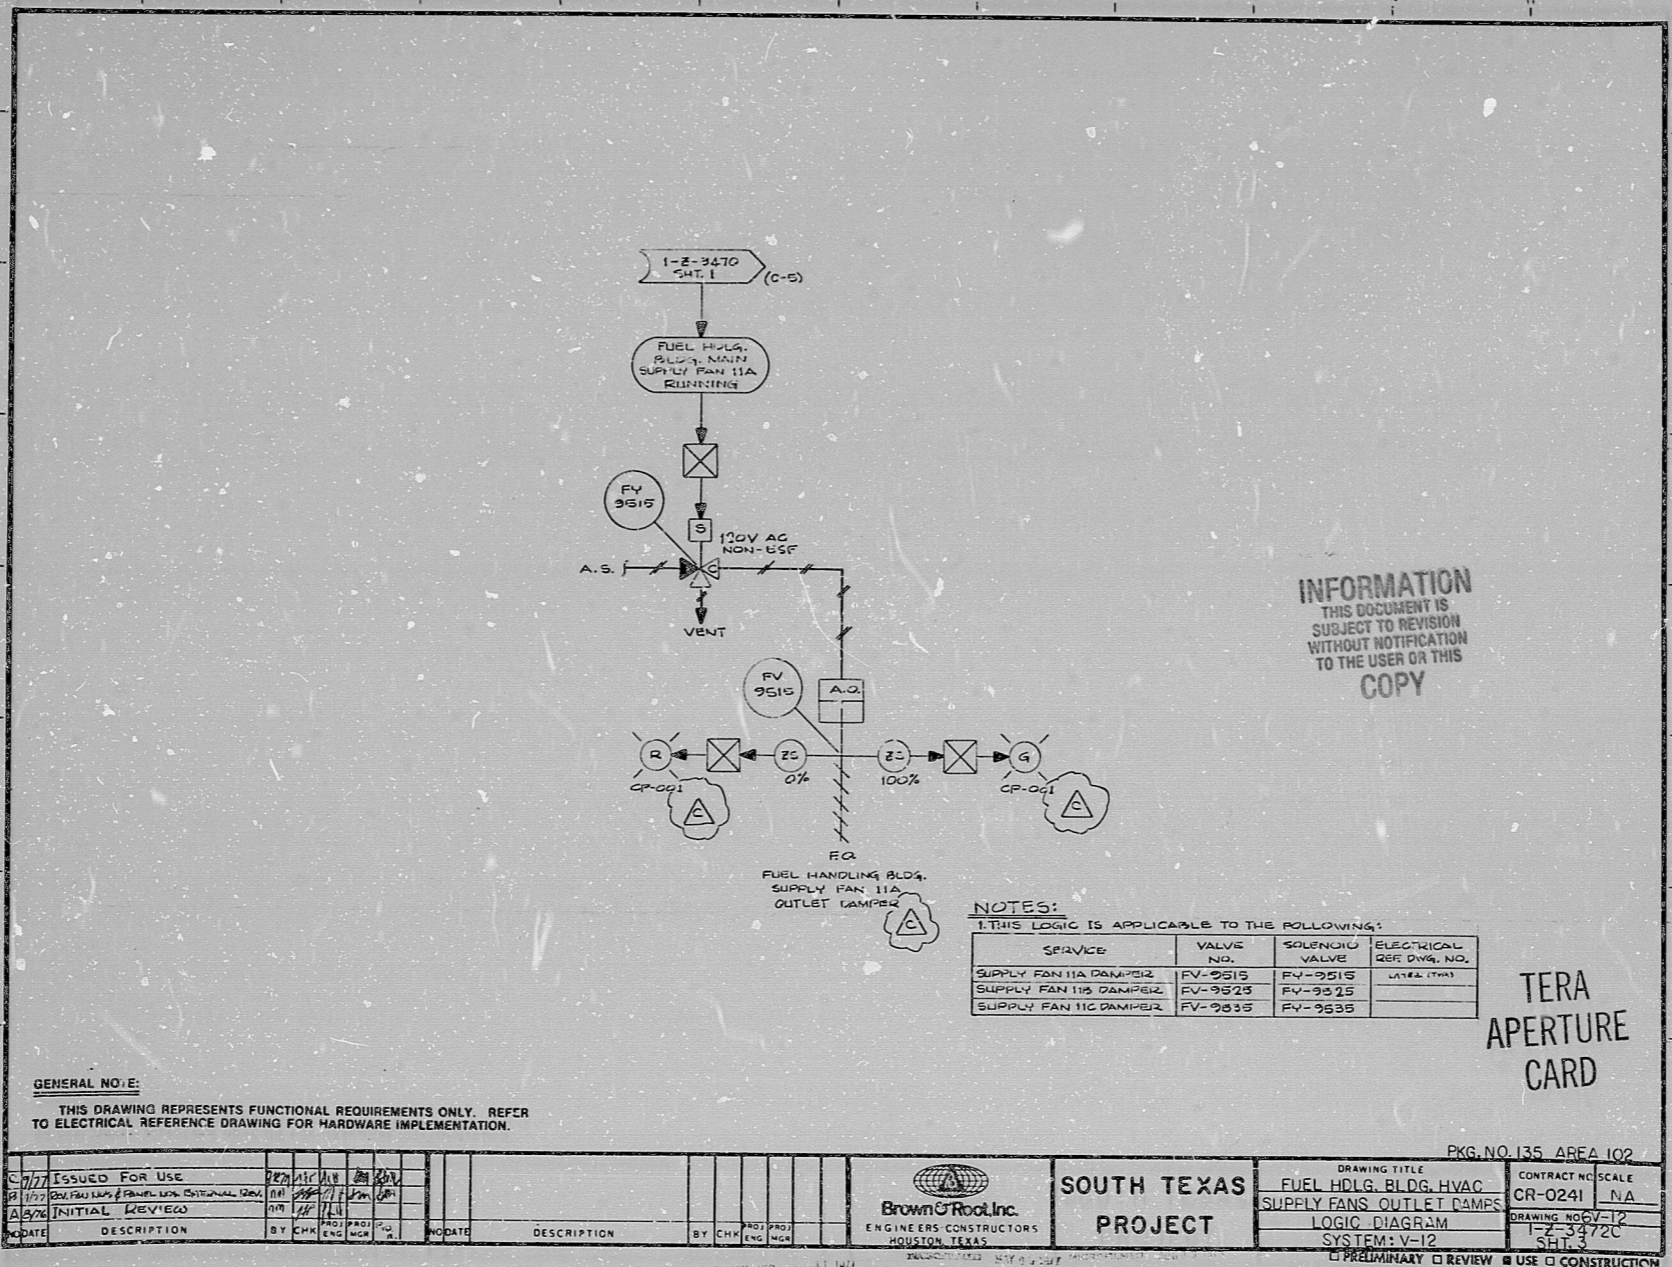

**BROWN & ROOT INC.**  
**MICROFILM SERVICES**

MONDAY, OCT. 31 1977

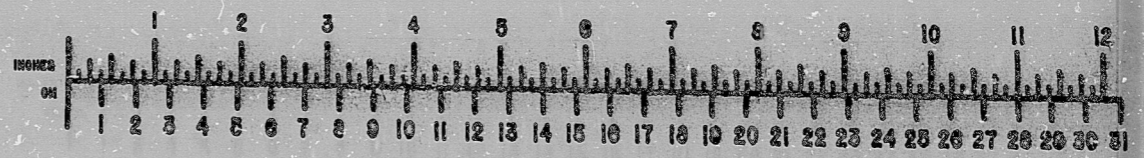

RIDS

8172090361

