

17"

11"

8.5"

8.5"

11"

17"

17"


11"

8.5"

8.5"

11"

17"

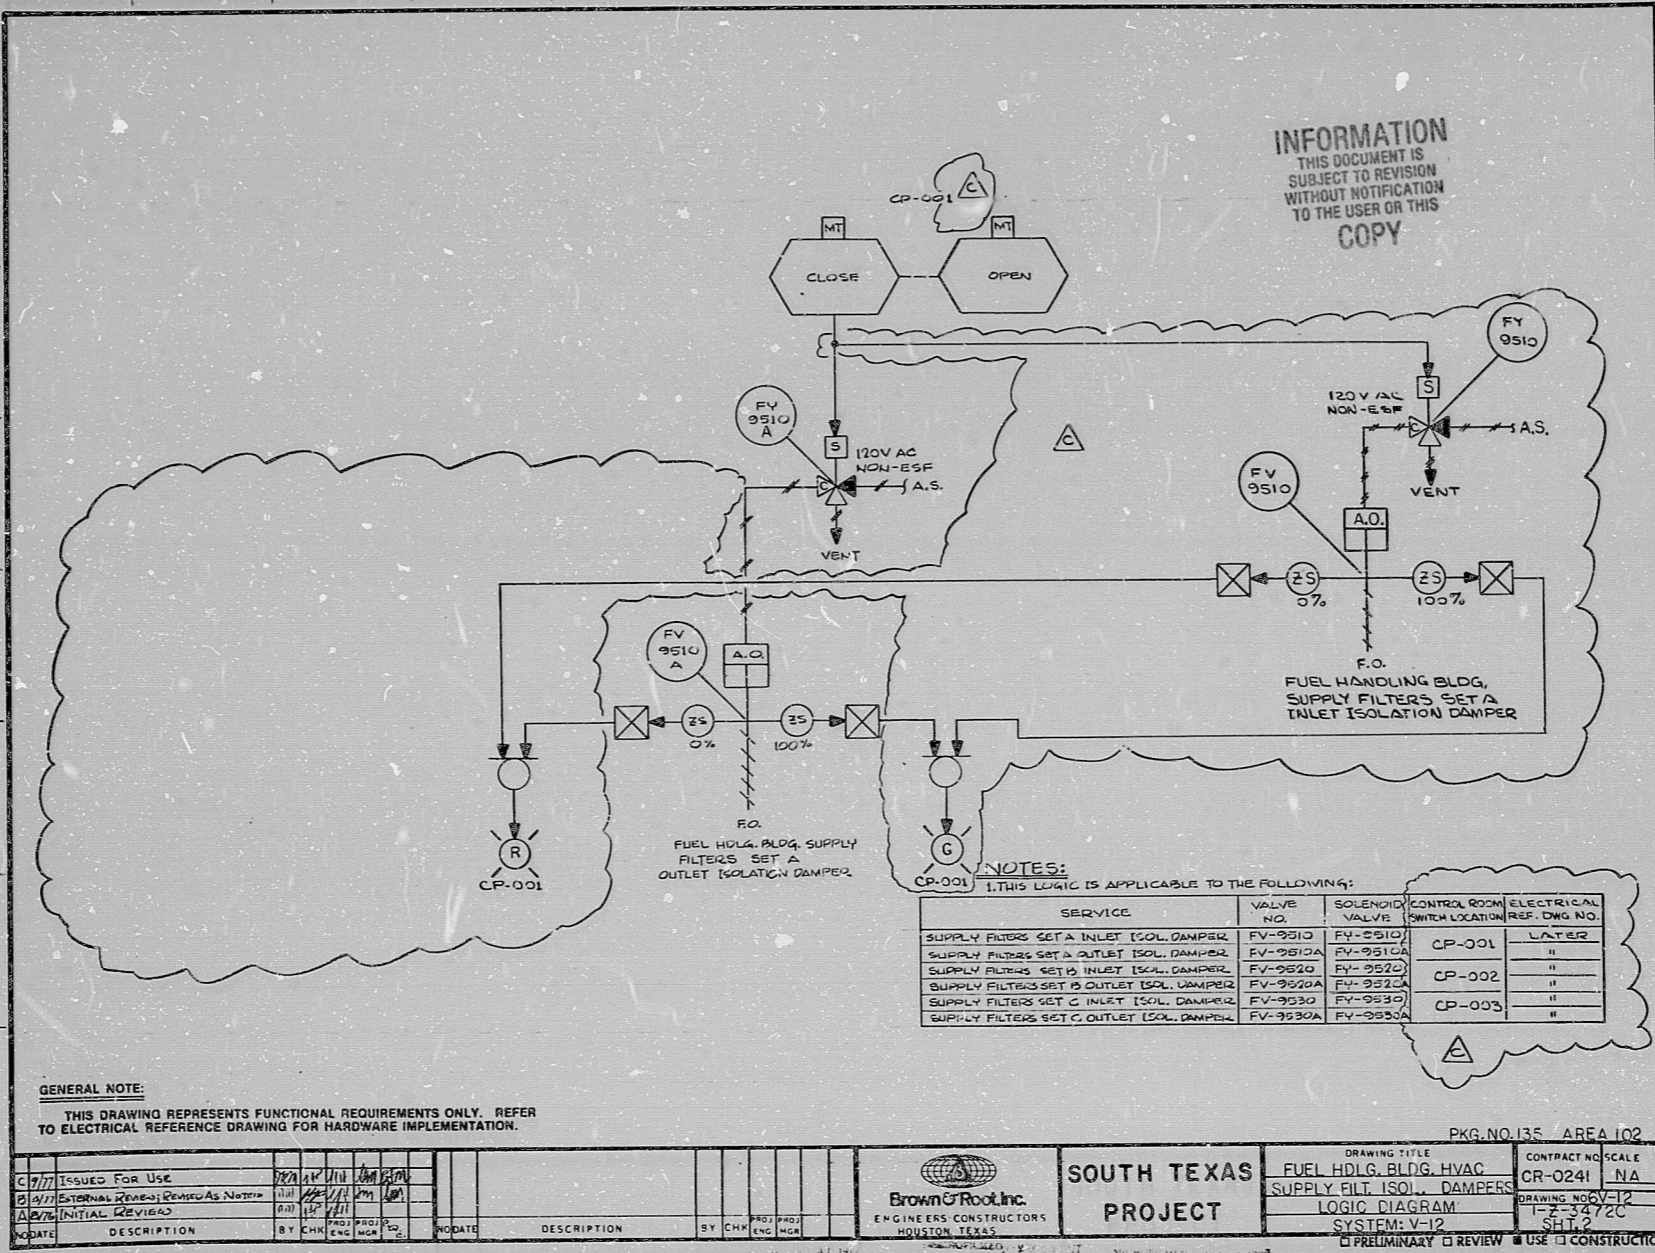

BROWN & ROOT INC. MICROFILM SERVICES

MONDAY, OCT. 31 1977





R1155

8112090368

