



11
8.5
8.5
11
17

11
8.5
8.5
11
17

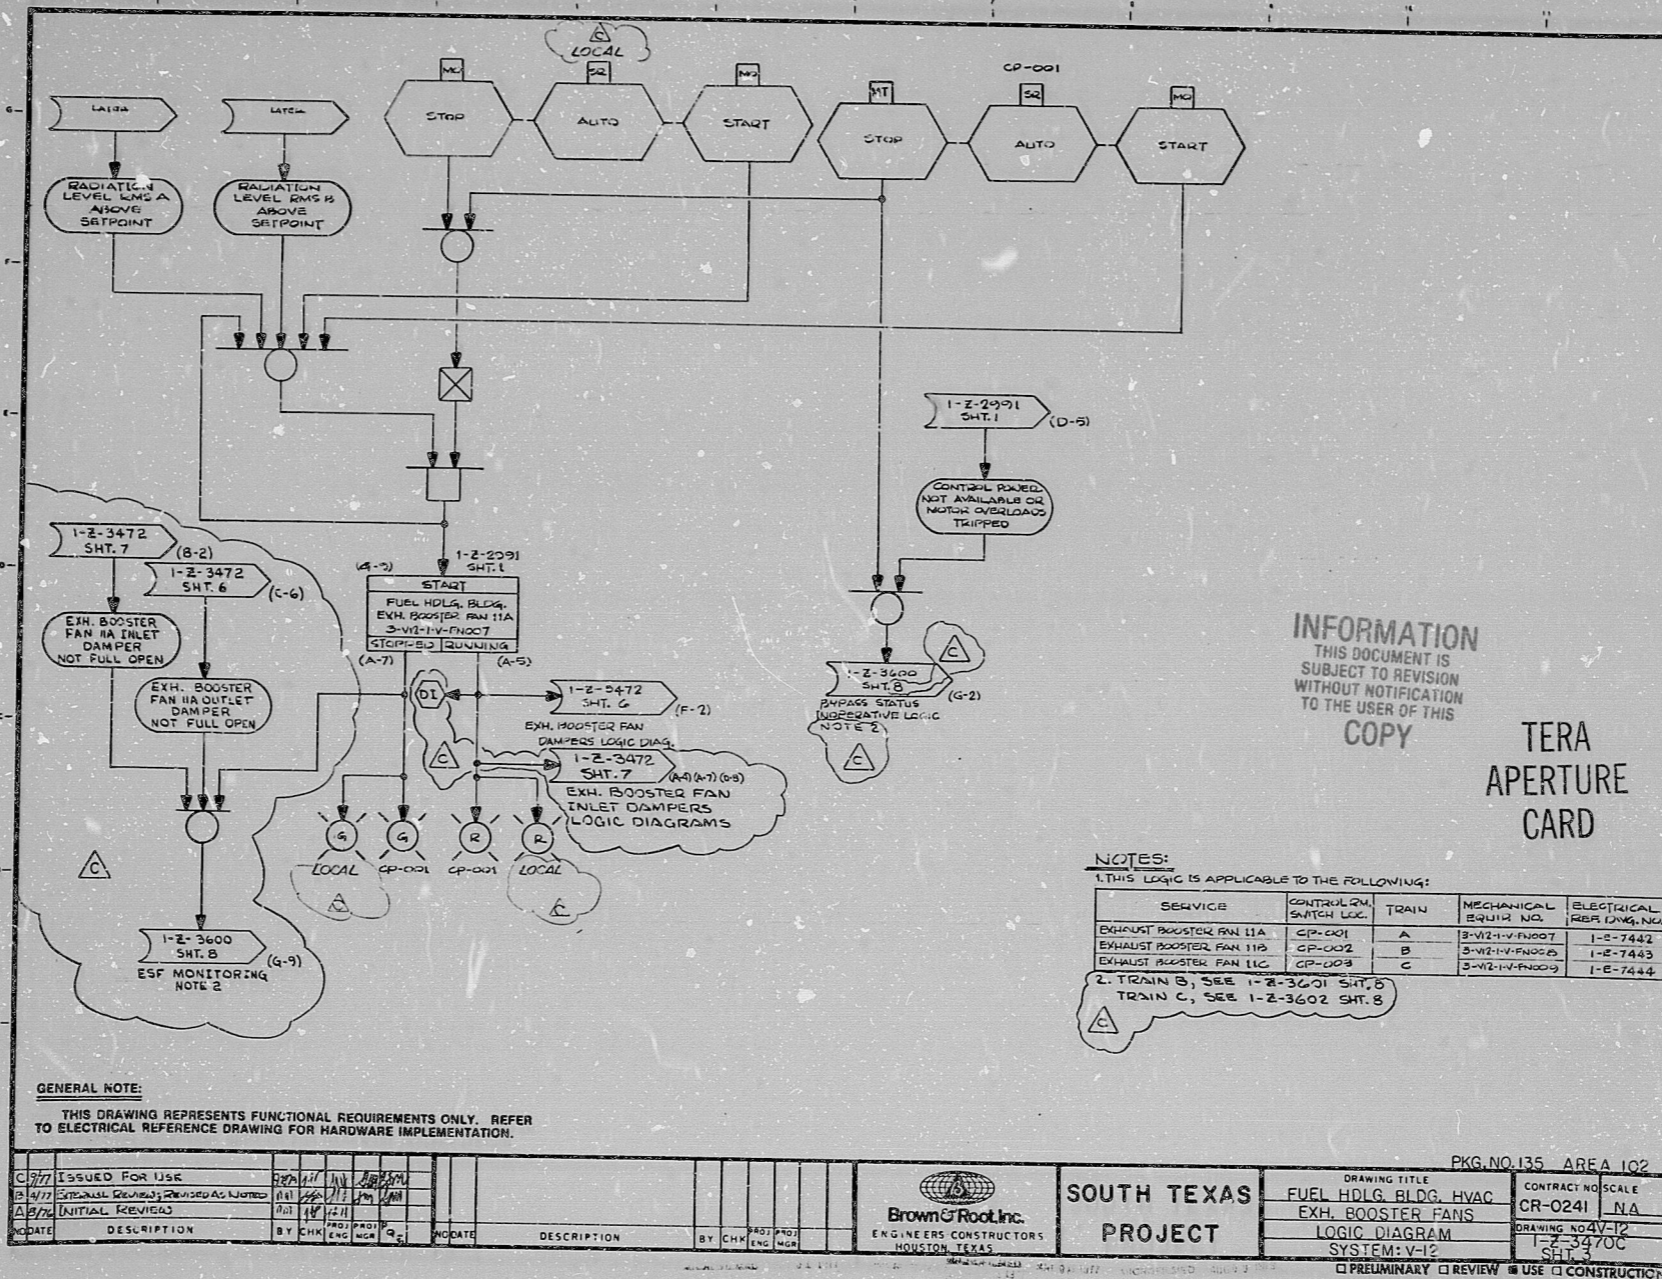

BROWN & ROOT INC.
MICROFILM SERVICES

MONDAY, OCT. 31 1977

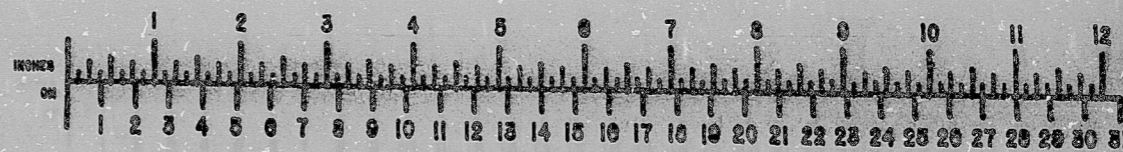

RIDS

8112090373

