


This drawing and the design it covers is the property of the utilities which are participating in the contract. It is to be used only for the purposes intended and no other use is permitted without the express agreement of the utilities. It is to be returned to the utilities upon completion of the project.

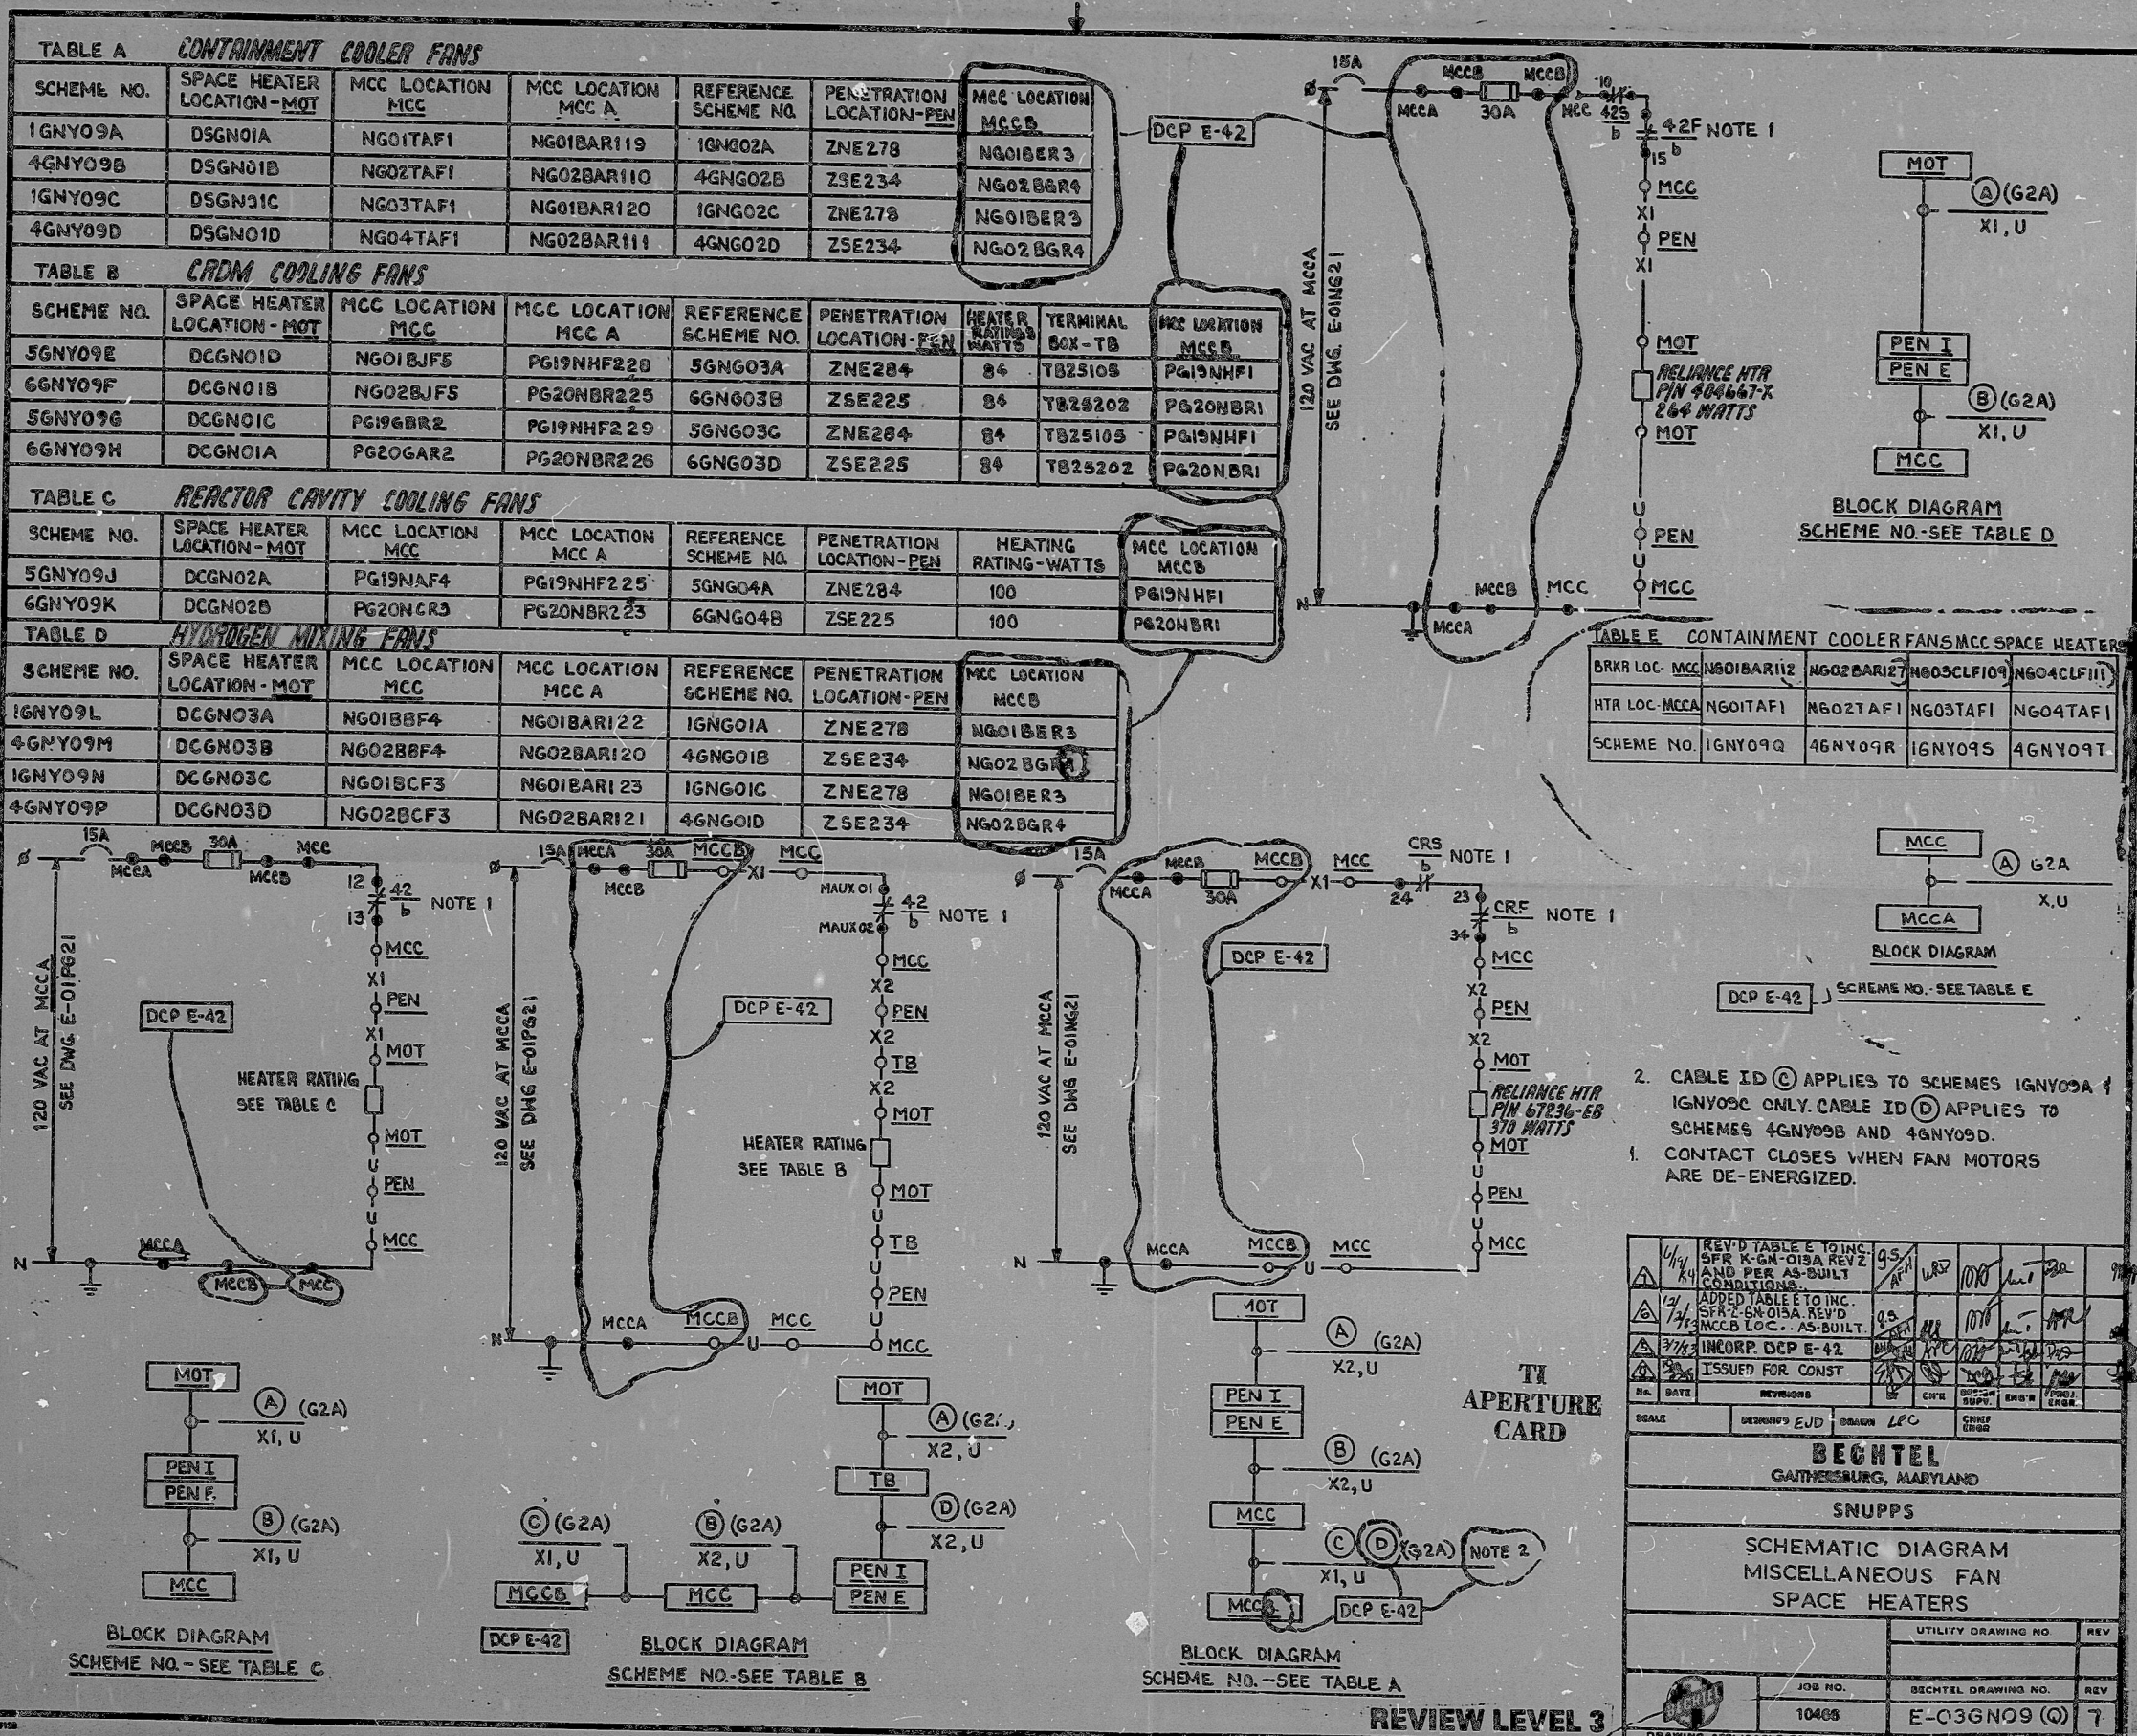

REV	DATE	REVISIONS	BY	CHKD	APP'D	REASON
1	10/1/78	REV'D TABLE E TO INC. SFR 2-5A-015A REV 2 AND PER AS-BUILT CONDITIONS.	WLD	WLD	WLD	
2	10/1/78	ADDED TABLE E TO INC. SFR 2-5A-015A REV'D MCCB LOC. - AS-BUILT.	WLD	WLD	WLD	
3	10/1/78	INCORP. DCP E-42	WLD	WLD	WLD	
4	10/1/78	ISSUED FOR CONST.	WLD	WLD	WLD	

TR APERTURE CARD

BECHTEL
GAITHERSBURG, MARYLAND

SNUPPS

SCHEMATIC DIAGRAM MISCELLANEOUS FAN SPACE HEATERS

JOB NO.	BECHTEL DRAWING NO.	REV
10465	E-03GN09 (D)	7

REVIEW LEVEL 3

I certify that the image contained on this frame was made in the normal and regular course of business, on the date stated below and that it is an accurate reproduction of the document(s) submitted to Micrographics.
 DATE 6-26-84 OPERATOR [Signature]

16 X

8410090121

PDR RIDS

