

17"

11"

8.5"

8.5"

11"

17"

17"


11"

8.5"

8.5"

11"

17"

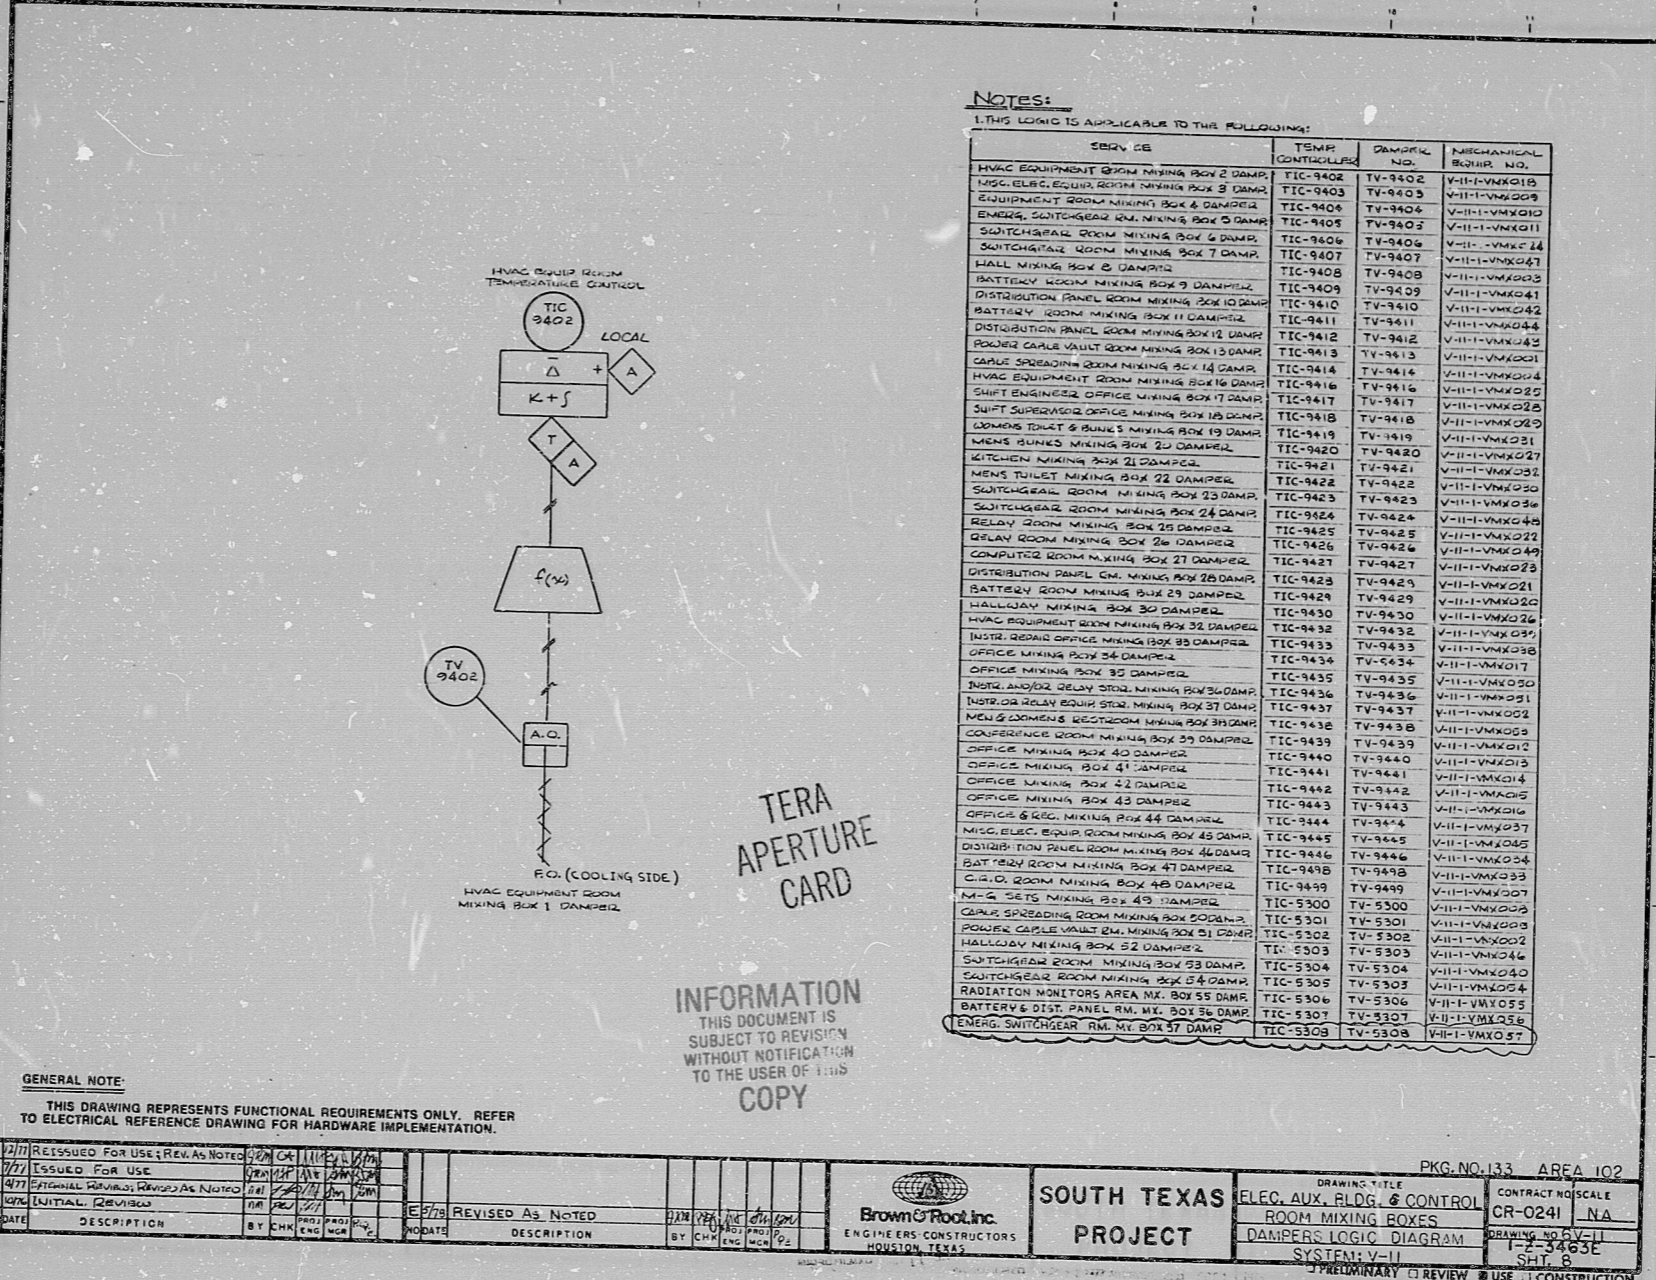

**GENERAL NOTE:**  
THIS DRAWING REPRESENTS FUNCTIONAL REQUIREMENTS ONLY. REFER TO ELECTRICAL REFERENCE DRAWING FOR HARDWARE IMPLEMENTATION.

**INFORMATION**  
THIS DOCUMENT IS SUBJECT TO REVISION WITHOUT NOTIFICATION TO THE USER OF THIS COPY

0/2/77	ISSUED FOR USE	REV. AS NOTED	BY	CHK	ENG	DATE	DESCRIPTION	BY	CHK	ENG	DATE	DESCRIPTION
0/7/77	ISSUED FOR USE	REV. AS NOTED	BY	CHK	ENG	DATE	DESCRIPTION	BY	CHK	ENG	DATE	DESCRIPTION
0/4/77	ORIGINAL DRAWING REVISED AS NOTED	REV. AS NOTED	BY	CHK	ENG	DATE	DESCRIPTION	BY	CHK	ENG	DATE	DESCRIPTION
A/3/77	INITIAL REVISION	REV. AS NOTED	BY	CHK	ENG	DATE	DESCRIPTION	BY	CHK	ENG	DATE	DESCRIPTION



**SOUTH TEXAS PROJECT**  
ELEC. AUX. BLDG. & CONTROL ROOM MIXING BOXES DAMPERS LOGIC DIAGRAM SYSTEM V-II  
DRAWING TITLE: ELEC. AUX. BLDG. & CONTROL ROOM MIXING BOXES DAMPERS LOGIC DIAGRAM SYSTEM V-II  
CONTRACT NO. SCALE: CR-0241 N/A  
DRAWING NO. REV. 11  
SHT. 3 OF 3  
SHT. B

**BROWN & ROOT INC. MICROFILM SERVICES**

MONDAY, JUNE 13 1978





RIDS

8112090458

