


7
11
8.5
8.5
11
17

7
11
8.5
8.5
11
17

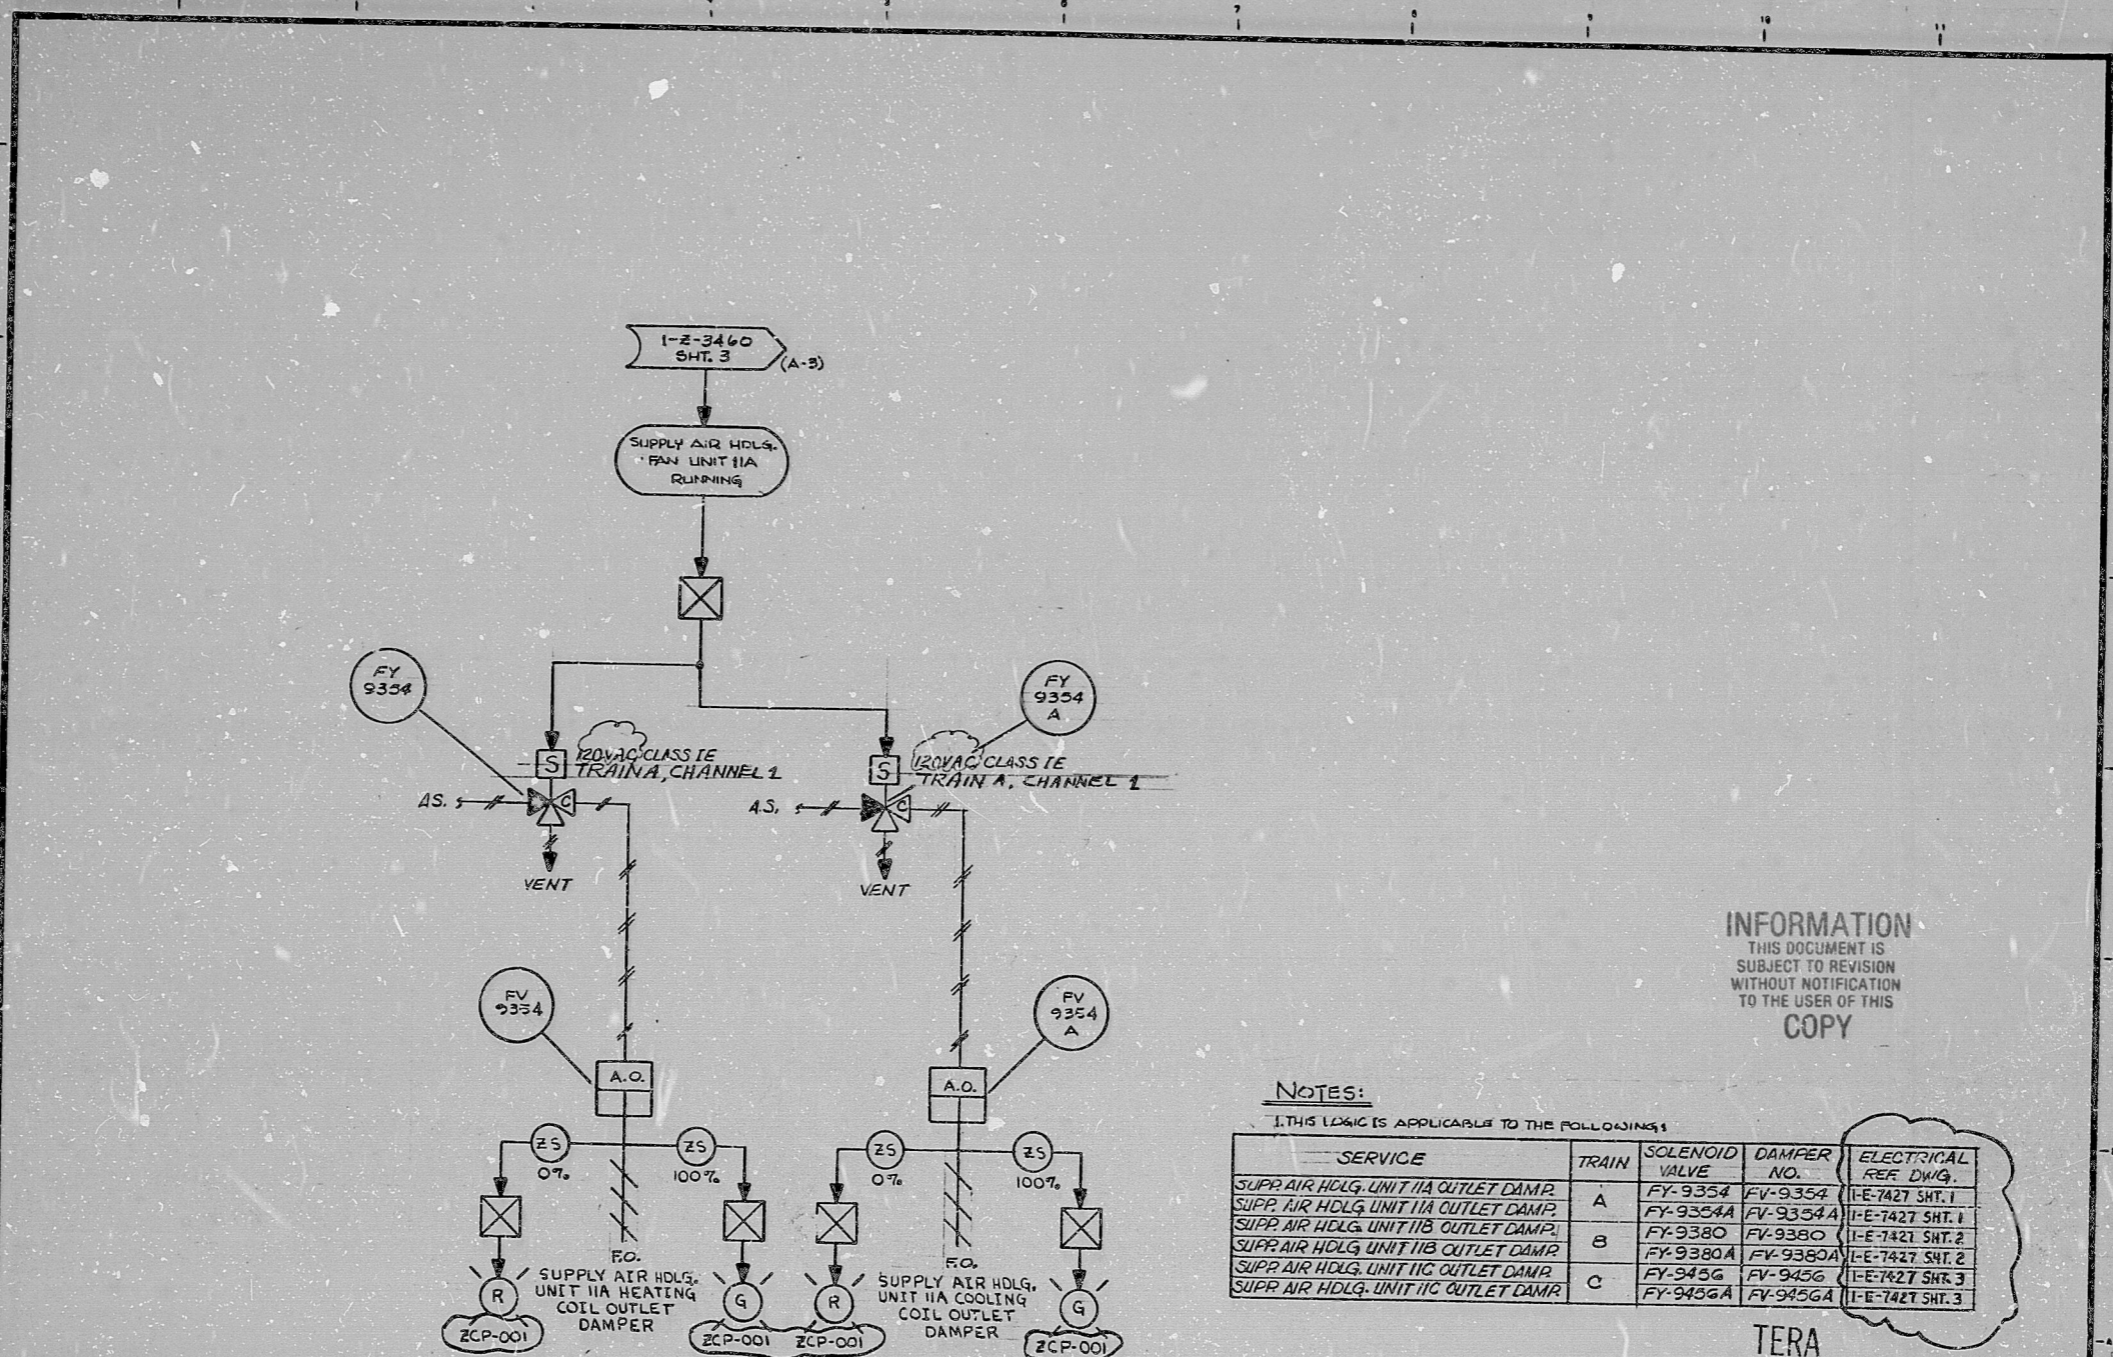

INFORMATION
THIS DOCUMENT IS
SUBJECT TO REVISION
WITHOUT NOTIFICATION
TO THE USER OF THIS
COPY

NOTES:

1. THIS LOGIC IS APPLICABLE TO THE FOLLOWING:

SERVICE	TRAIN	SOLENOID VALVE NO.	DAMPER NO.	ELECTRICAL REF. DWG.
SUPP AIR HDLG. UNIT IIA OUTLET DAMP.	A	FY-9354	FV-9354	11-E-7427 SHT. 1
SUPP AIR HDLG. UNIT IIA OUTLET DAMP.	A	FY-9354A	FV-9354A	11-E-7427 SHT. 1
SUPP AIR HDLG. UNIT IIB OUTLET DAMP.	B	FY-9380	FV-9380	11-E-7427 SHT. 2
SUPP AIR HDLG. UNIT IIB OUTLET DAMP.	B	FY-9380A	FV-9380A	11-E-7427 SHT. 2
SUPP AIR HDLG. UNIT IIC OUTLET DAMP.	C	FY-9456	FV-9456	11-E-7427 SHT. 3
SUPP AIR HDLG. UNIT IIC OUTLET DAMP.	C	FY-9456A	FV-9456A	11-E-7427 SHT. 3

TERA
APERTURE
CARD

GENERAL NOTE:
THIS DRAWING REPRESENTS FUNCTIONAL REQUIREMENTS ONLY. REFER TO ELECTRICAL REFERENCE DRAWING FOR HARDWARE IMPLEMENTATION.

DATE	DESCRIPTION	BY	CHK	PROJ. ENG.	PROJ. MGR.	DATE	DESCRIPTION	BY	CHK	PROJ. ENG.	PROJ. MGR.
05/78	REVISED AS NOTED	AKM	AKM								
09/77	ISSUED FOR USE	AKM	AKM								
04/77	EXTERNAL REVISED UNIT NOS.	AKM	AKM								
01/76	INITIAL REVISION	AKM	AKM								
08/75	REVISED AS NOTED; ISSUED FOR USE	AKM	AKM								

PKG. NO. 133 AREA 102

Brown & Root Inc.
ENGINEERS-CONSTRUCTORS
HOUSTON, TEXAS

SOUTH TEXAS PROJECT

DRAWING TITLE
ELEC. AUX. BLDG. & CONT. RM.
SUPP AIR HDLG. UNITS
OUTLET DAMPS, LOGIC DIAG.
SYSTEM: V-II

CONTRACT NO. SCALE
CR-0241 NA

DRAWING NO. 4V-II
1-E-3465E
SHT. 5

PRELIMINARY REVIEW & USE CONSTRUCTION



BROWN & ROOT INC.
MICROFILM SERVICES

FRIDAY, OCT. 5 1979



RIDS

8112090466

