


17"  
11"  
8.5"  
11"  
17"

17"  
11"  
8.5"  
11"  
17"

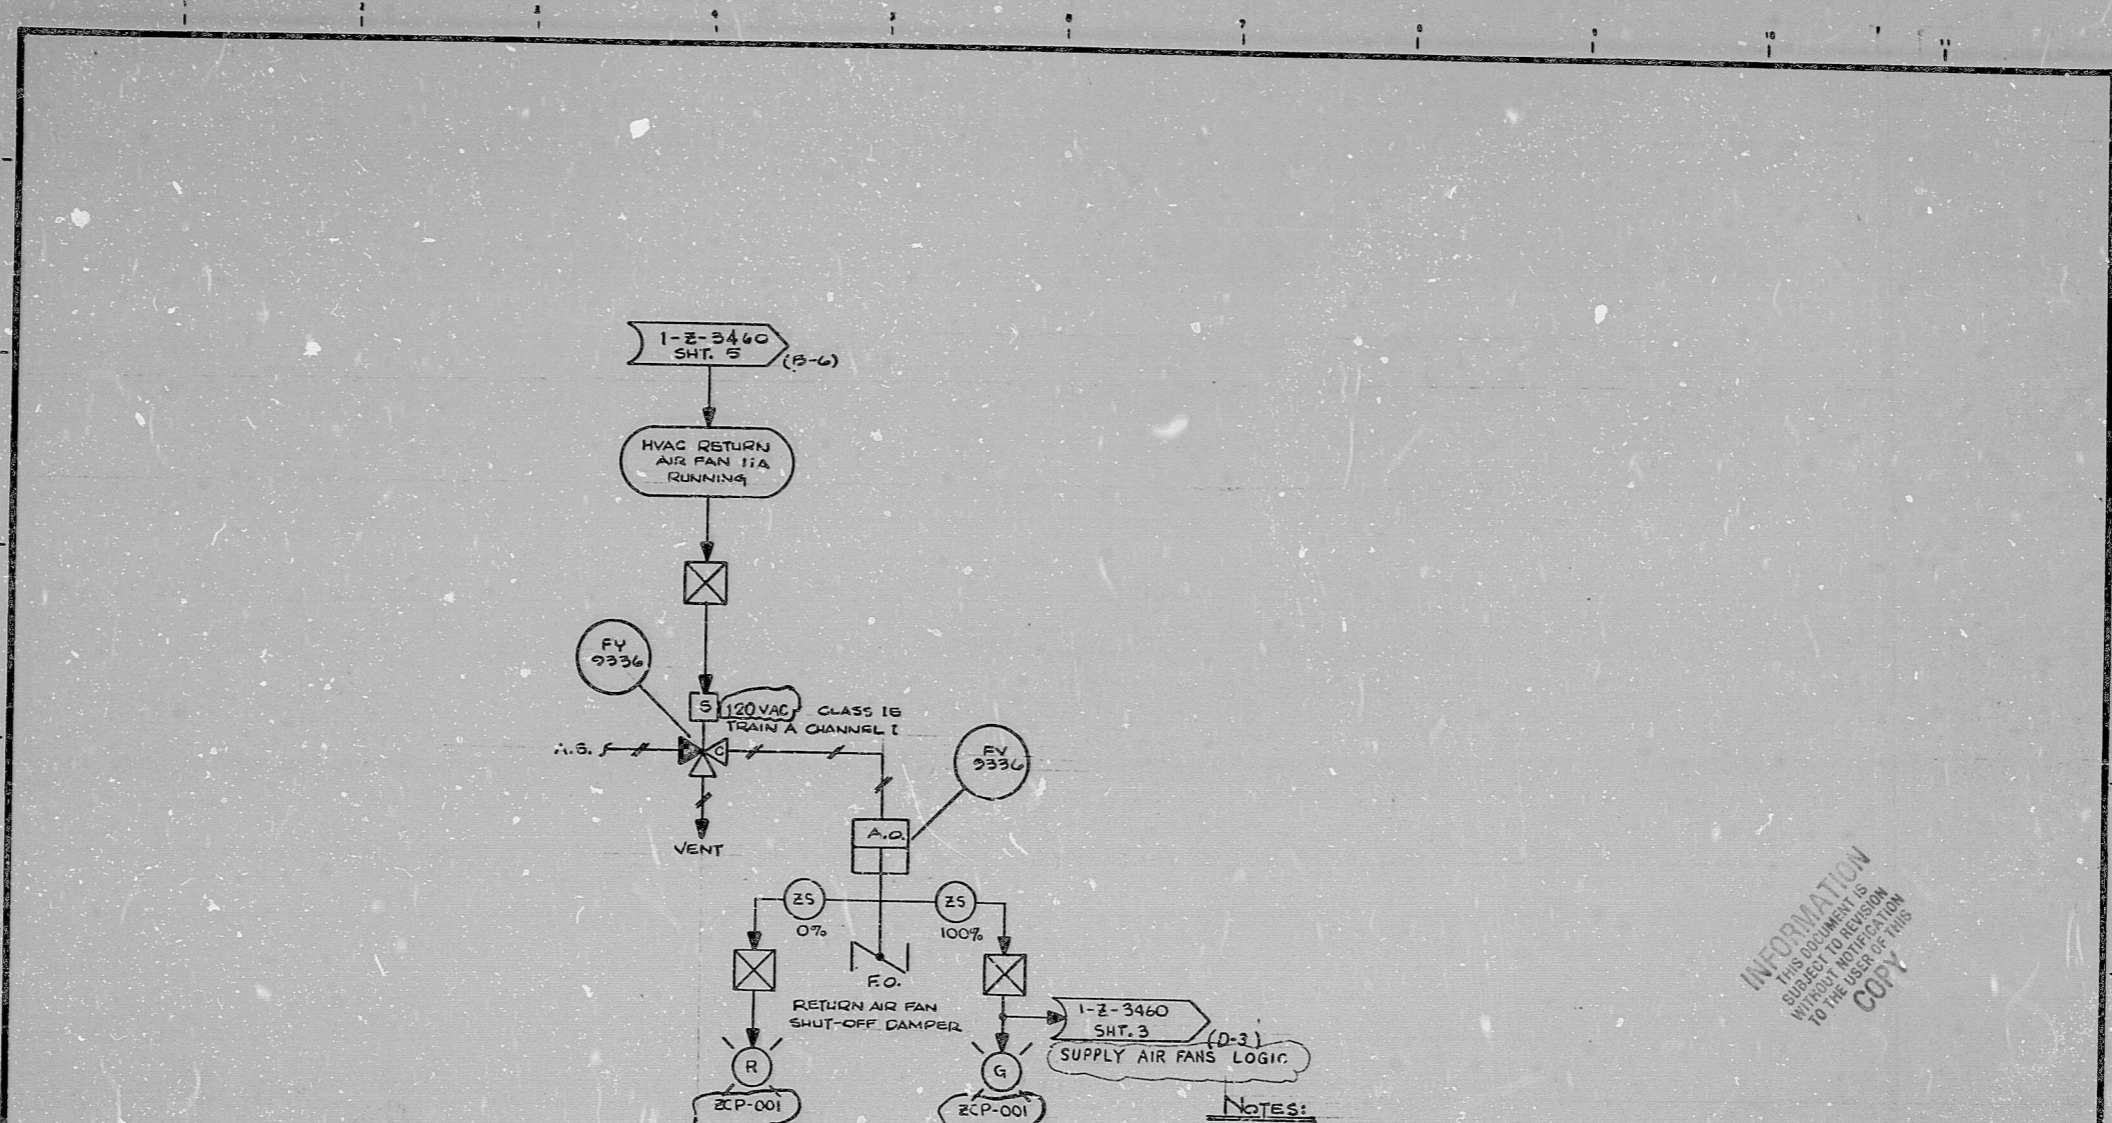

INFORMATION  
THIS DOCUMENT IS  
SUBJECT TO REVISION  
WITHOUT NOTIFICATION  
TO THE BEST OF THIS  
COPY

**NOTES:**

1. THIS LOGIC IS APPLICABLE TO THE FOLLOWING:

SERVICE	DAMPER NO.	SOLENOID VALVE	ELECTRICAL REF. Dwg. NO.	TRAIN
HVAC RETURN AIR FAN IIA SHUT-OFF DAMPER	FV-9336	FV-9334	E-7427, SH.1	A
HVAC RETURN AIR FAN IIB SHUT-OFF DAMPER	FV-9342	FV-9342	E-7427, SH.2	B
HVAC RETURN AIR FAN IIC SHUT-OFF DAMPER	FV-9358	FV-9358	E-7427, SH.3	C

TERA  
APERTURE  
CARD


**GENERAL NOTE:**  
THIS DRAWING REPRESENTS FUNCTIONAL REQUIREMENTS ONLY. REFER TO ELECTRICAL REFERENCE DRAWING FOR HARDWARE IMPLEMENTATION.

DATE	DESCRIPTION	BY	CHK	PROJ. ENG.	PROJ. MGR.	DV.	NO. DATE	DESCRIPTION	BY	CHK	PROJ. ENG.	PROJ. MGR.
D 8/79	REVISED AS NOTED, ISSUED FOR USE	HS										
C 7/77	ISSUED FOR USE											
B 6/77	REVISED FAN NO. & ELECTRICAL REVISED											
A 1/76	INITIAL REVIEW											

**Brown & Root, Inc.**  
ENGINEERS-CONSTRUCTORS  
HOUSTON, TEXAS

**SOUTH TEXAS PROJECT**

PKG. NO. 133 AREA 102  
DRAWING TITLE  
ELEC. AUX. BLDG. & CONT. RM  
RETURN AIR DAMPERS  
LOGIC DIAGRAM  
SYSTEM-V-II  
SHT. 1  
CONTRACT NO. SCALE  
CR-0241 NA  
DRAWING NO. 4V-11  
1-2-3463 D  
PRELIMINARY REVIEW USE CONSTRUCTION

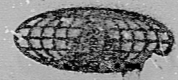

**BROWN & ROOT INC.**  
MICROFILM SERVICES



FRIDAY, OCT. 5 1979

RIDS

8112090552

