



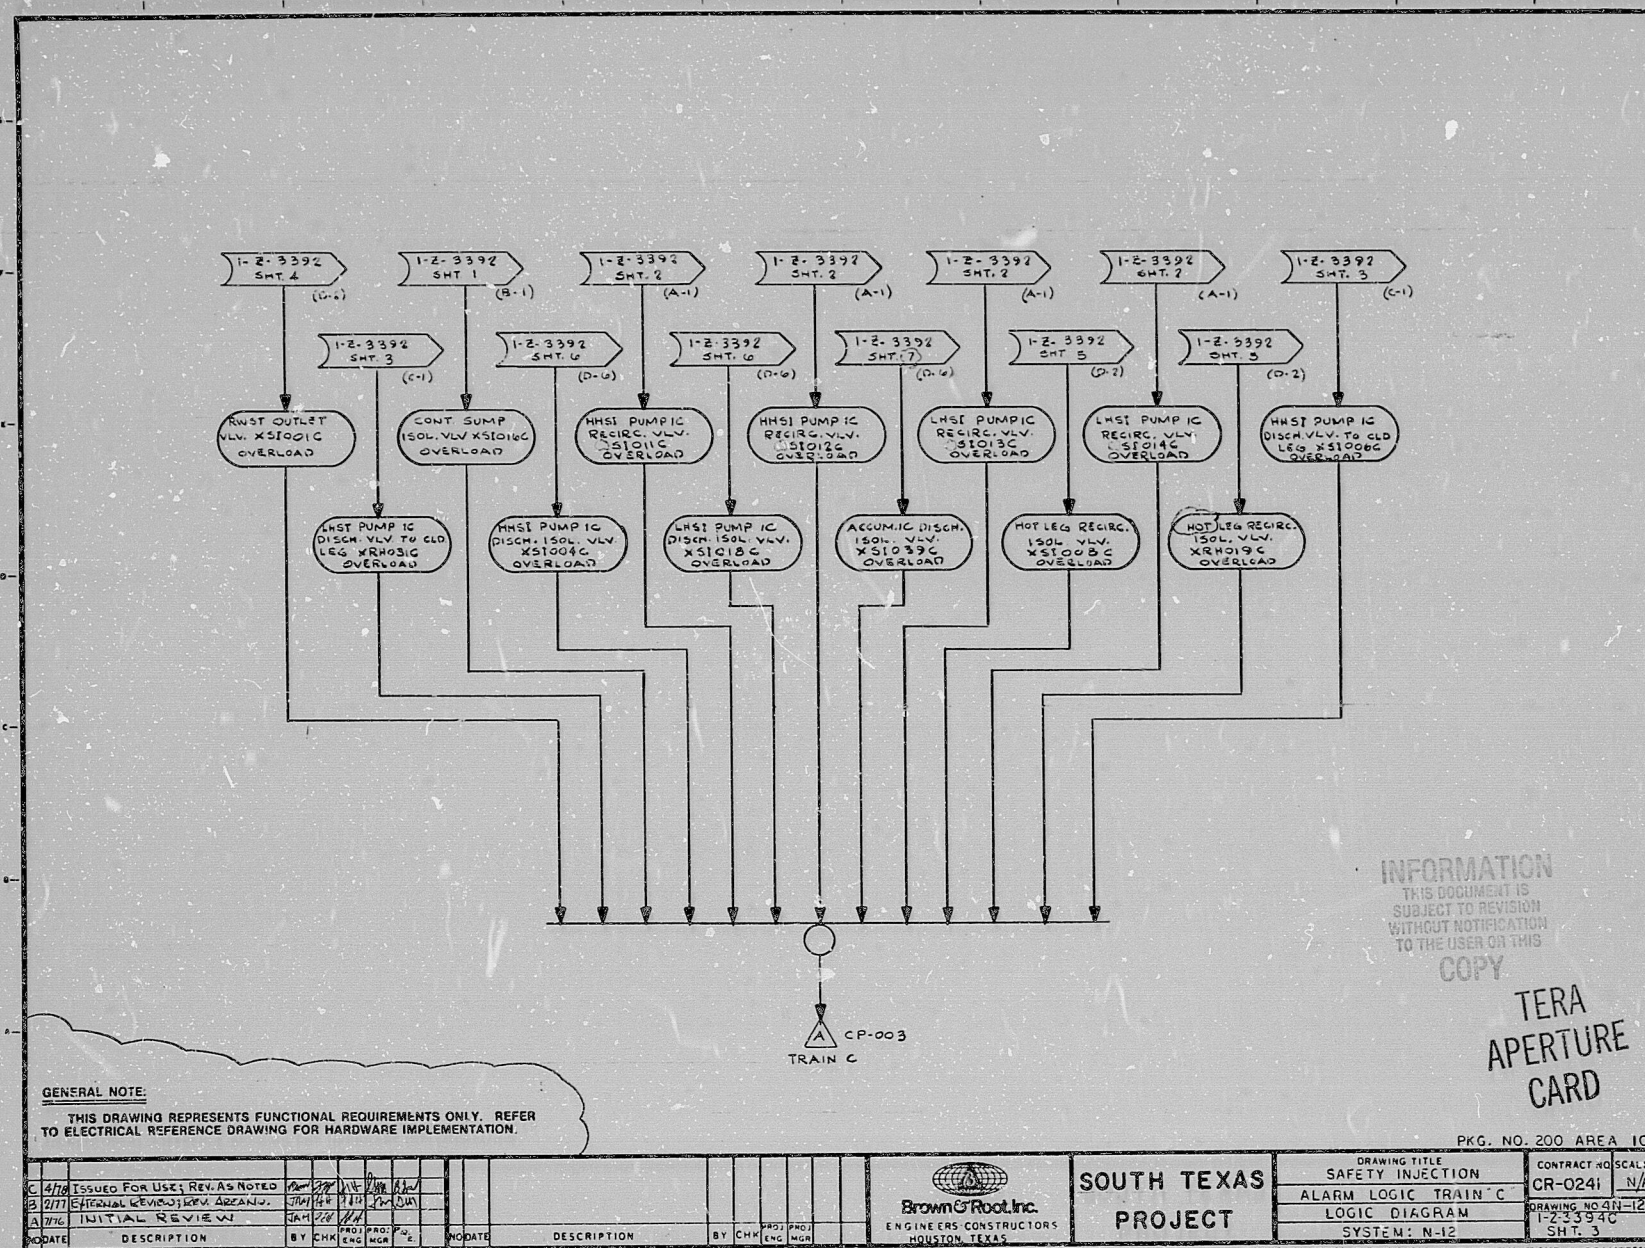

BROWN & ROOT INC.
MICROFILM SERVICES

WEDNESDAY, MAY 17 1978

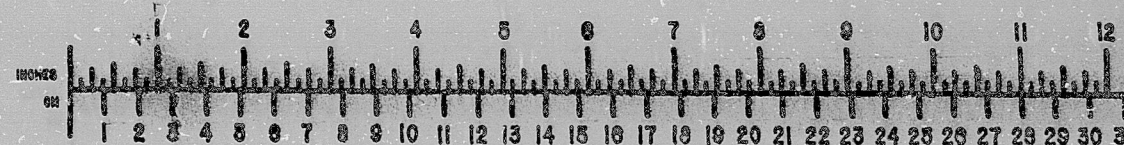

RIDS

8112090579

