


17"
11"
8.5"
8.5"
11"
17"

17"
11"
8.5"
8.5"
11"
17"

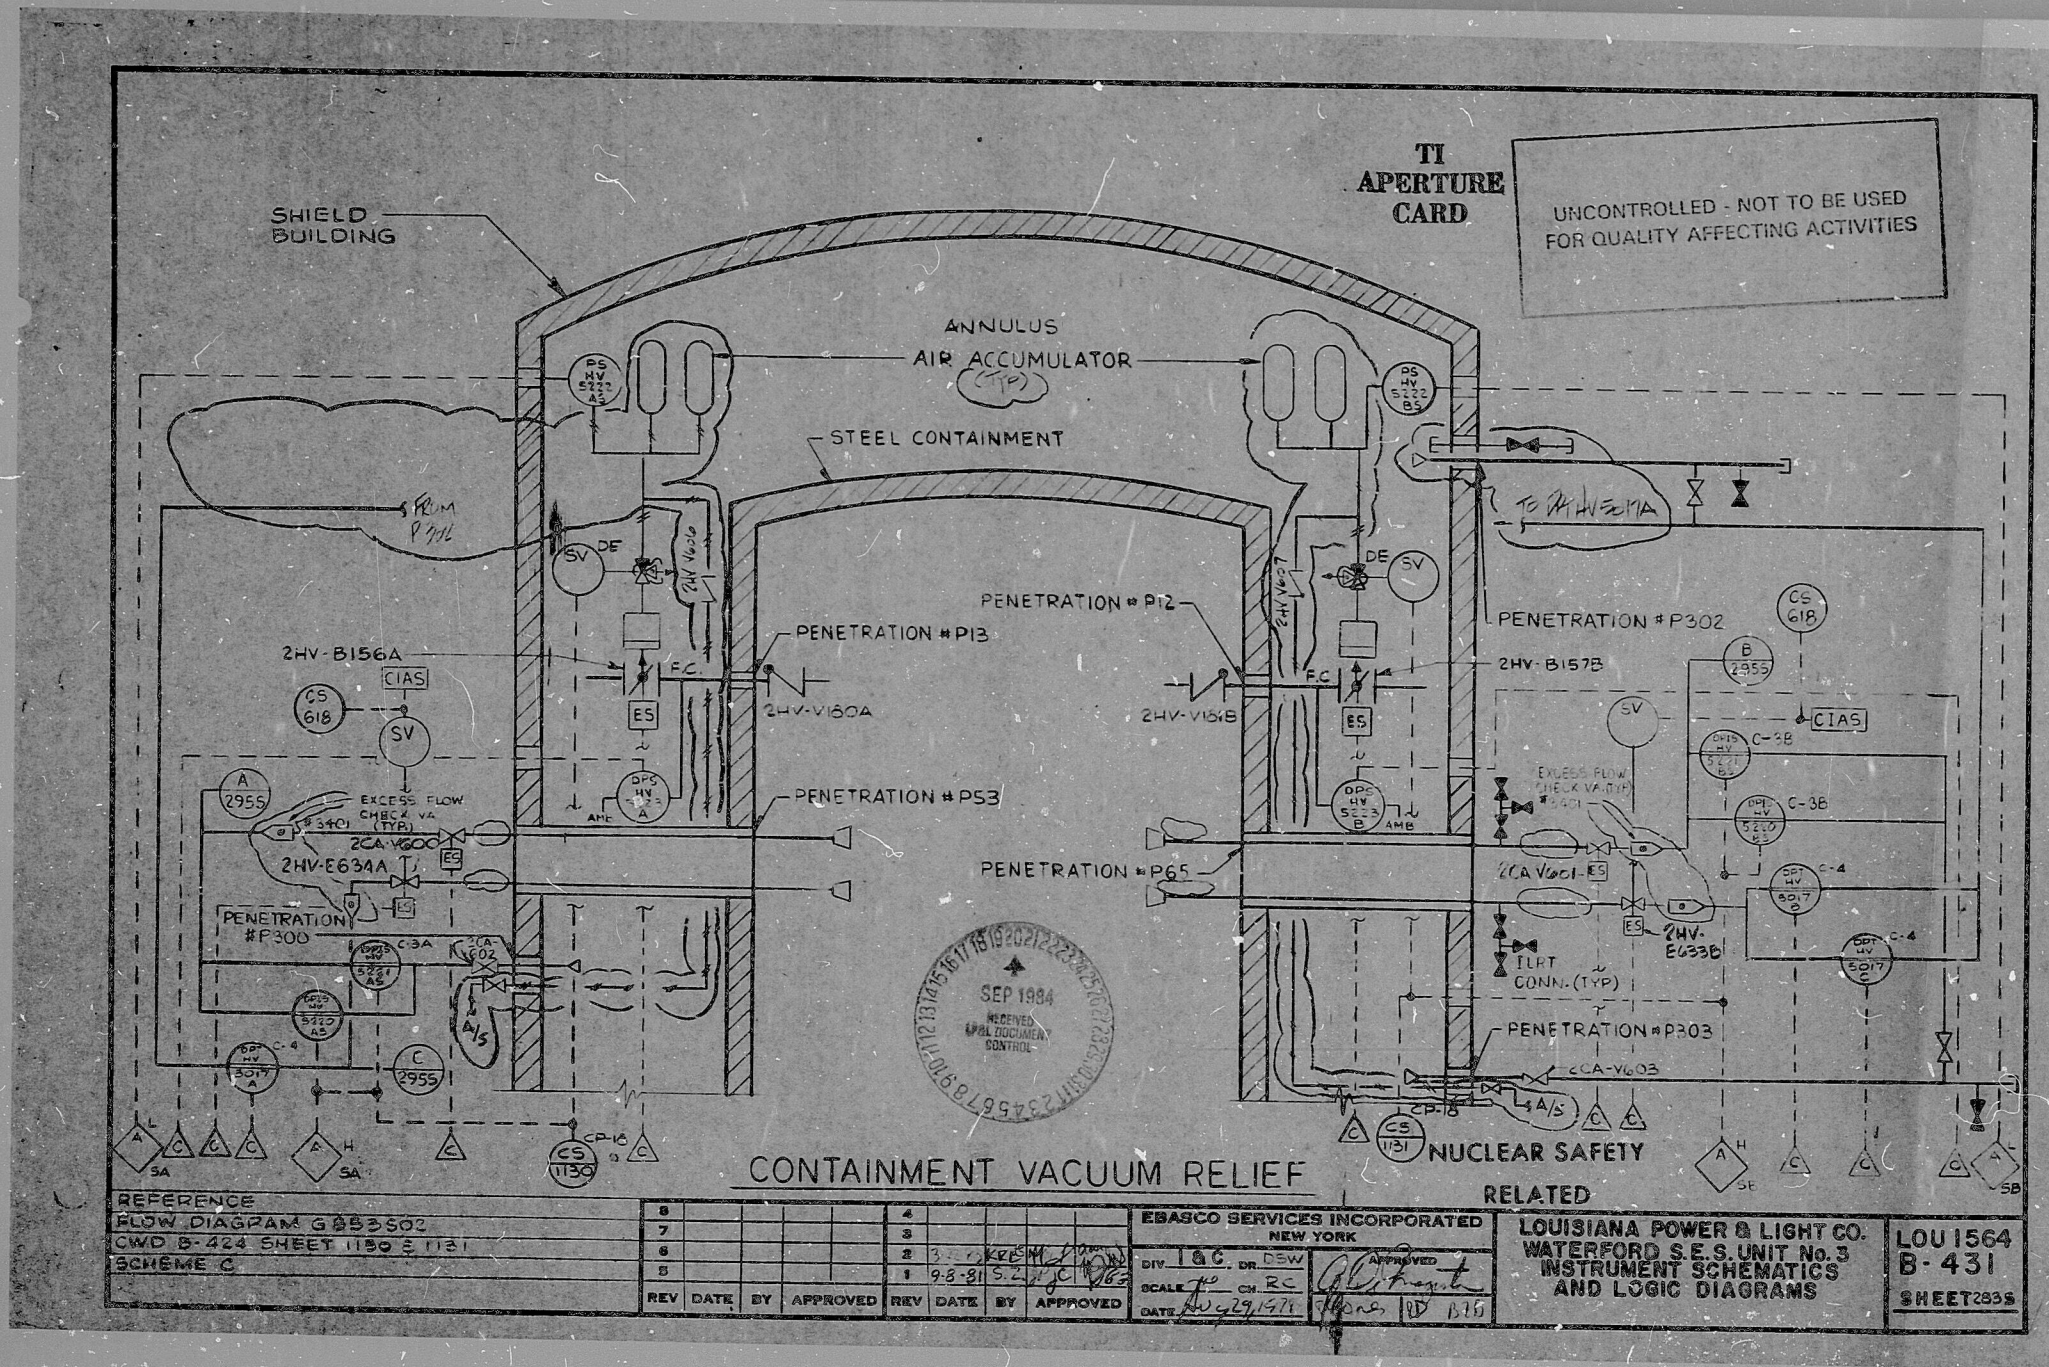

REFERENCE				EPRC DOCUMENT CONTROL				RECEIVED				SEP 1984			
FLOW DIAGRAM G053502				NEW YORK				SEP 1984				SEP 1984			
CWD B-424 SHEET 1130 S 1131				NEW YORK				SEP 1984				SEP 1984			
SCHEME C				NEW YORK				SEP 1984				SEP 1984			
REV	DATE	BY	APPROVED	REV	DATE	BY	APPROVED	REV	DATE	BY	APPROVED	REV	DATE	BY	APPROVED
1	9-8-81	S. J.	[Signature]	2	9-8-81	S. J.	[Signature]	3	9-8-81	S. J.	[Signature]	4	9-8-81	S. J.	[Signature]

LOUISIANA POWER & LIGHT CO.
WATERFORD S.E.S. UNIT No. 3
INSTRUMENT SCHEMATICS
AND LOGIC DIAGRAMS
LOU 1564
B-431
SHEET 2835

8410090191

PDR RIDS

