

17"

11"

8.5"

8.5"

11"

17"

17"


11"

8.5"

8.5"

11"

17"

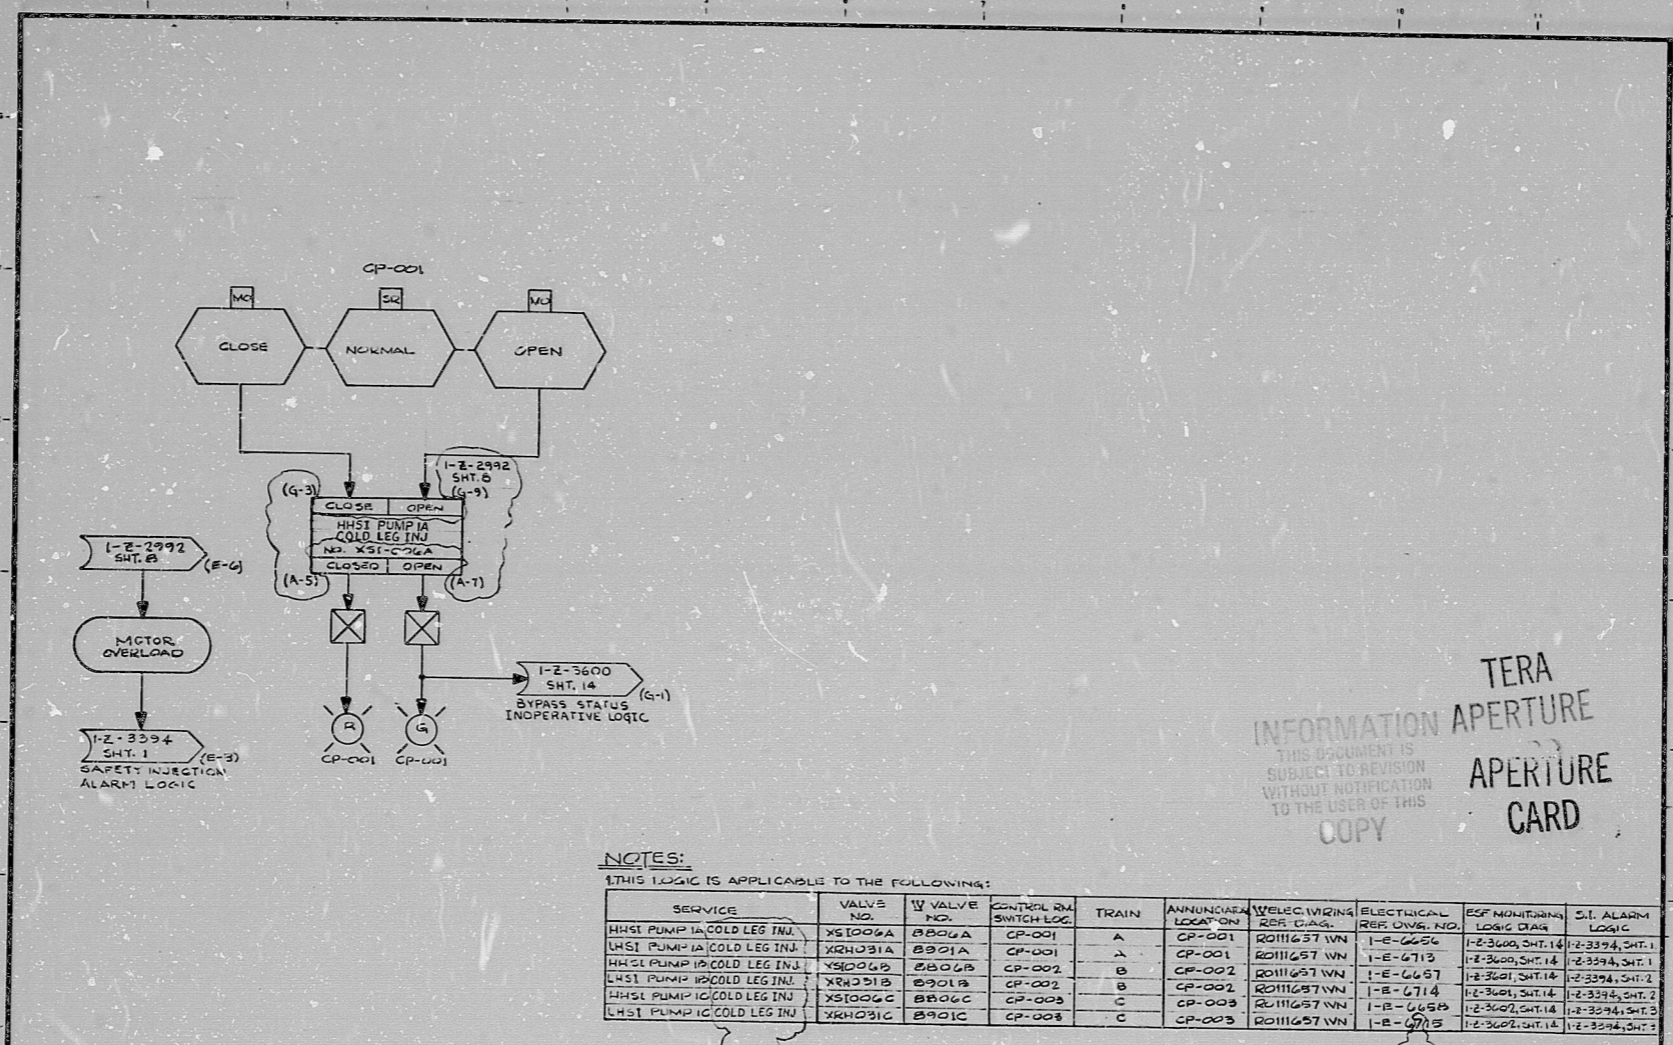

TERA
INFORMATION APERTURE
THIS DOCUMENT IS
SUBJECT TO REVISION
WITHOUT NOTIFICATION
TO THE USER OF THIS
COPY
APERTURE
CARD

NOTES:

THIS LOGIC IS APPLICABLE TO THE FOLLOWING:

SERVICE	VALVE NO.	W VALVE NO.	CONTROL RM SWITCH LOG.	TRAIN	ANNUNCIATOR LOCATION	WELC. I/V INJ. ROP. DIAG.	ELECTRICAL REF. DIAG. NO.	SCF MONITORING LOGIC DIAG.	S.I. ALARM LOGIC
HHST PUMP A COLD LEG INJ.	XS1009A	8804A	CP-001	A	CP-001	R011687 WN	I-E-6656	I-E-3600, SHT. 1A	I-E-3394, SHT. 1
HHST PUMP A COLD LEG INJ.	XS1009B	8804B	CP-001	A	CP-001	R011687 WN	I-E-6713	I-E-3600, SHT. 1A	I-E-3394, SHT. 1
HHST PUMP A COLD LEG INJ.	XS1009C	8804C	CP-002	B	CP-002	R011687 WN	I-E-6657	I-E-3600, SHT. 1A	I-E-3394, SHT. 2
HHST PUMP A COLD LEG INJ.	XS1009D	8804D	CP-002	B	CP-002	R011687 WN	I-E-6714	I-E-3600, SHT. 1A	I-E-3394, SHT. 2
HHST PUMP A COLD LEG INJ.	XS1009E	8804E	CP-003	C	CP-003	R011687 WN	I-E-6658	I-E-3600, SHT. 1A	I-E-3394, SHT. 3
HHST PUMP A COLD LEG INJ.	XS1009F	8804F	CP-003	C	CP-003	R011687 WN	I-E-6715	I-E-3600, SHT. 1A	I-E-3394, SHT. 3

GENERAL NOTE:
THIS DRAWING REPRESENTS FUNCTIONAL REQUIREMENTS ONLY. REFER TO ELECTRICAL REFERENCE DRAWING FOR HARDWARE IMPLEMENTATION.

DATE	DESCRIPTION	BY	CHK	PROG	END	NO.	DATE	DESCRIPTION	BY	CHK	PROG	END	NO.	DATE	DESCRIPTION



SOUTH TEXAS PROJECT


DRAWING TITLE
SIS
COLD LEG INJECTION
LOGIC DIAGRAM
SYSTEM: N-12

PKG. NO. 200 AREA 102

CONTRACT NO. SCALE
CR-0241 N.A.
DRAWING NO. N-12
I-Z-3392 C
SHT. 3

BROWN & ROOT INC.
MICROFILM SERVICES

WEDNESDAY, MAY 17 1978

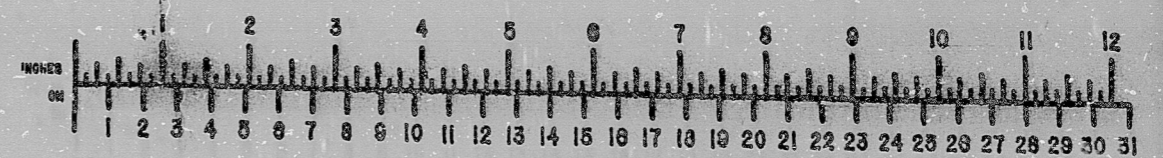

RIDS

8112090605

