


11
8.5"
8.5"
11"
17"

11
8.5"
8.5"
11"
17"

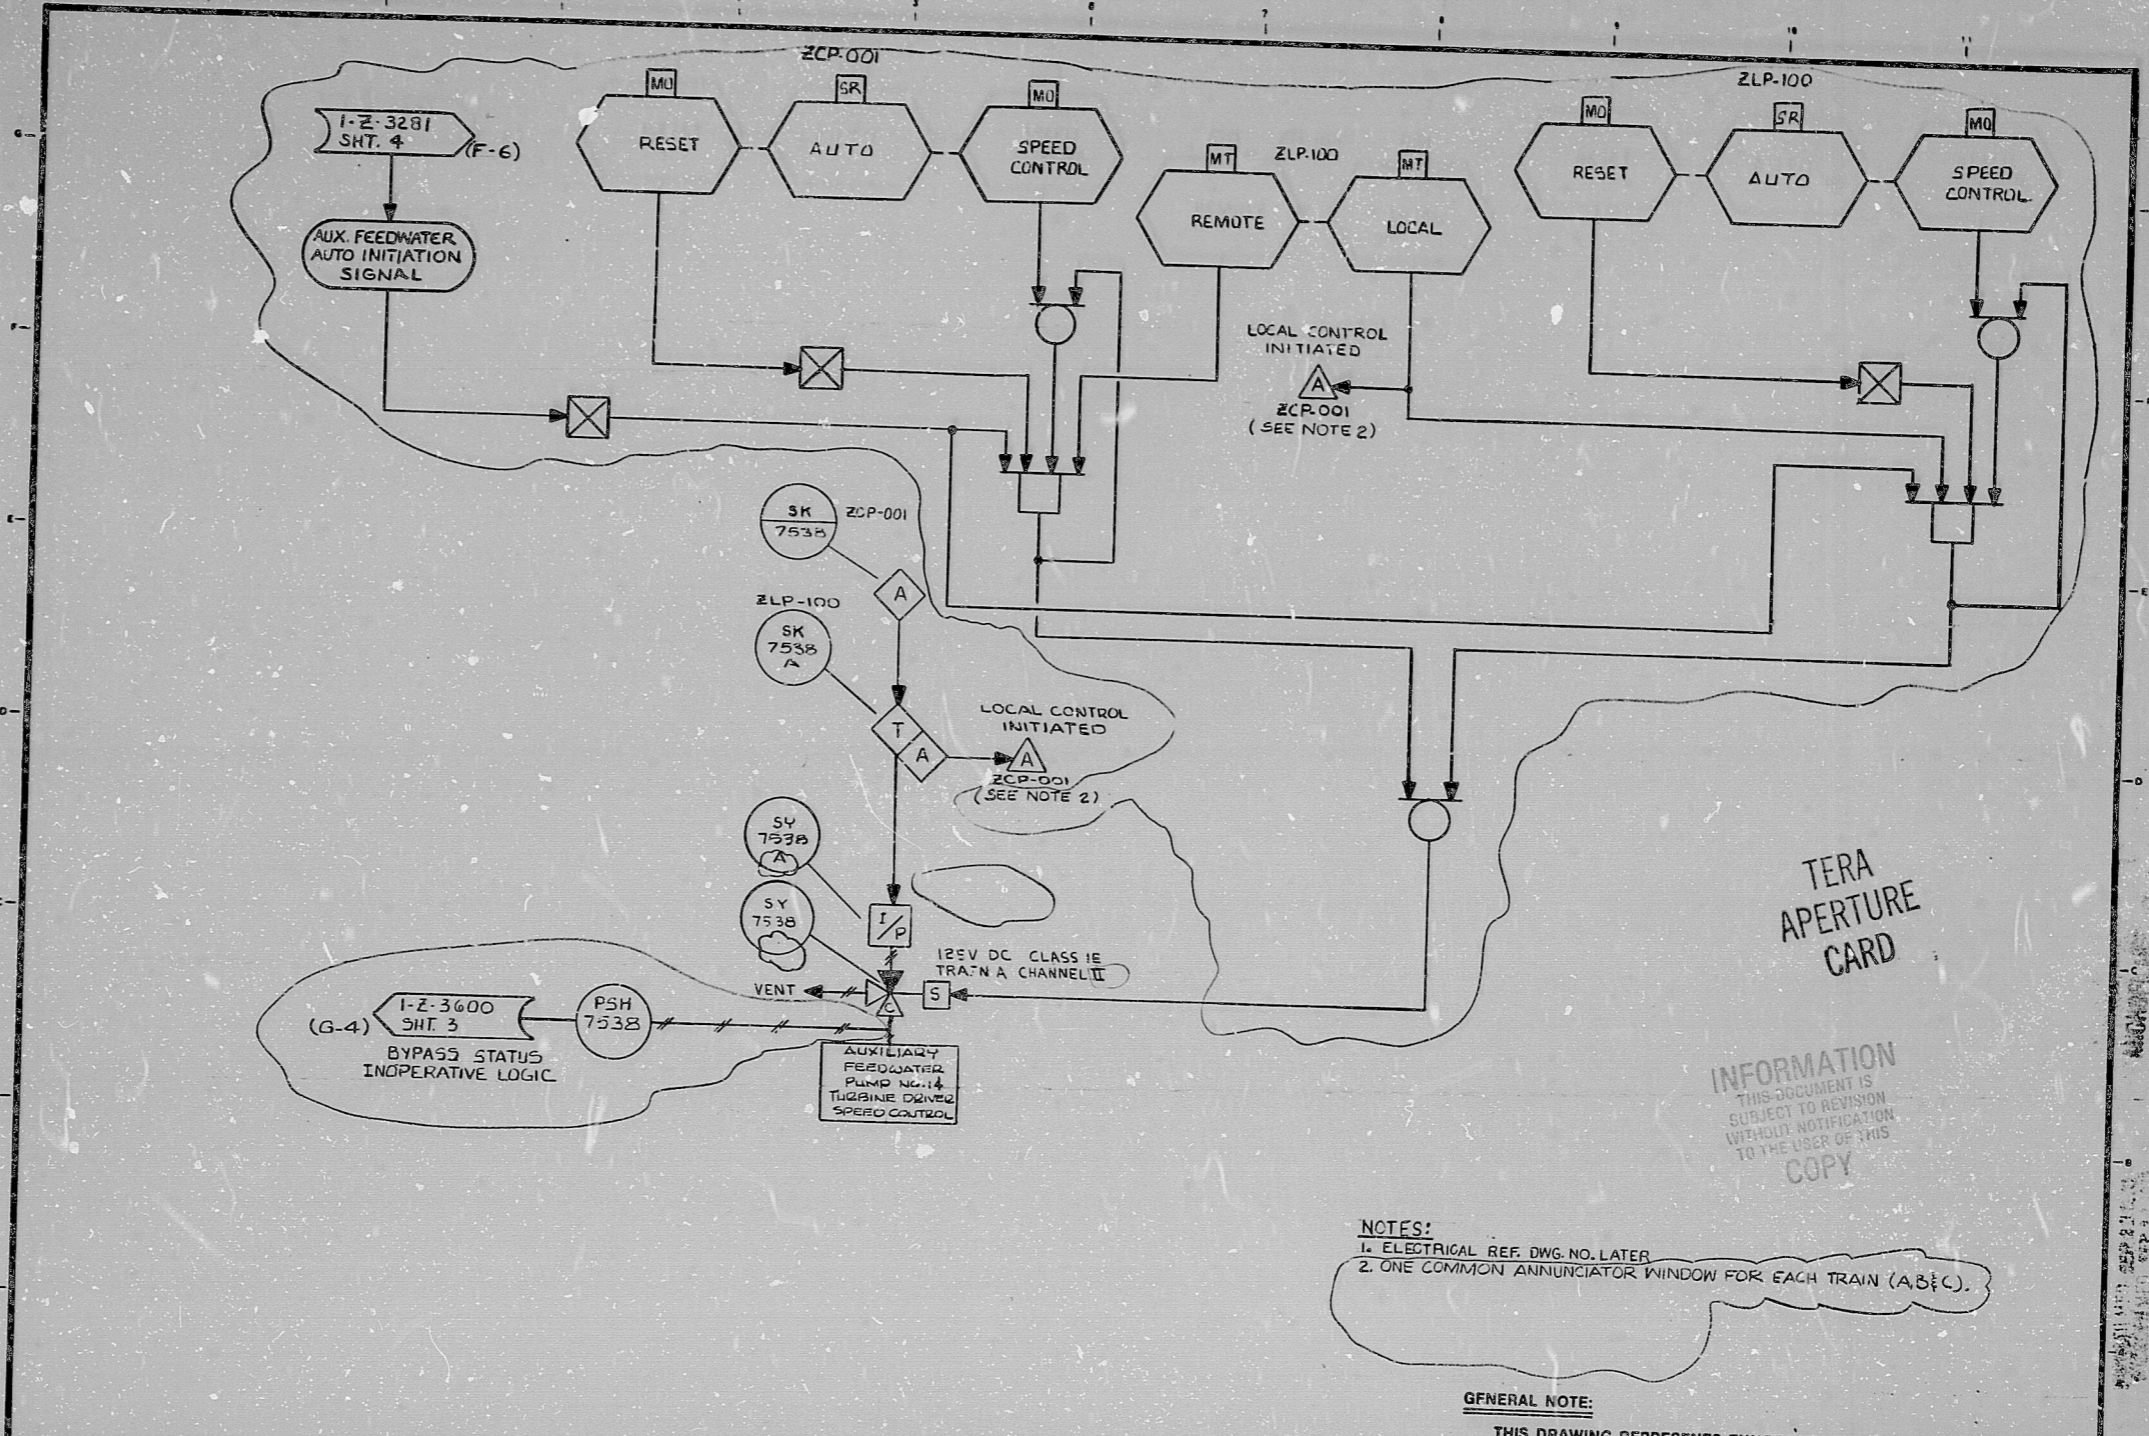

TERA APERTURE CARD
INFORMATION
THIS DOCUMENT IS SUBJECT TO REVISION WITHOUT NOTIFICATION TO THE USER OF THIS COPY

- NOTES:
1. ELECTRICAL REF. DWG. NO. LATER
2. ONE COMMON ANNUNCIATOR WINDOW FOR EACH TRAIN (A&C).

GENERAL NOTE:
THIS DRAWING REPRESENTS FUNCTIONAL REQUIREMENTS ONLY. REFER TO ELECTRICAL REFERENCE DRAWING FOR HARDWARE IMPLEMENTATION.

D 9/77 REVISED AS NOTED; ISSUED FOR USE C 8/78 REV. AS NOTED - ISSUED FOR USE B 7/77 REVISED AS NOTED A 6/77 ISSUE FOR USE				E 7/80 REVISED AS NOTED; ISSUED FOR USE				SOUTH TEXAS PROJECT				DRAWING TITLE AUX. FEEDWATER PUMP 14 TURBINE DRIVER SPEED CONTROL LOGIC DIAGRAM		PKG. NO. 095 AREA 102 CONTRACT NO. SCALE CR-0241 NA DRAWING NO. 35-14 I-Z-3284E SHT. 1	
NO. DATE	DESCRIPTION	BY	CHK	PROJ. ENG.	PROJ. MGR.	DES. ENG.	NO. DATE	DESCRIPTION	BY	CHK	PROJ. ENG.	PROJ. MGR.	DES. ENG.	NO. DATE	DESCRIPTION

Brown & Root Inc.
ENGINEERS-CONSTRUCTORS
HOUSTON, TEXAS

BROWN & ROOT INC.
MICROFILM SERVICES

FRIDAY, APR. 18 1980



RIDS

817090612

