


LOU-1564-G-172

NOTES

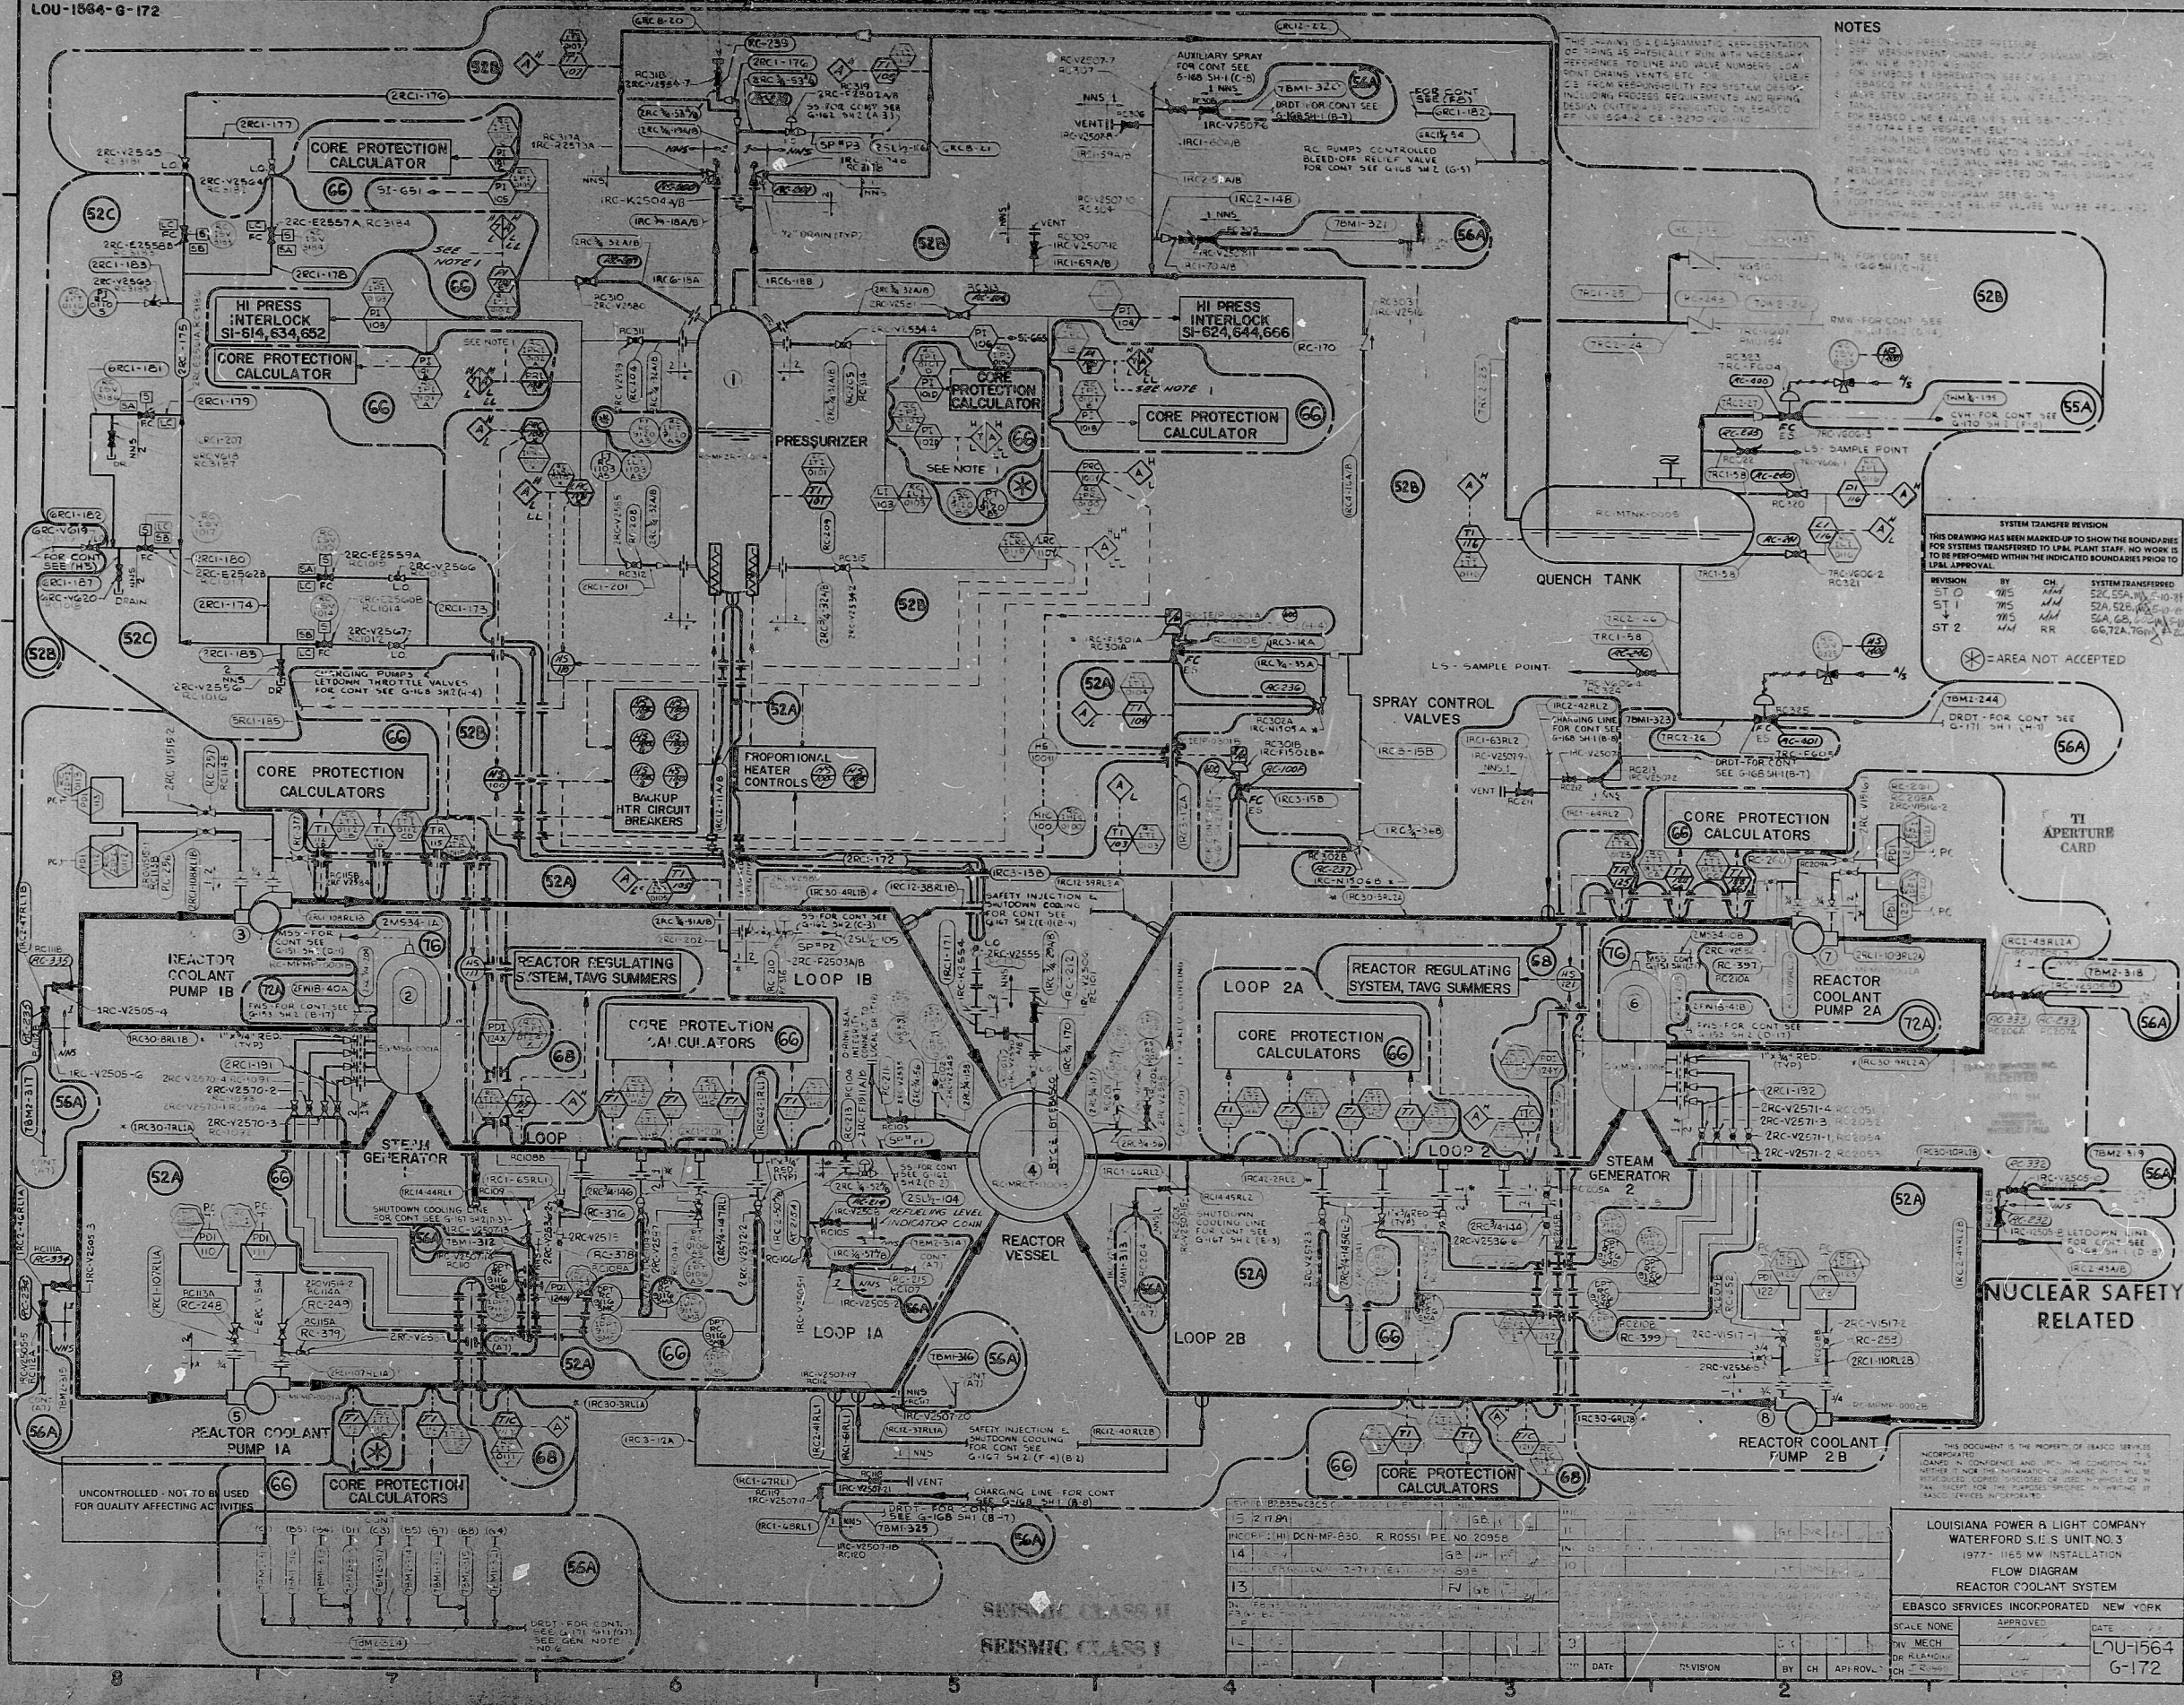

THE DRAWING IS A SCHEMATIC REPRESENTATION OF THE SYSTEM AS SHOWN. IT IS NOT TO BE USED FOR CONSTRUCTION OR AS A BASIS FOR DESIGN. THE DRAWING IS THE PROPERTY OF EBARCO SERVICES INCORPORATED. IT IS TO BE KEPT IN CONFIDENCE AND NOT TO BE REPRODUCED OR DISCLOSED TO ANY OTHER PARTY WITHOUT THE WRITTEN PERMISSION OF EBARCO SERVICES INCORPORATED.

THIS DRAWING HAS BEEN MARKED UP TO SHOW THE BOUNDARIES FOR SYSTEMS TRANSFERRED TO LOCAL PLANT STAFF. NO WORK IS TO BE PERFORMED WITHIN THE INDICATED BOUNDARIES PRIOR TO LOCAL APPROVAL.

REVISION	BY	CH	SYSTEM TRANSFERRED
ST 0	MMS	MMS	52A, 52B, 55A, 55B, 56A, 56B, 56C, 56D, 56E, 56F, 56G, 56H, 56I, 56J, 56K, 56L, 56M, 56N, 56O, 56P, 56Q, 56R, 56S, 56T, 56U, 56V, 56W, 56X, 56Y, 56Z
ST 1	MMS	MMS	52A, 52B, 55A, 55B, 56A, 56B, 56C, 56D, 56E, 56F, 56G, 56H, 56I, 56J, 56K, 56L, 56M, 56N, 56O, 56P, 56Q, 56R, 56S, 56T, 56U, 56V, 56W, 56X, 56Y, 56Z
ST 2	MMS	RR	66, 72A, 72B, 72C, 72D, 72E, 72F, 72G, 72H, 72I, 72J, 72K, 72L, 72M, 72N, 72O, 72P, 72Q, 72R, 72S, 72T, 72U, 72V, 72W, 72X, 72Y, 72Z

SYSTEM TRANSFER REVISION
 THIS DRAWING HAS BEEN MARKED UP TO SHOW THE BOUNDARIES FOR SYSTEMS TRANSFERRED TO LOCAL PLANT STAFF. NO WORK IS TO BE PERFORMED WITHIN THE INDICATED BOUNDARIES PRIOR TO LOCAL APPROVAL.

REVISION BY CH SYSTEM TRANSFERRED
 ST 0 MMS MMS 52A, 52B, 55A, 55B, 56A, 56B, 56C, 56D, 56E, 56F, 56G, 56H, 56I, 56J, 56K, 56L, 56M, 56N, 56O, 56P, 56Q, 56R, 56S, 56T, 56U, 56V, 56W, 56X, 56Y, 56Z
 ST 1 MMS MMS 52A, 52B, 55A, 55B, 56A, 56B, 56C, 56D, 56E, 56F, 56G, 56H, 56I, 56J, 56K, 56L, 56M, 56N, 56O, 56P, 56Q, 56R, 56S, 56T, 56U, 56V, 56W, 56X, 56Y, 56Z
 ST 2 MMS RR 66, 72A, 72B, 72C, 72D, 72E, 72F, 72G, 72H, 72I, 72J, 72K, 72L, 72M, 72N, 72O, 72P, 72Q, 72R, 72S, 72T, 72U, 72V, 72W, 72X, 72Y, 72Z

UNCONTROLLED - NOT TO BE USED FOR QUALITY AFFECTING ACTIVITIES

THIS DOCUMENT IS THE PROPERTY OF EBARCO SERVICES INCORPORATED. IT IS TO BE KEPT IN CONFIDENCE AND NOT TO BE REPRODUCED OR DISCLOSED TO ANY OTHER PARTY WITHOUT THE WRITTEN PERMISSION OF EBARCO SERVICES INCORPORATED.

LOUISIANA POWER & LIGHT COMPANY WATERFORD S.I. S UNIT NO. 3 1977 - 1165 MW INSTALLATION FLOW DIAGRAM REACTOR COOLANT SYSTEM			
SCALE NONE	APPROVED	DATE	
BY MECH			LOU-1564
DR RELEASED			G-172
BY CH	APPROV.	CH	

22"

17"

11"

9.5"

8.5"

11"

17"

22"

22"

17"

11"

9.5"

8.5"

11"

17"

22"

34"

8410090252

PDR RIDS

