

11

11

8.5

8.5

11

17

11


11

8.5

8.5

11

17

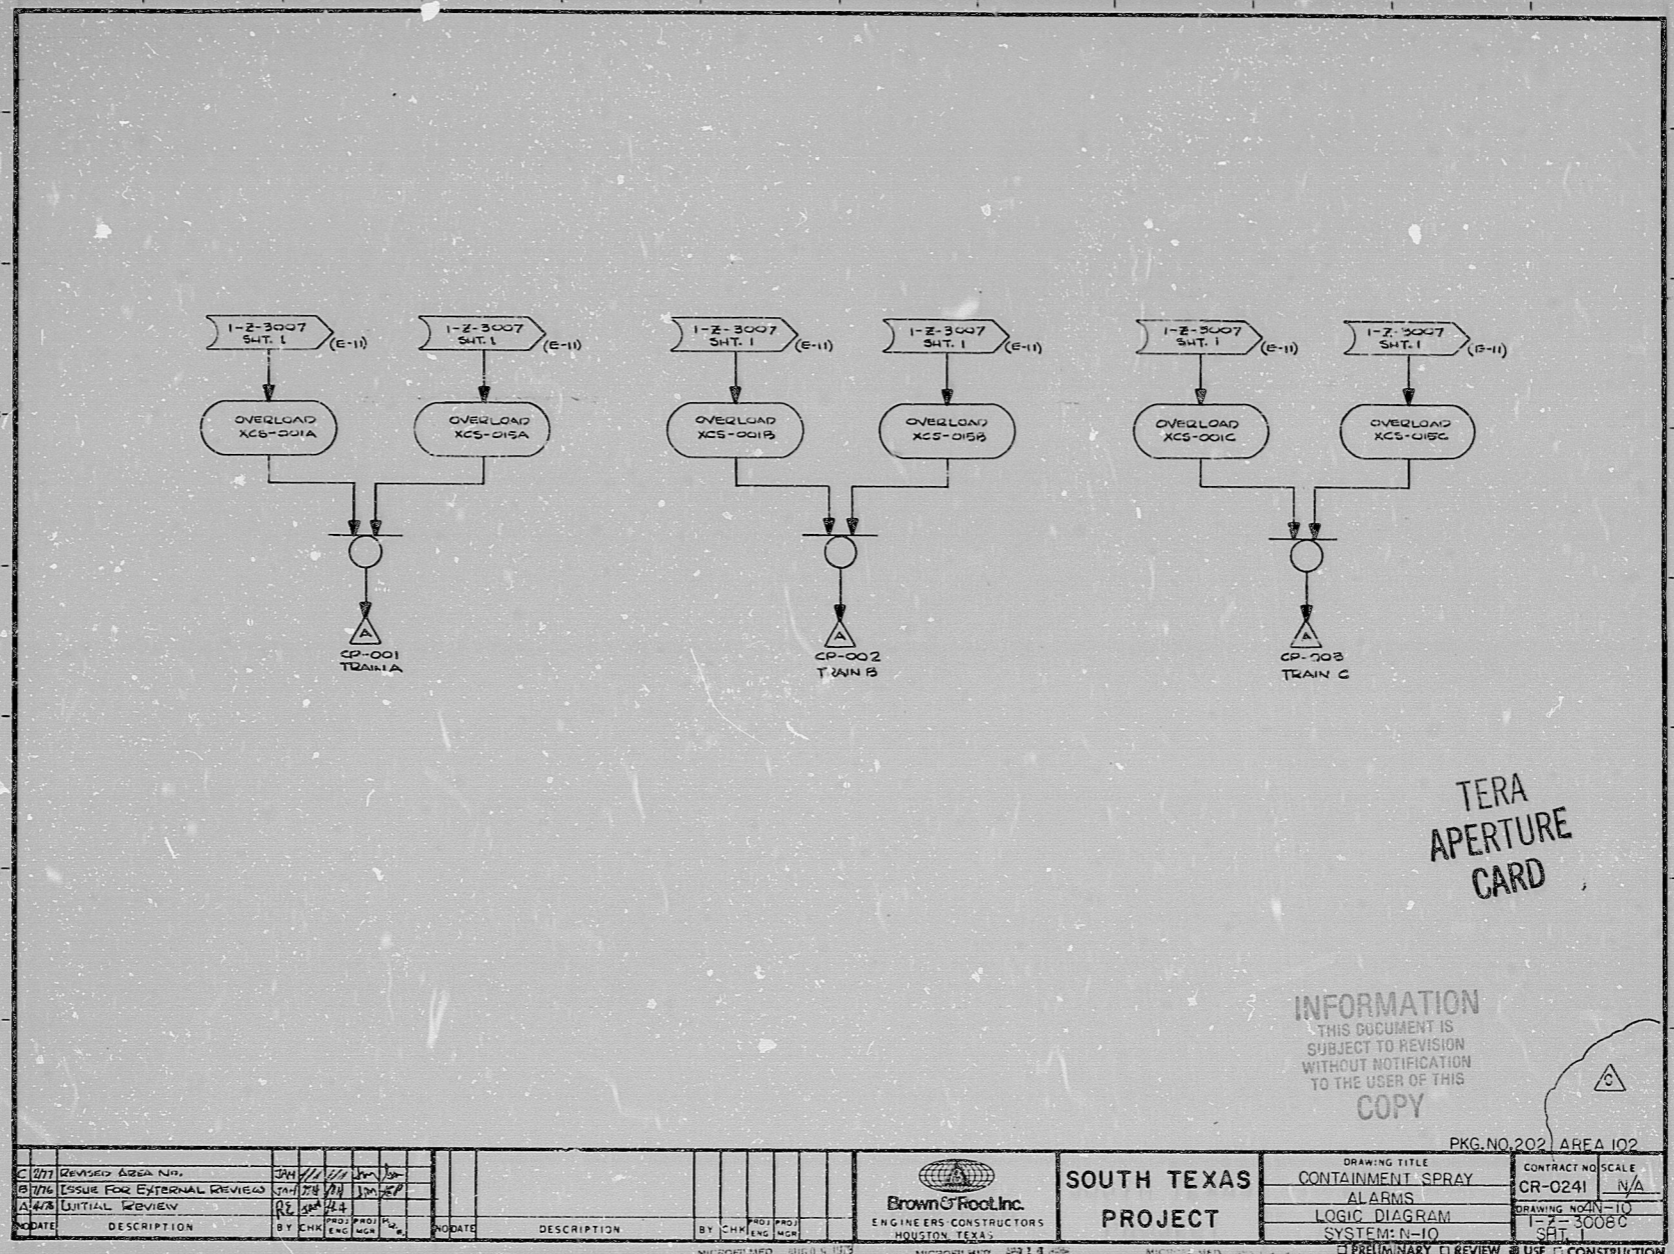

BROWN & ROOT INC.  
MICROFILM SERVICES

THURSDAY, MAR. 3 1977



RIDS

8112100151

